


N^{OS} 372-3.

SCALE $\frac{1}{2}'' = 1$ FOOT.

DECK PLATED IN WAY OF E & P CASING.

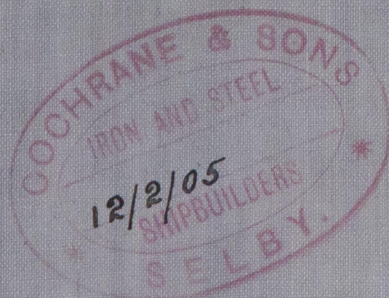


5079 · 3151. 2ND N°

BREADTH	TO	LENGTH	5.4.
DEPTH	TO	"	9.3

	1 ST POWER	5 ^L	CWTS	EX	STOCK.
2 ND	"	4 $\frac{3}{4}$	"	"	"
3 RD	"	2 $\frac{1}{2}$	"	"	"
90 FATHOMS		1"	SHORT LINK CABLE.		
60 "		2"	HAWSER.		
60 "		4 $\frac{1}{2}$ "	WARP		

RAISED QUARTER DECK 78'-9" x 12".
" FORECASTLE " 20'-3" x 12".

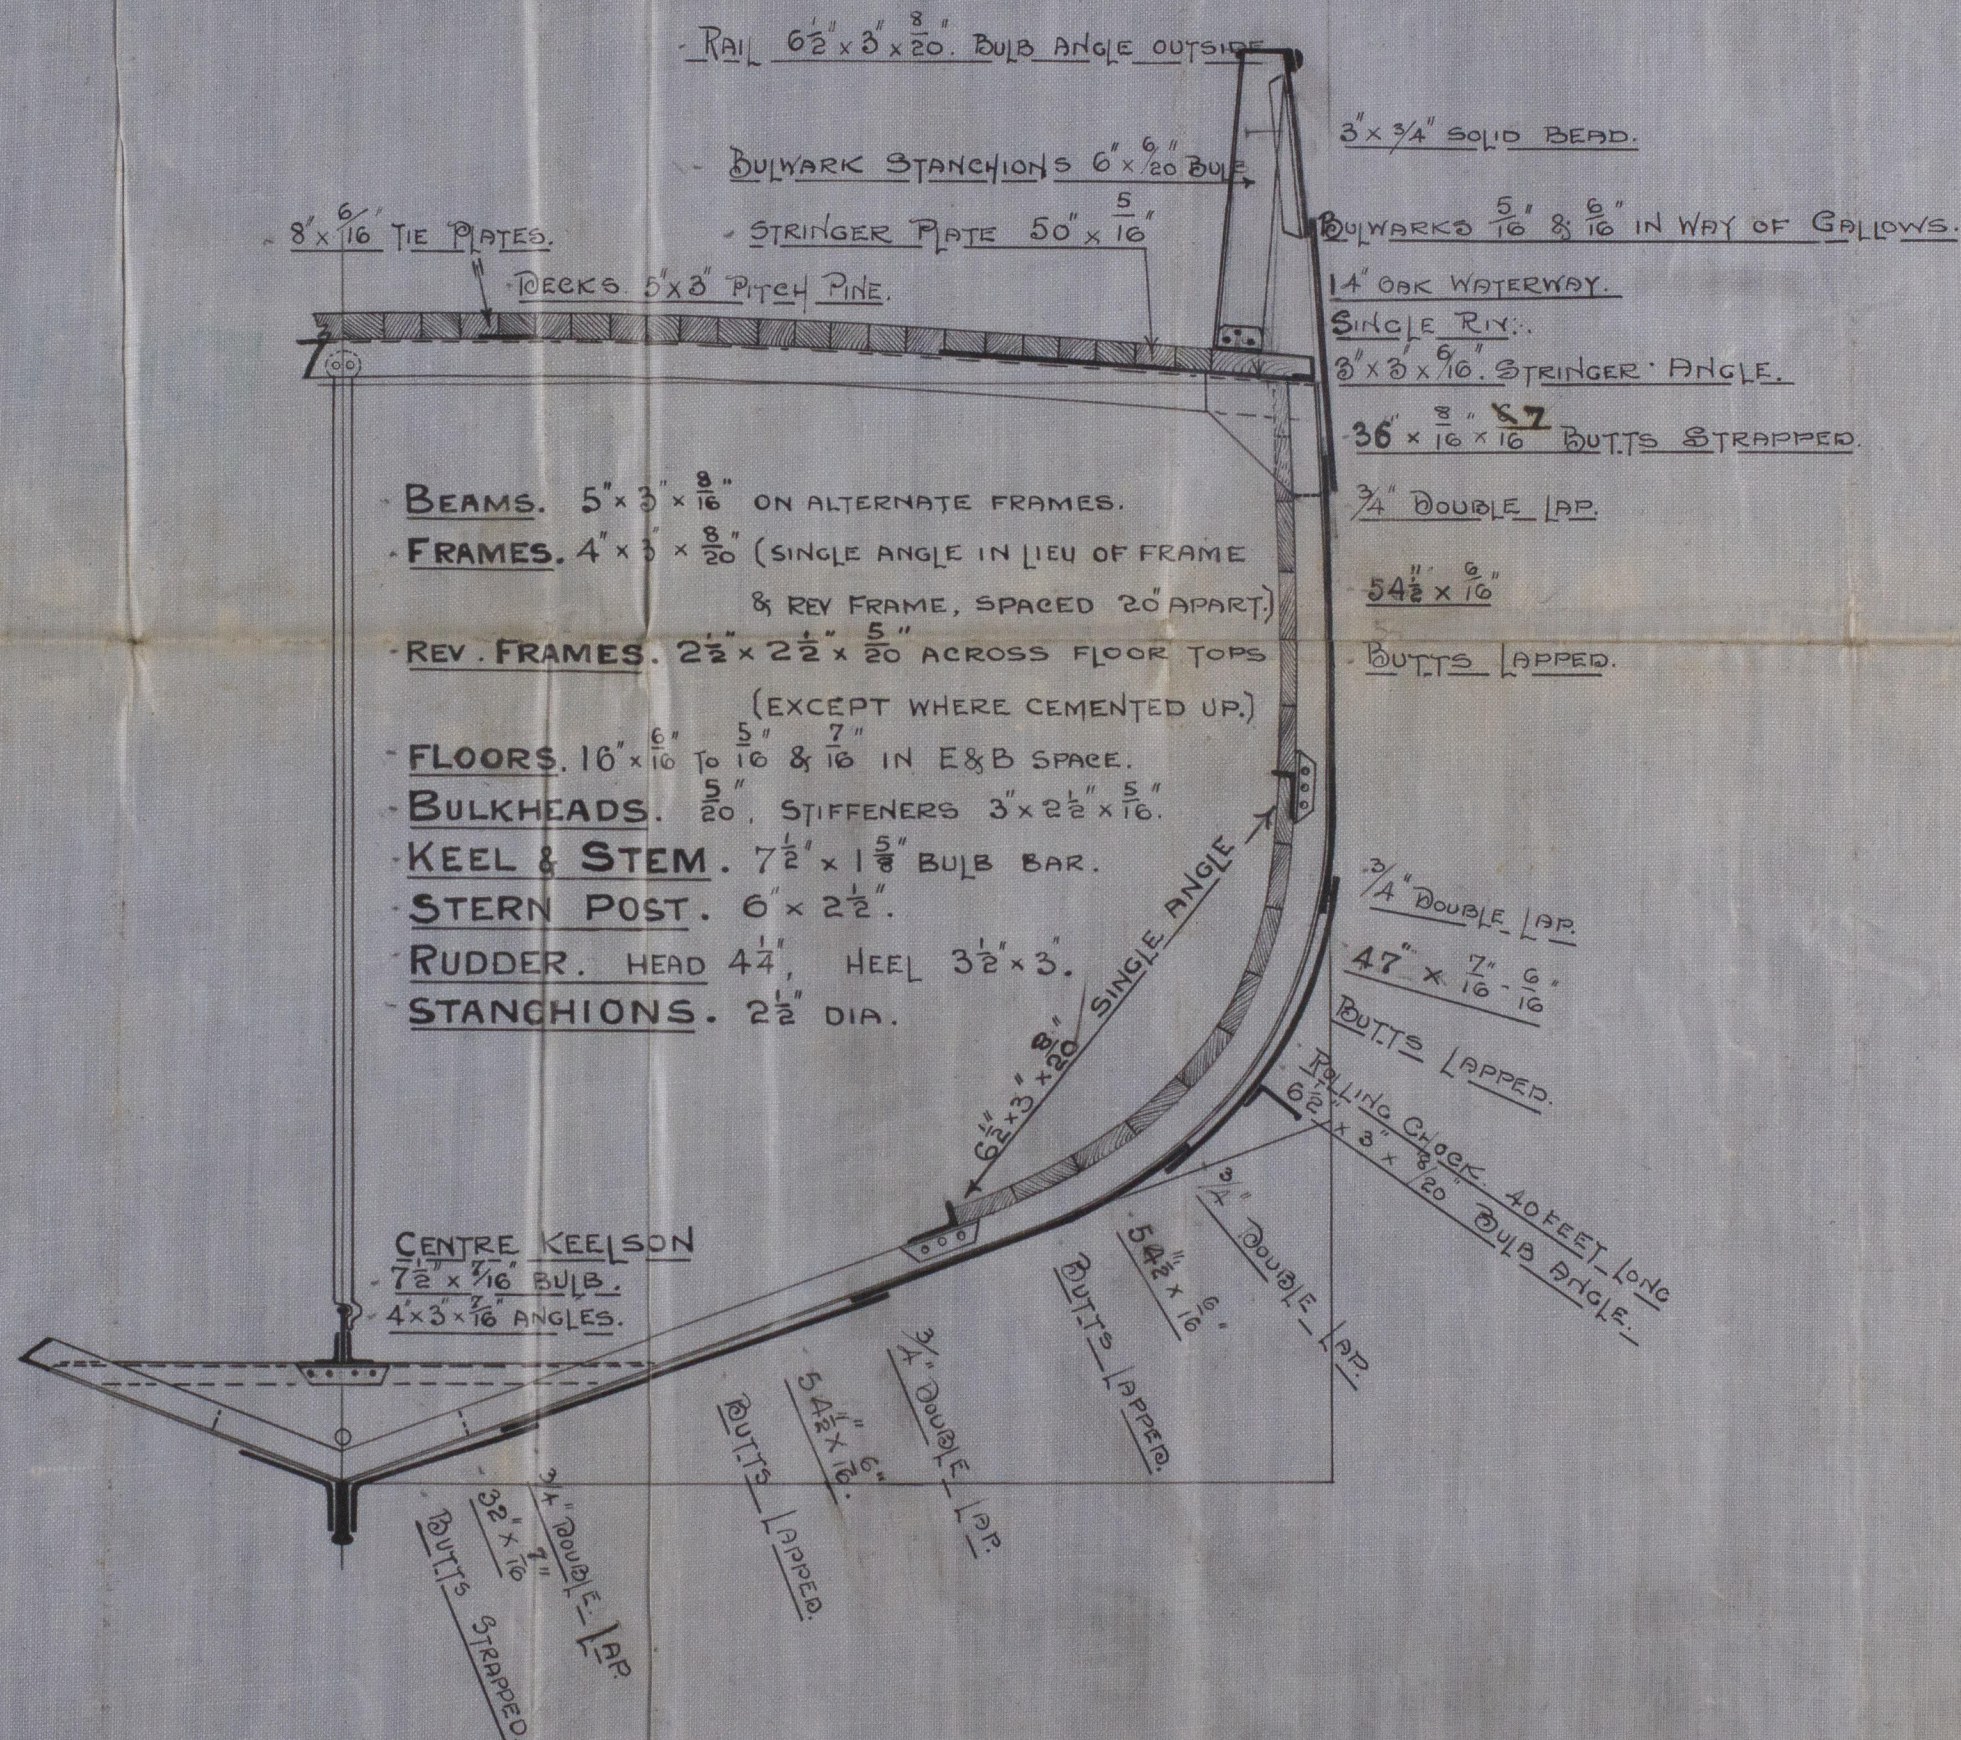

13-2-06

14/2/06

Cochran & Sons
Nos 342 and 343.
Midship Section.

s/s Hector Hull Rph No
s/s Hercules . . .

RETAIN

W574-0099

Midship Section 342+3.

Midship Section 342+3.



© 2020

Lloyd's Register
Foundation