

14.2.06

PROFILE & DECK PLAN.

STEEL SCREW TRAWLERS.


S.S. No 372-3

DIM: 120'-0" x 22'-0" x 11'-6" DEPTH OF HOLD x 12'-3" MOULDER.



SCALE 1/4" = 1 FOOT

1ST No 42-73.

2ND No 5070-81.

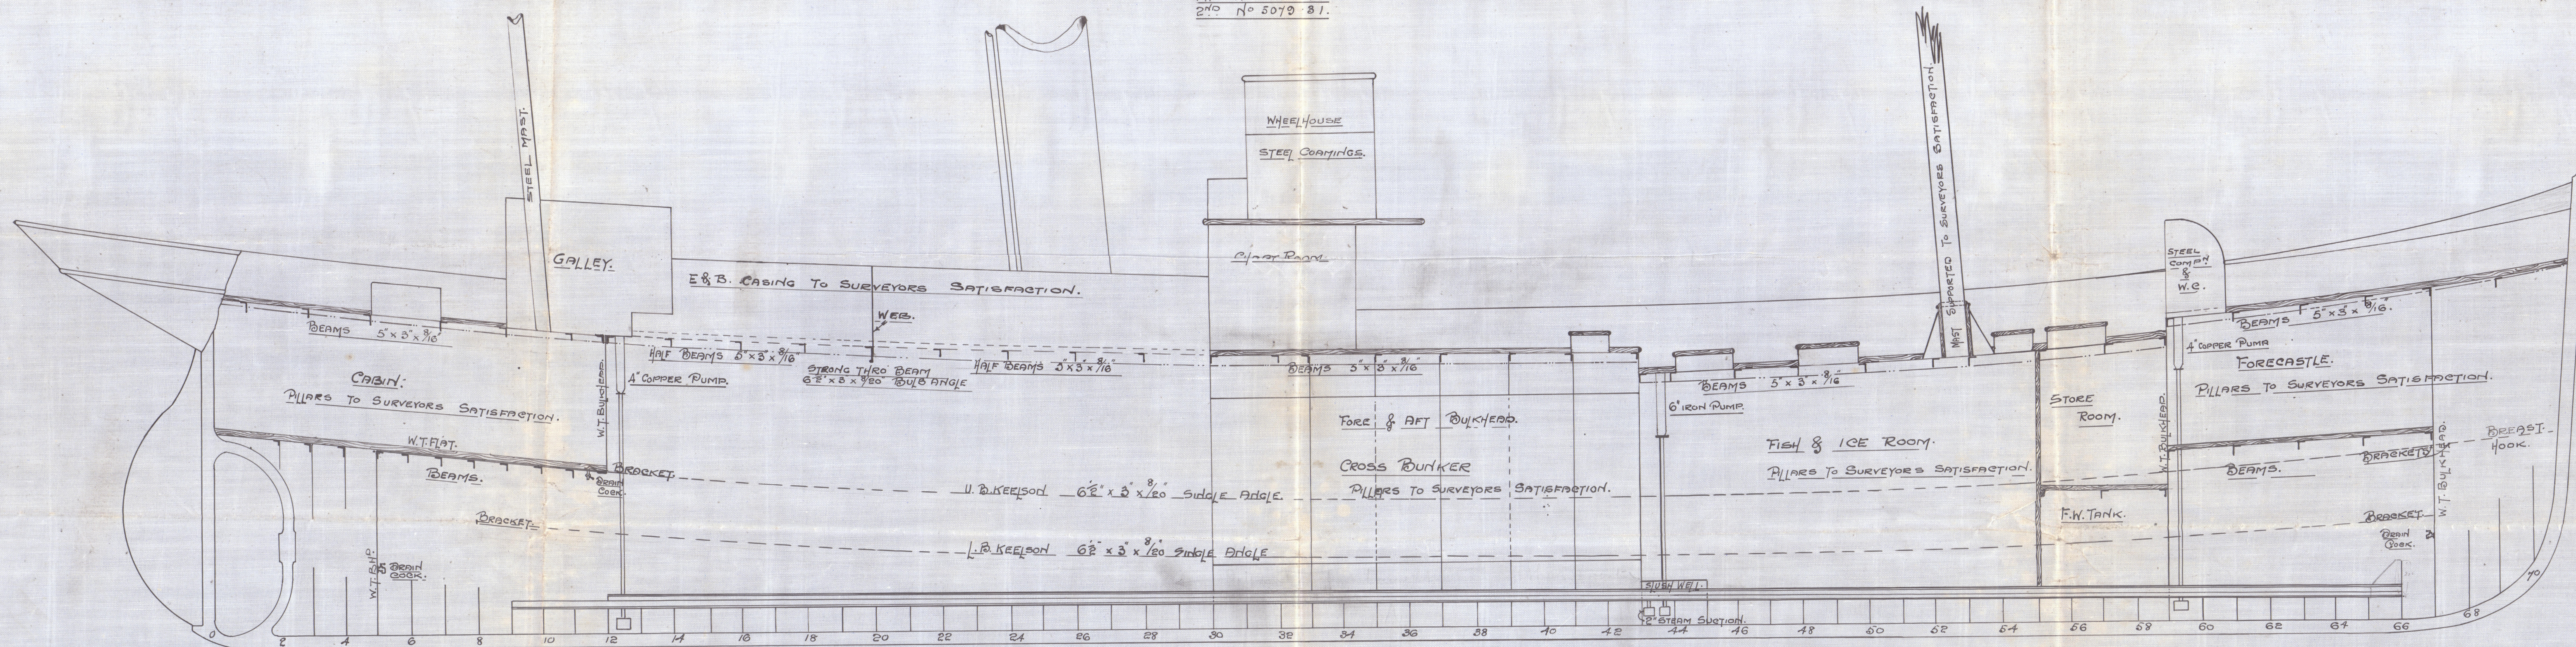

Complete proposal for Pumping Arrangements
to be separately submitted.

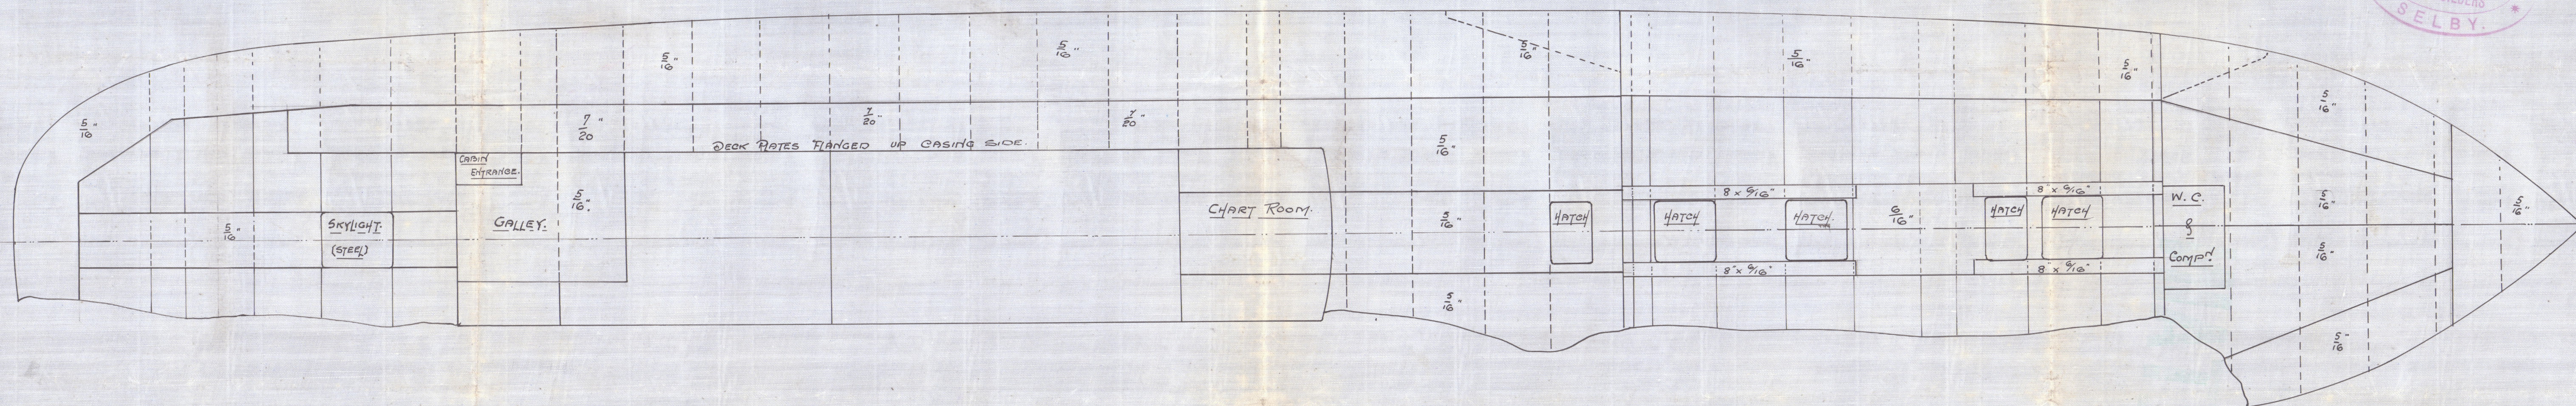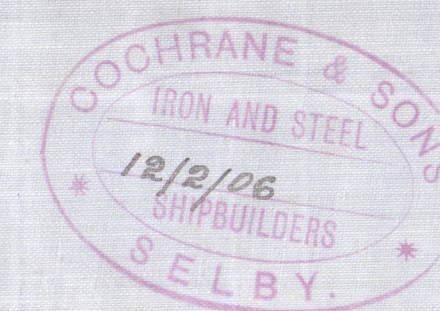

made to order
14/2/06
14/2/06
14/2/06

14/2/06

Cochrane & Sons.
Nos 342 and 343.

Profile + Deck Plan.



of Hector Hull Rpt No. 18118

of Hercules " " 18119

Profile & Deck Plan 3 1/2 x 8

RETAIN

W874-0100

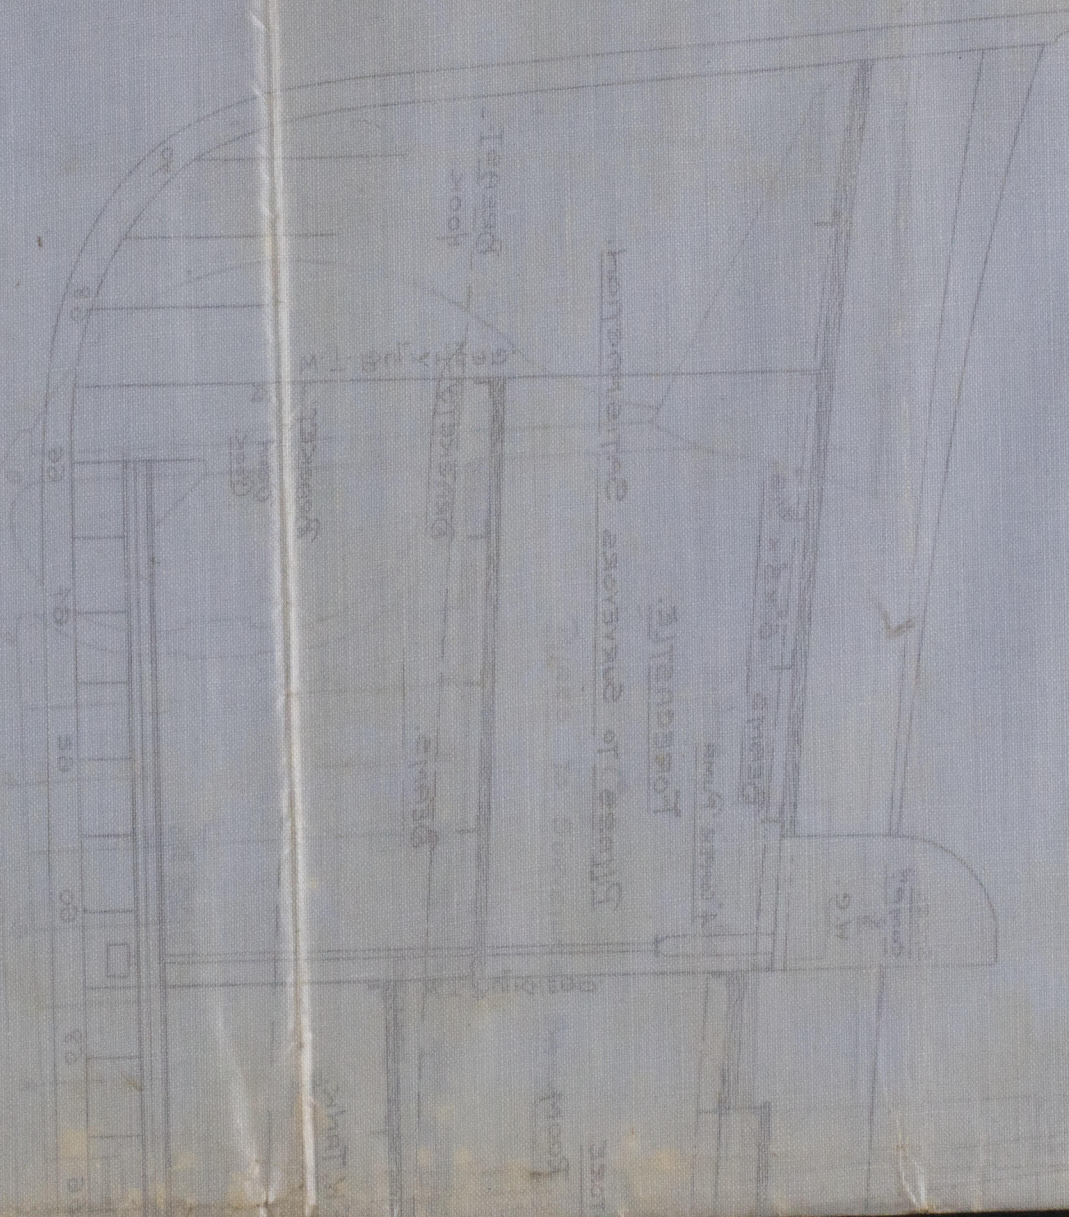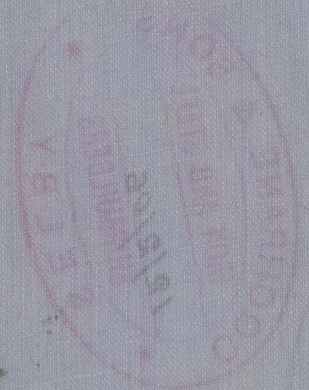

© 2020

Lloyd's Register
Foundation

