



Handwritten notes in red ink, likely detailing specifications or corrections for the ship's profile.

LLOYD'S PROFILE.

DIMENSIONS 330.1 x 46.0 x 24.4 MLD

SCALE 1/8" = 1 FOOT.

TO CLASS "100A1" AT LLOYD'S THREE DECK RULE WITH NORMAL FREEBOARD.

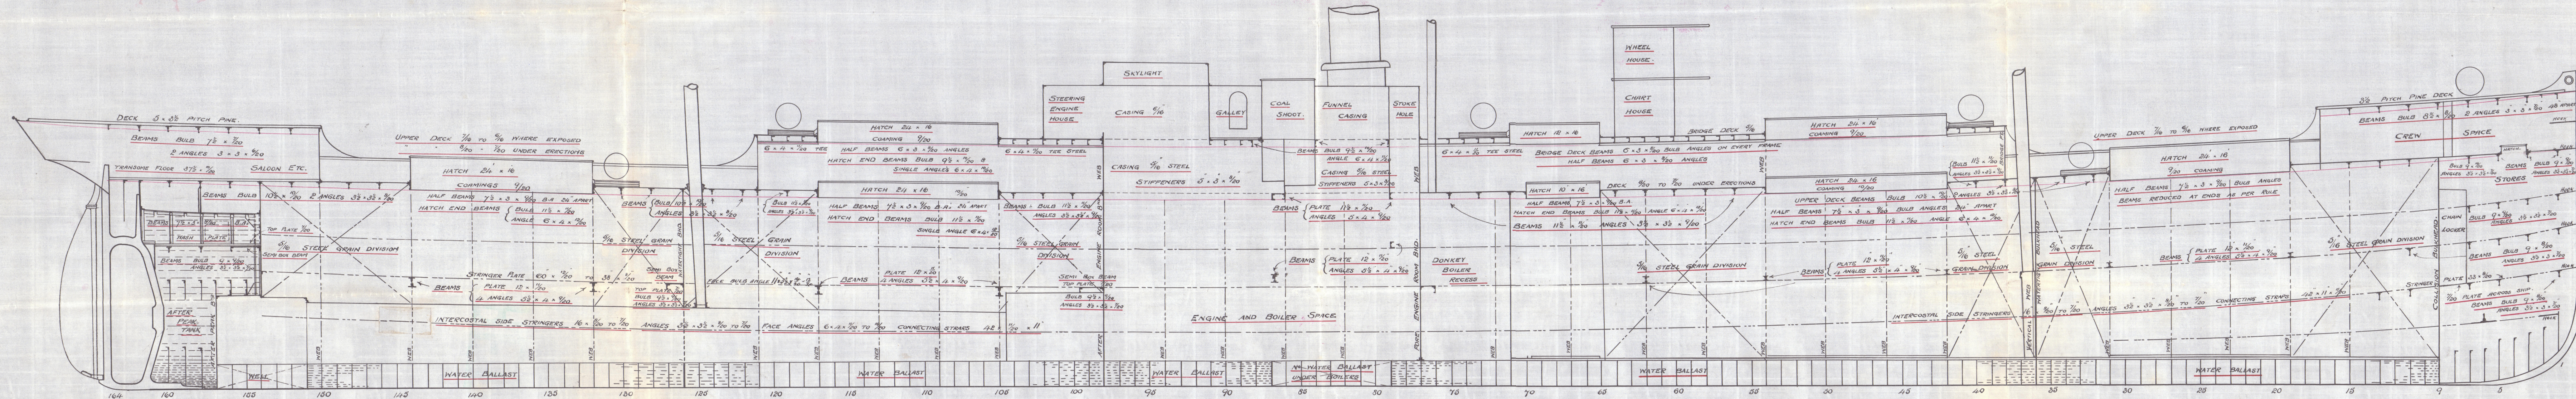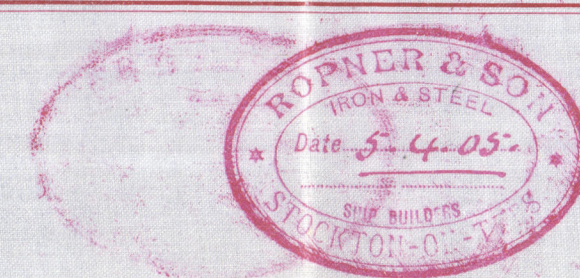

Ropner & Son

SS 414

"Blackton"


Profile

Single Vessel Co No 409 Granite

First Entry Report Plan

Math 7 & Report No 4111

W876-0138

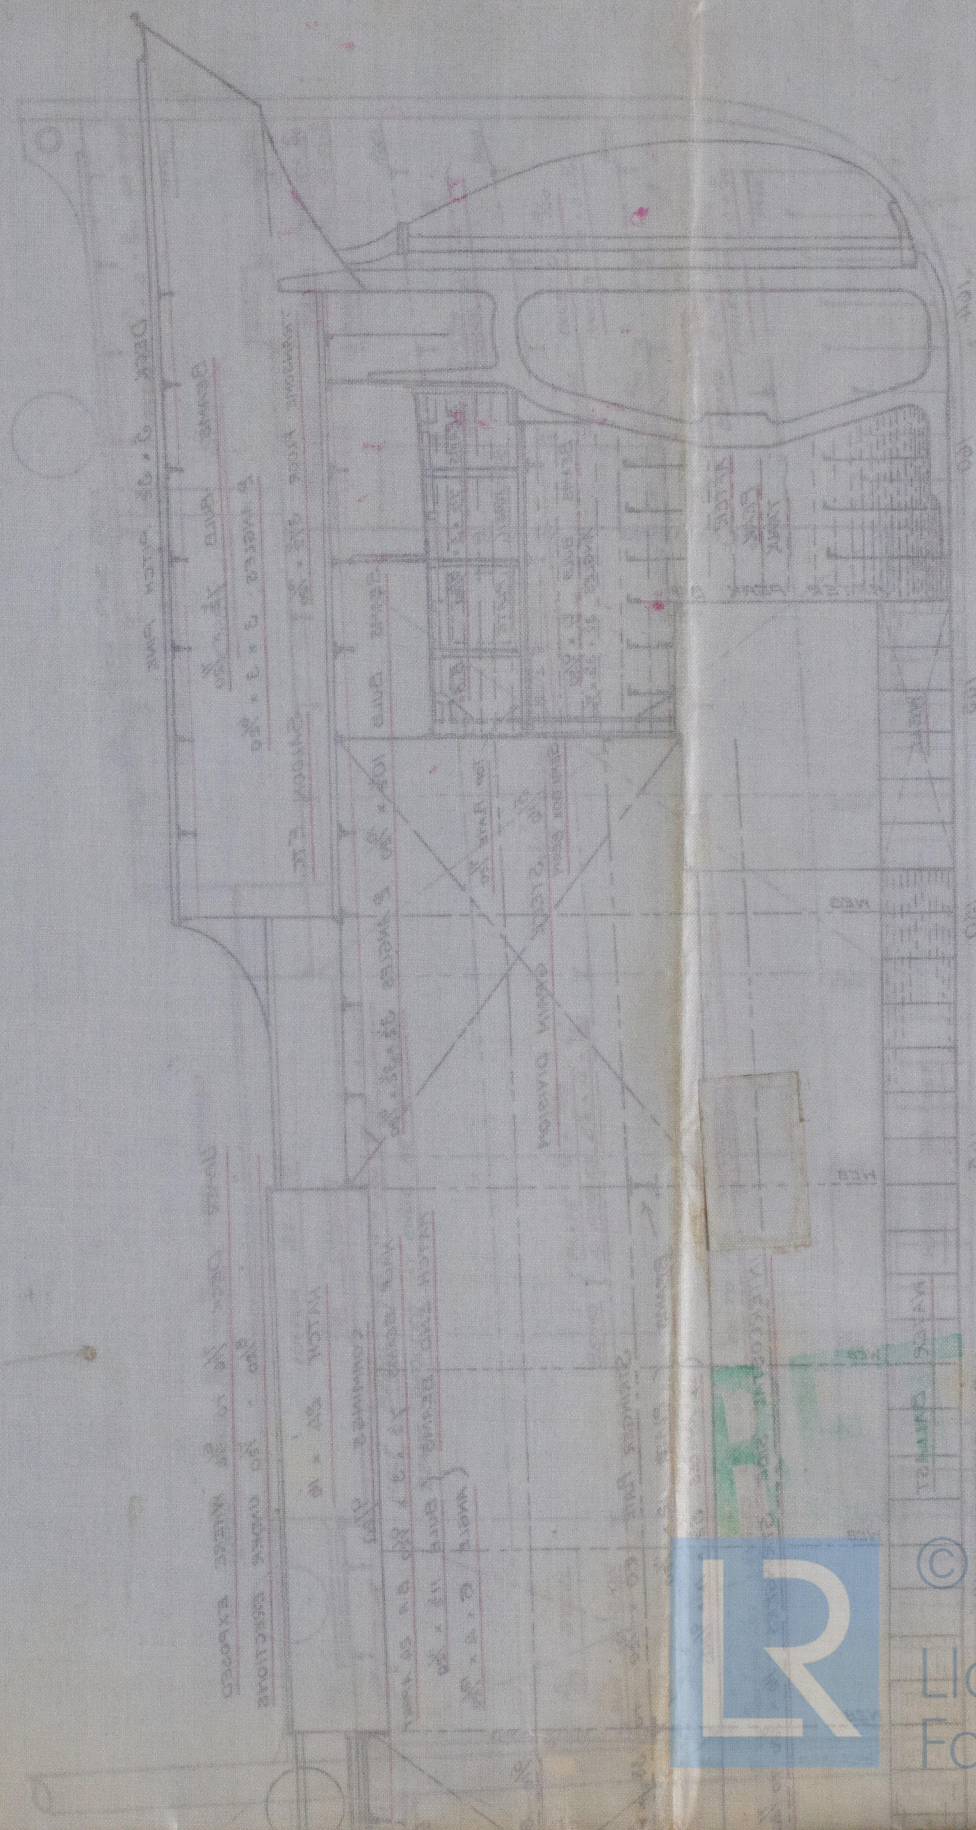

No 414



© 2020

Lloyd's Register
Foundation