

24. 9.13

17. 9. 12.

MIDSHIP SECTION

N^o 589 08


STEEL SCREW TRAWLER

DIMS 120' 0" B.P. x 21' 6" EX 12' 3" MLD

SCALE 1/2 INCH.

VESSEL TO CLASS 100 A.I. STEAM TRAWLER.
DECK PLATED OVER IN WAY OF MACHINERY.
E.B. CASING AS PREVIOUSLY APPROVED.

PLAN No. 8293
FOR ENCLOSURE TO
Messrs. Lloyd's
Surveyors. Hull FROM
LOCHRAIR & SONS, LTD.
SHIPBUILDERS, SELBY.
DATE 22/9/13 *8310*

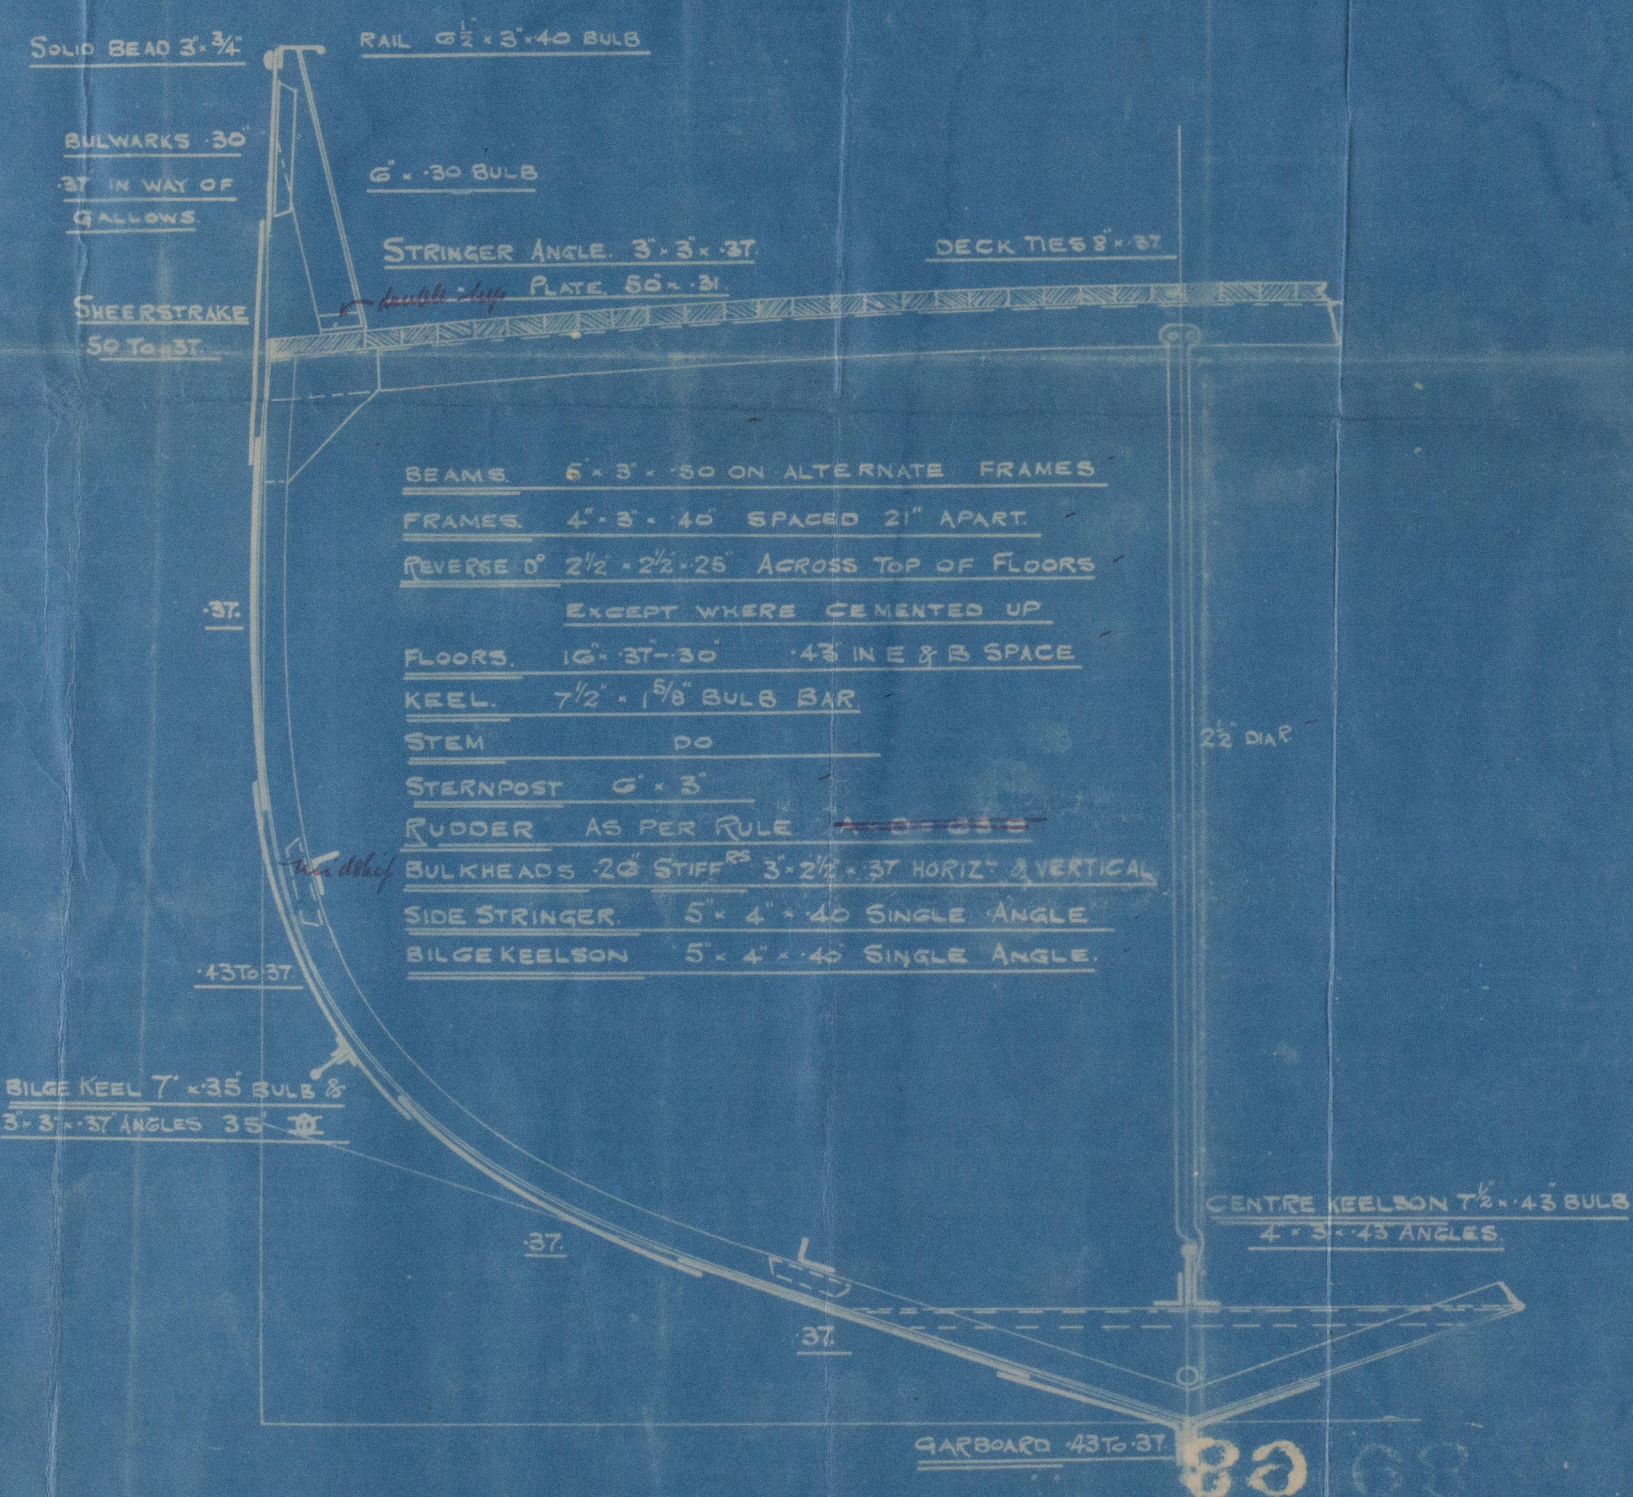

NUMERALS.

B + D = 33.62
L x (B + D) = 4035

PROPORTIONS

L/D = 3.73
B/D = 5.61

EQUIPMENT.

1 ST BOWER ANCHOR.	5 CWTs EX STOCK
2 ND "	4 1/2 "
KEDGE.	2 1/2 "
50 FATHOMS	1" CABLE.
60 "	5 1/2" HAWSER
60 "	4" WARP.

RIVETING.

BUTTS OF SHELL PLATING LAPPED
& DOUBLE RIV^d EXCEPT GARBOARD
& SHEERSTRAKE WHICH ARE TO BE
STRAPPED & DOUBLE RIV^d LANDINGS
DOUBLE RIVETED. BULWARKS SINGLE

27.
26. 9. 13.

W. B.
11. 9. 17




© 2020
Lloyd's Register
Foundation
W877-0050

Cochrane & Sons.
No 589.


Midship Section.

Dimensions
120-0 x 21-37 x 12-25

No 545. "Duplicate of"
"Fentonian" Hull Report
25767

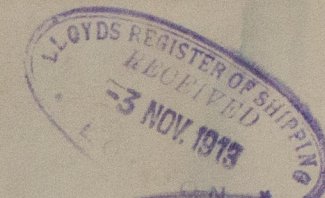

1/2 Belgian
Hull Rpt No. 26881.

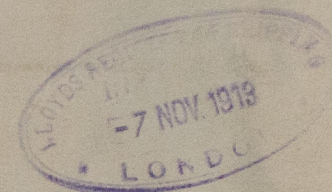

W877-0050

RETAIN



© 2020

Lloyd's Register
Foundation