

18.1.06

— MIDSHIP SECTION —


— STEEL — SCREW — TRAWLER —

N° 370.

DIM- LENGTH 123'-0". BREADTH MLD 21'-6". DEPTH MLD 12'-3". HOLD 11'-6".

— SCALE 1/2" = 1 FOOT. —

TO CLASS 100.A.I. AT LLOYD'S FOR FISHING PURPOSES.

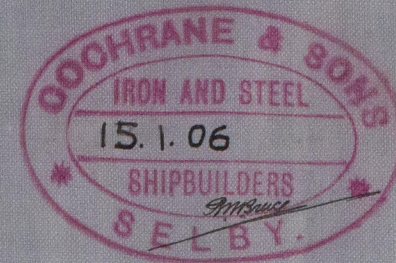

SECTION IN WAY OF E & B SPACE
AS PREVIOUSLY APPROVED.


DECK PLATED IN WAY OF E & B SPACE.

— LLOYD'S NUMBERS. —


1/2 GIRTH	18.87
1/2 BREADTH	10.70
DEPTH	12.72
	42.29 1st N°
LENGTH PER RULE	121.83
	5152.19 2nd N°
BREADTH TO LENGTH	5.6
DEPTH TO LENGTH	9.5
RAISED FOLE DECK	17'-10" x 15'
QUARTER "	76'-0" x 15'

— EQUIPEMENT. —

1st	BOWER ANCHOR.	5 1/2 CWTs EX STOCK
2nd	"	4 1/2 " " "
3rd	"	2 1/2 " " "
90	FATHOMS	1" SHOT LINK CABLE
60	"	6" SHOT HAWSER.
60	"	4 1/2" WARP.

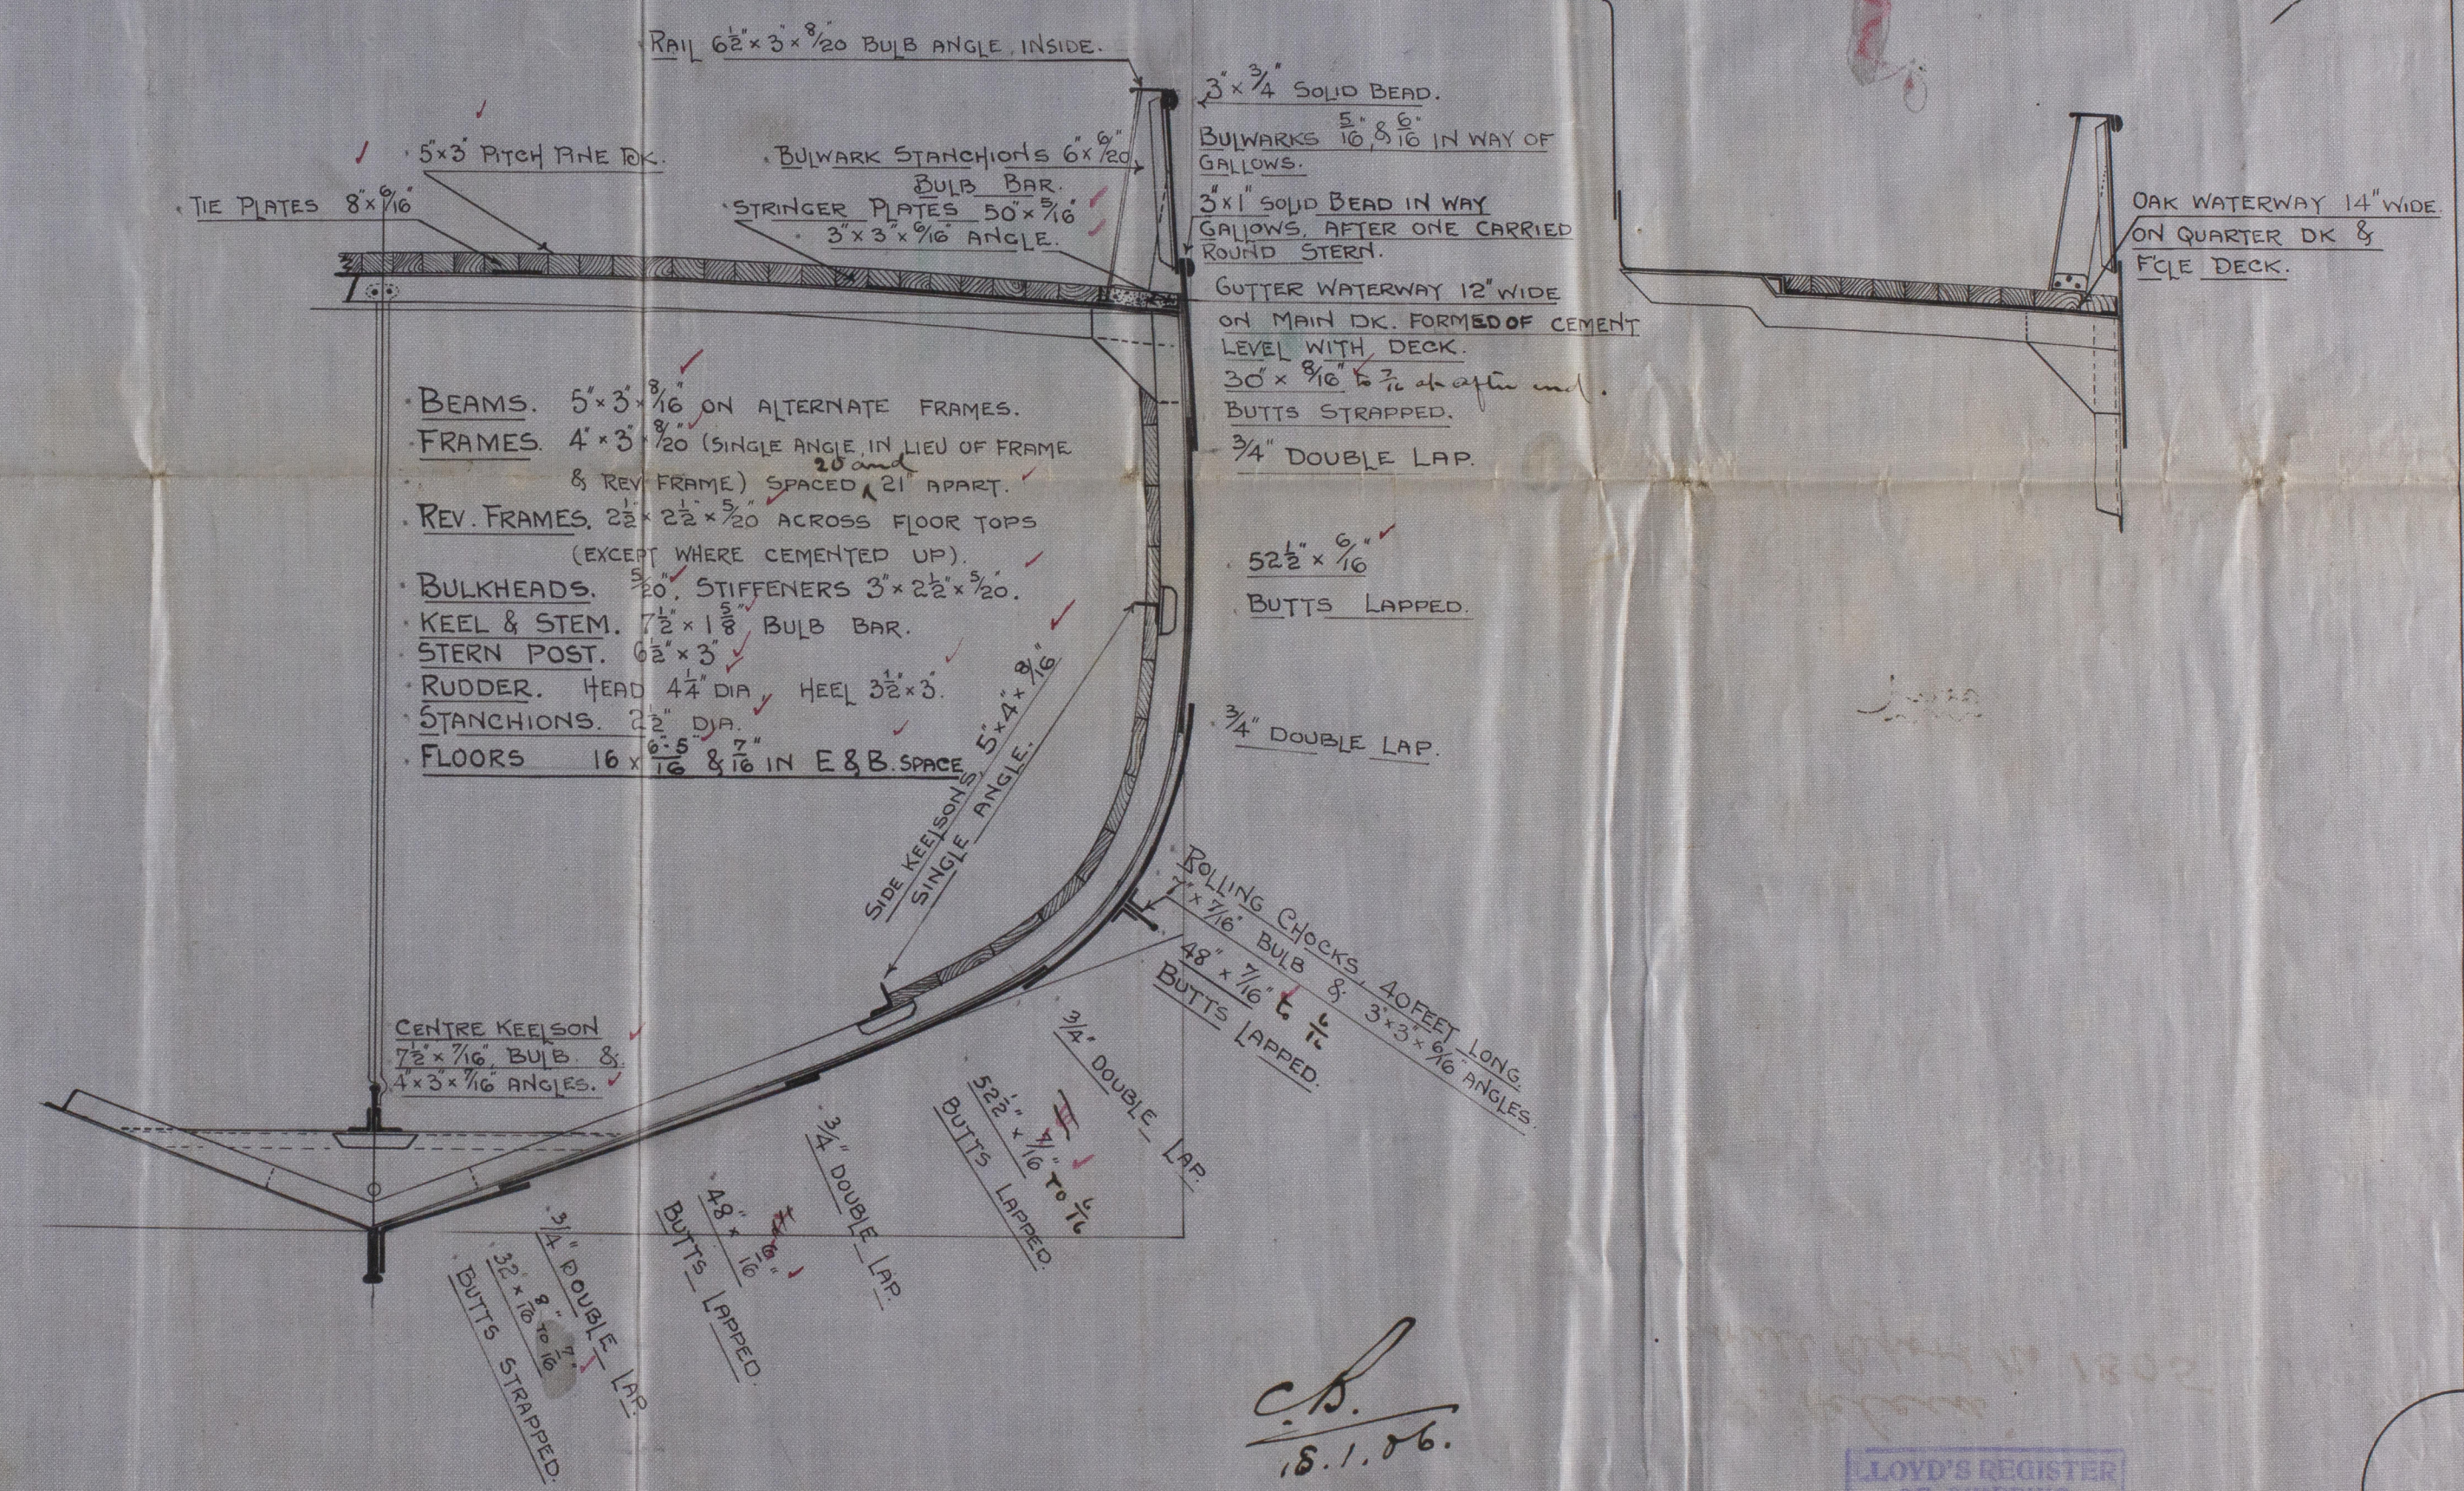

C.B.
18.1.06.

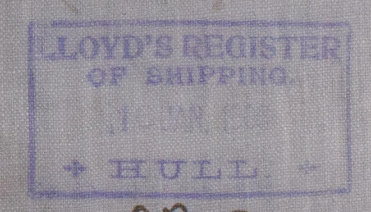


Cochran & Sons.

No. 370.

Midship Section.

S/s 'Helcia'
Hull Report No. 1805

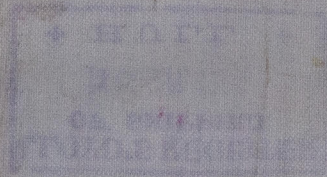

W877-0136

Midship Section No 370.



© 2020

Lloyd's Register
Foundation