

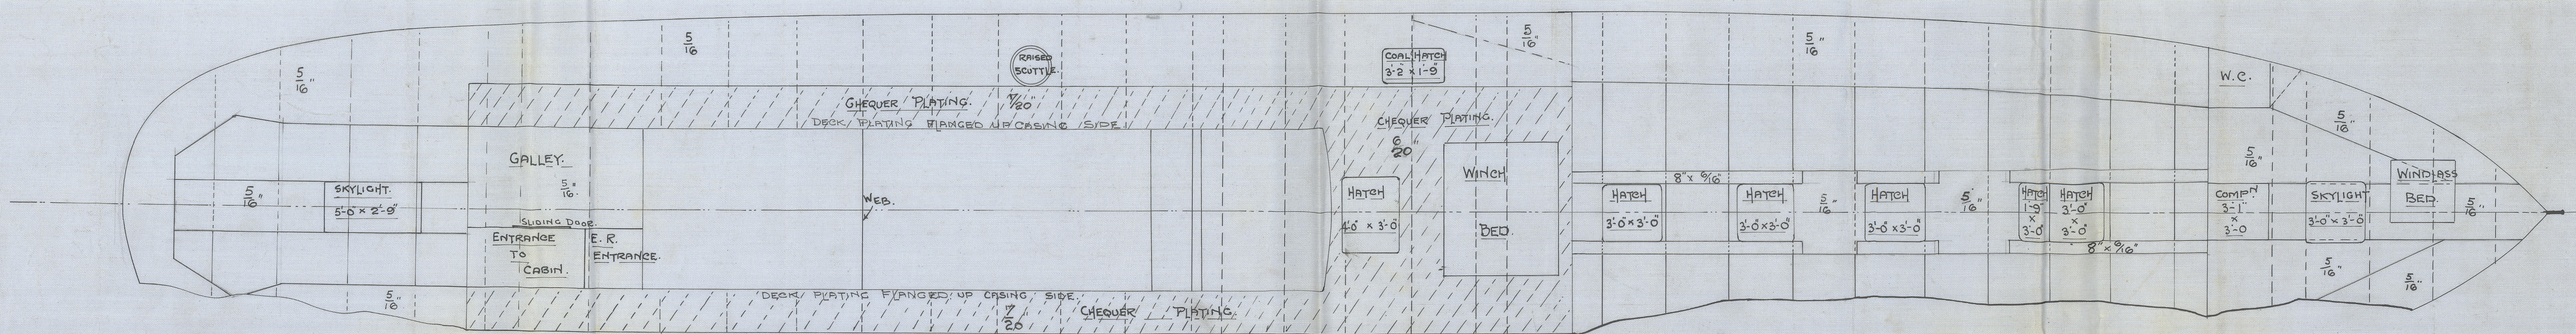


— PROFILE & DECK PLAN —
— STEEL SCREW TRAWLER —
— Nº 370 —
123'-0" x 21'-6" x 11'-6" DEPTH OF HOLD
— SCALE 1/4" = 1 FOOT. —

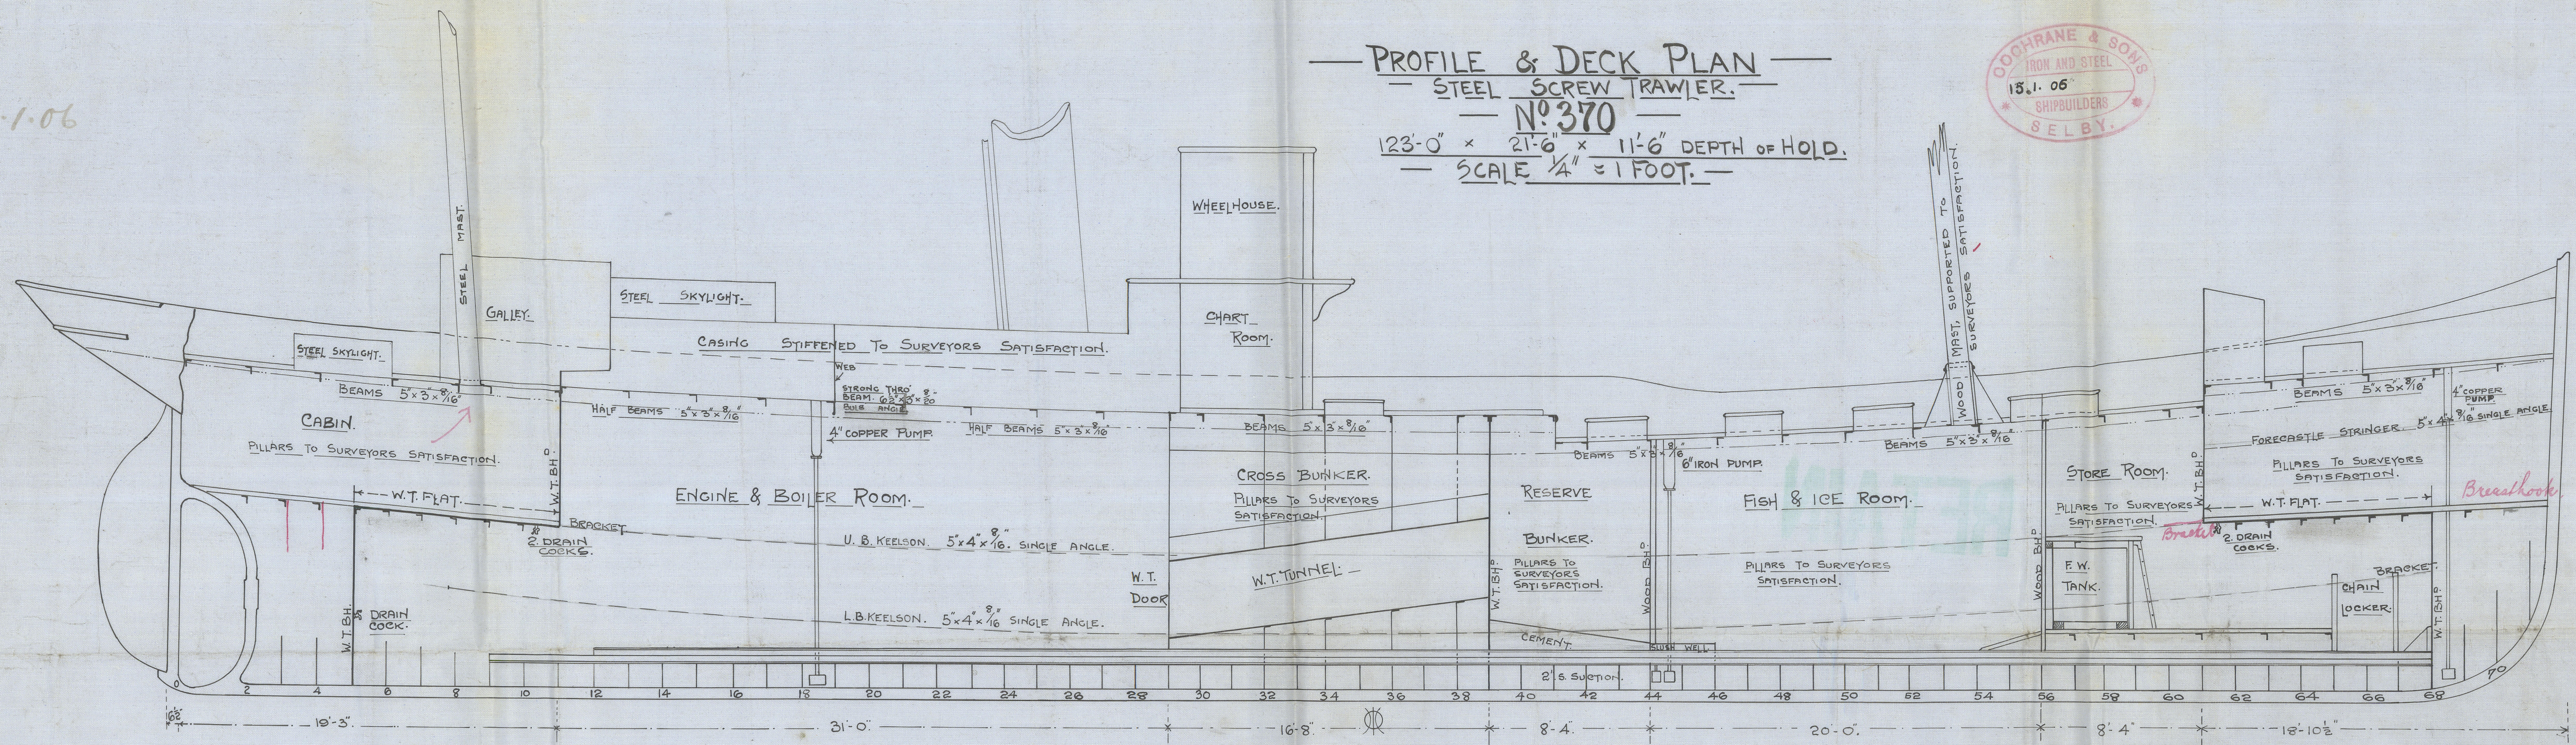

C.B.
18.1.86.

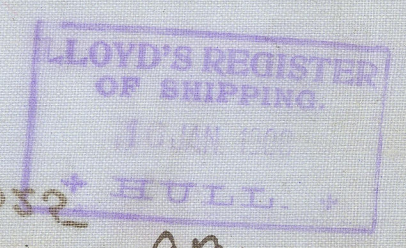

Profile of Deck Plan No 340.