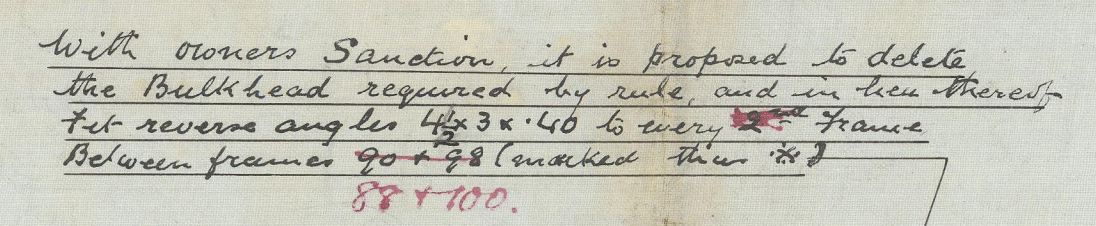


$$\frac{1}{2}$$


© 2020
Lloyd's Register
Foundation

S.S.N. 26, 27 ~~28, 29~~

Profile Plan

The Fort Shipbuilding & Engineering
8-40
Alton

7/8 Henry & Co. & Co.

Lth. 15259

St. Nantes ex Portus Mercurii

Lth. 15287

RI 27 OCT. 1916

RETAIN

W 878-0216



© 2020

Lloyd's Register
Foundation