

S S No 150.

MIDSHIP SECTION.

DIMS: 165'-0" BR x 26'-0" N^W x 13'-5" N^W.

CLASS 100 A1. LLOYDS.

SCALE 1/2 IN. = 1 FT.

NUMERALS.


BREADTH 26.00
DEPTH 13.42
TRANS. NO 39.42
LENGTH 165.0
LONG. NO 6504.30

L/D = 12.2

DISP COEF .73.

EQUIPMENT. 6979.

R.Q.D. = (80.5 x 3.75) + BRIDGE 3/4 (14 x 6.75) +
F'ILE 3/4 (20.25 x 6.75) + 6504 = 6979
2 BOWERS 12 1/4 CMTS STOCKLESS
1 " 10 1/4 " "
1 STREAM 4 " EX STOCK
1 KEDGE 1 3/4 " "
195 FMS 1 3/16 STUB LINK CABLE
60 " 2 3/4 STEEL WIRE
75 " 2 3/4 " "
90 " 6 HAWSER.

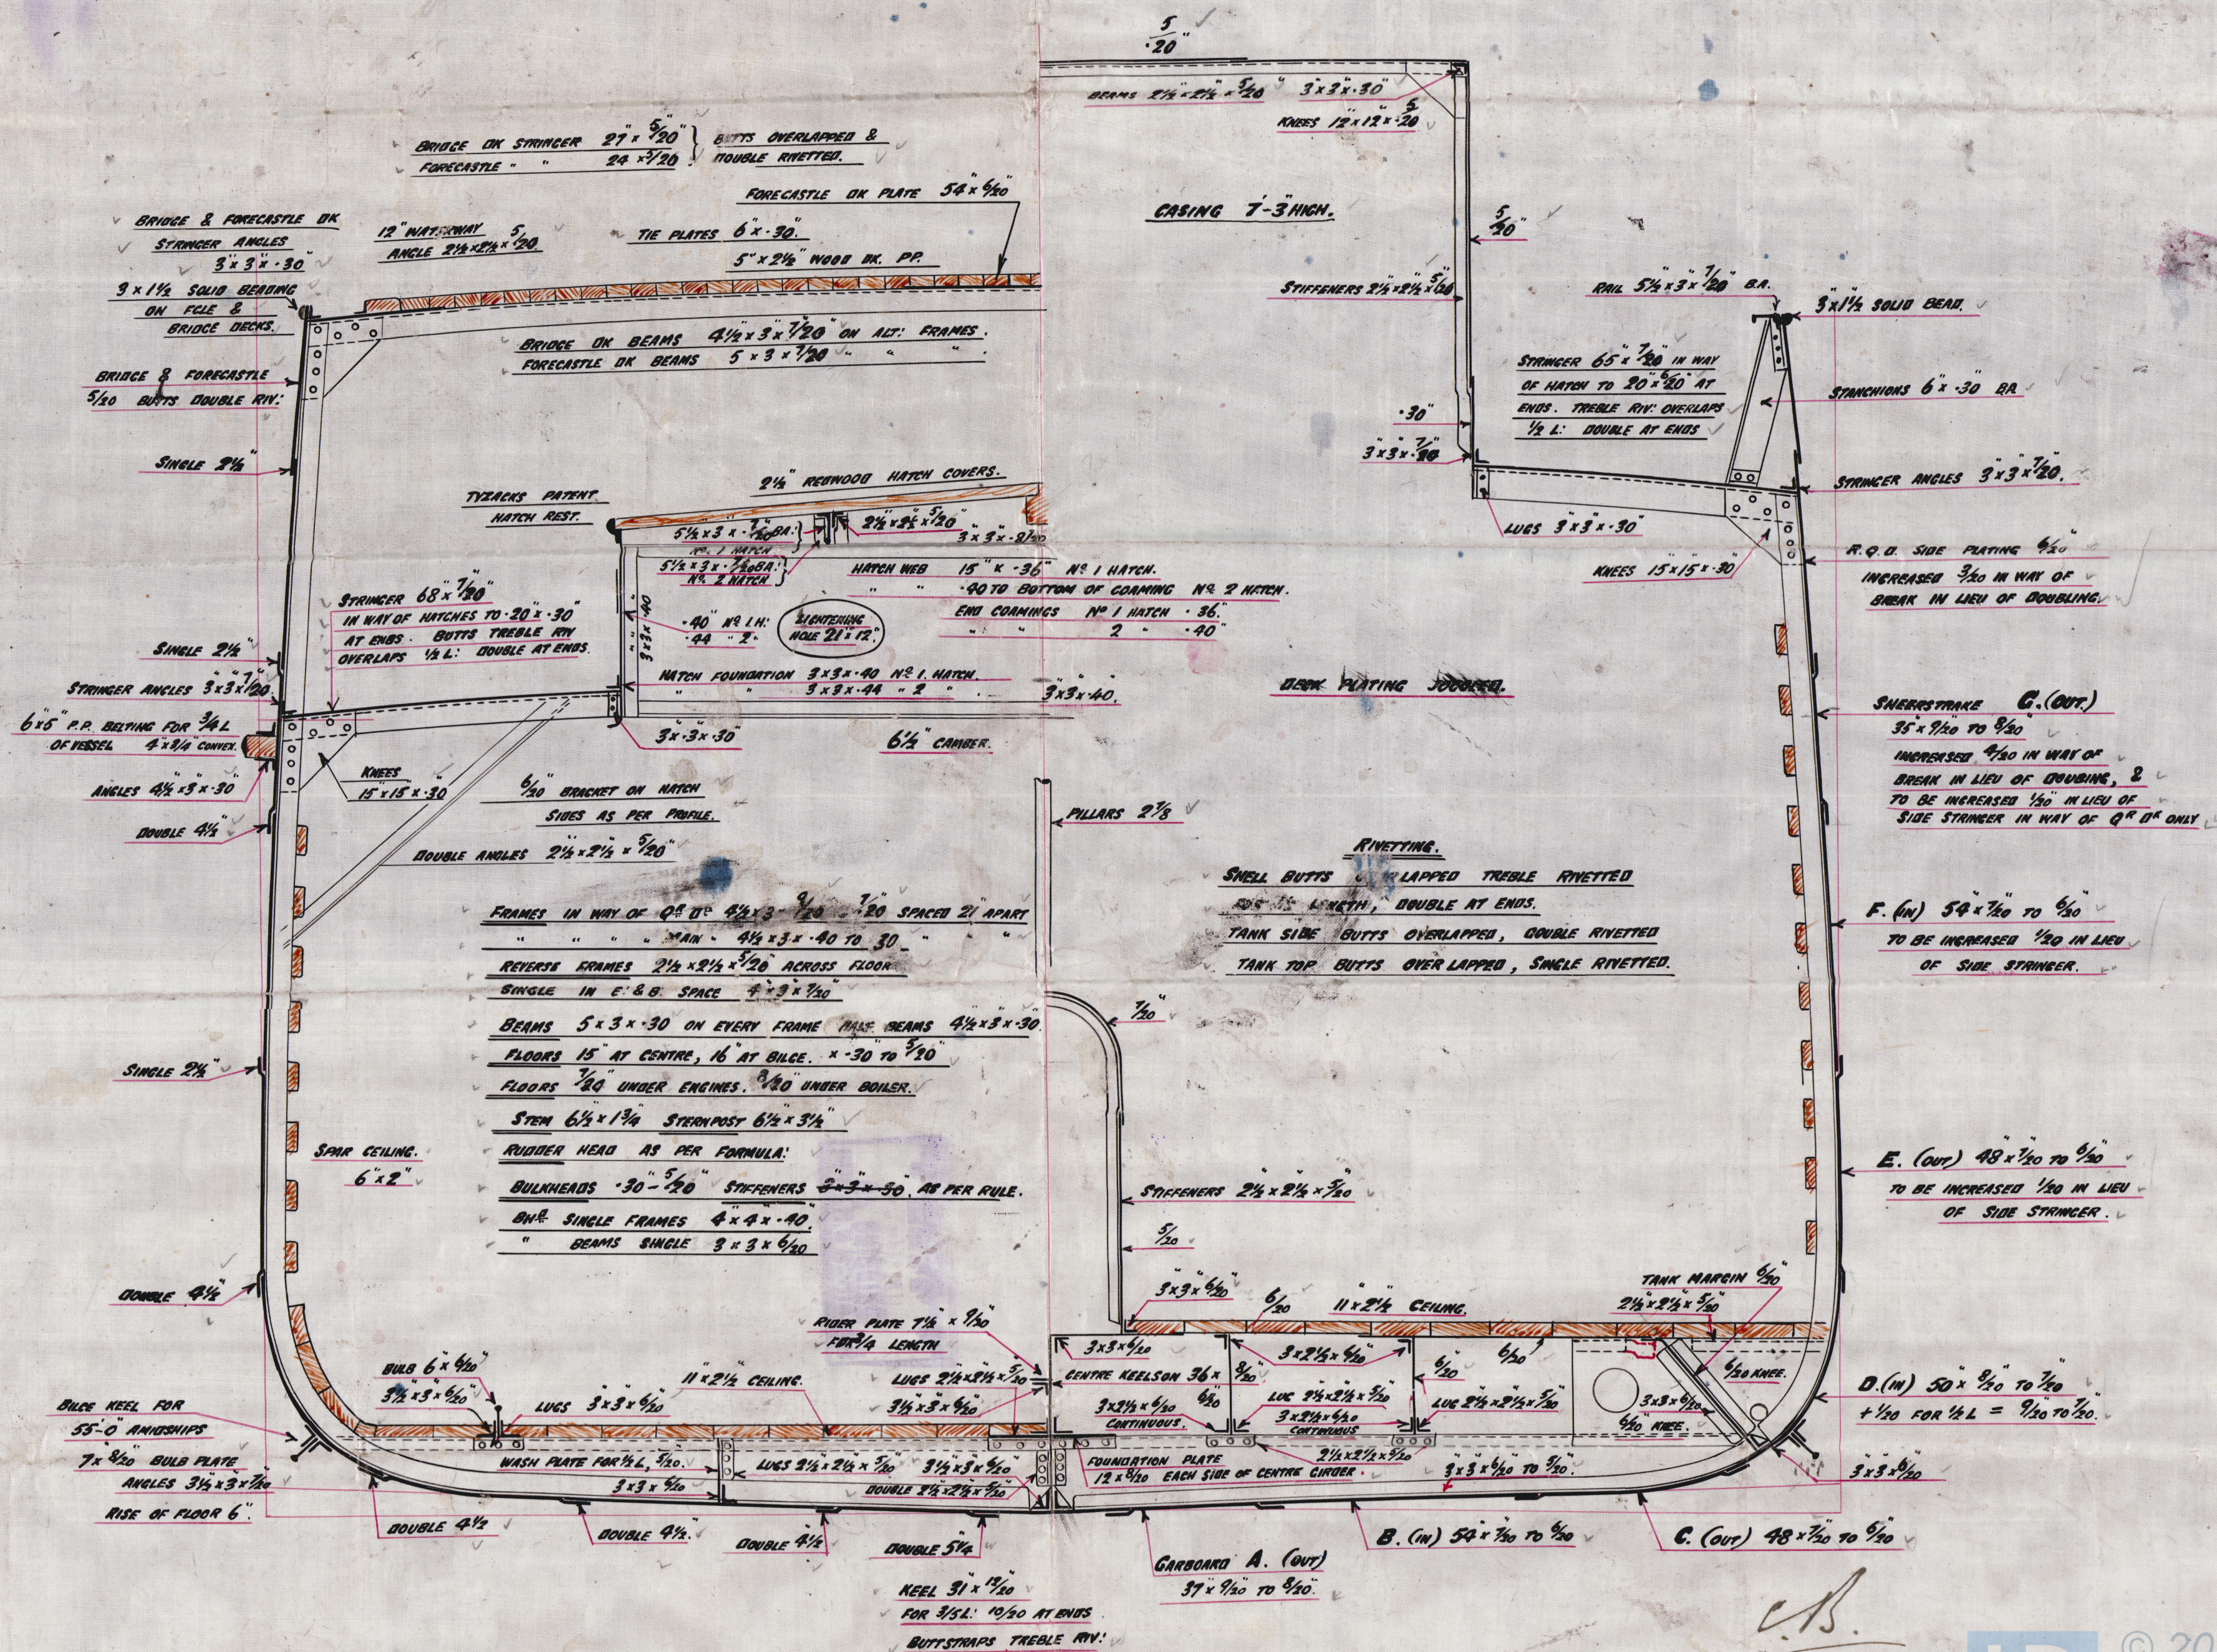

Boole S. & R. Co.

No. 150

Midship Section.

Western

Leign I

Shell Report No. 2512 4

FRI. NOV. 22. 1910

W88-0165



© 2019

Lloyd's Register
Foundation