

Black's 299

Drinking water for

York S. B. Co. No 150

1 Vlt
100 lbs Wp

No 687
Lloyas Test
200 lbs
GAH 3/4/12

" TEIGN I "

HUL 25/24.

W88-0168



© 2019

Lloyd's Register
Foundation

One Mild Steel Vert. Donkey Boiler under Lloyds Survey

Work. Press. 100 lbs. Test Press. 200 lbs. per sq. in.

Scale $1\frac{1}{2}" = 1\text{Foot}$

FOR
GOOLE SHIPBUILDING COY. LTD.

S/S No 150

Boiler No 299.

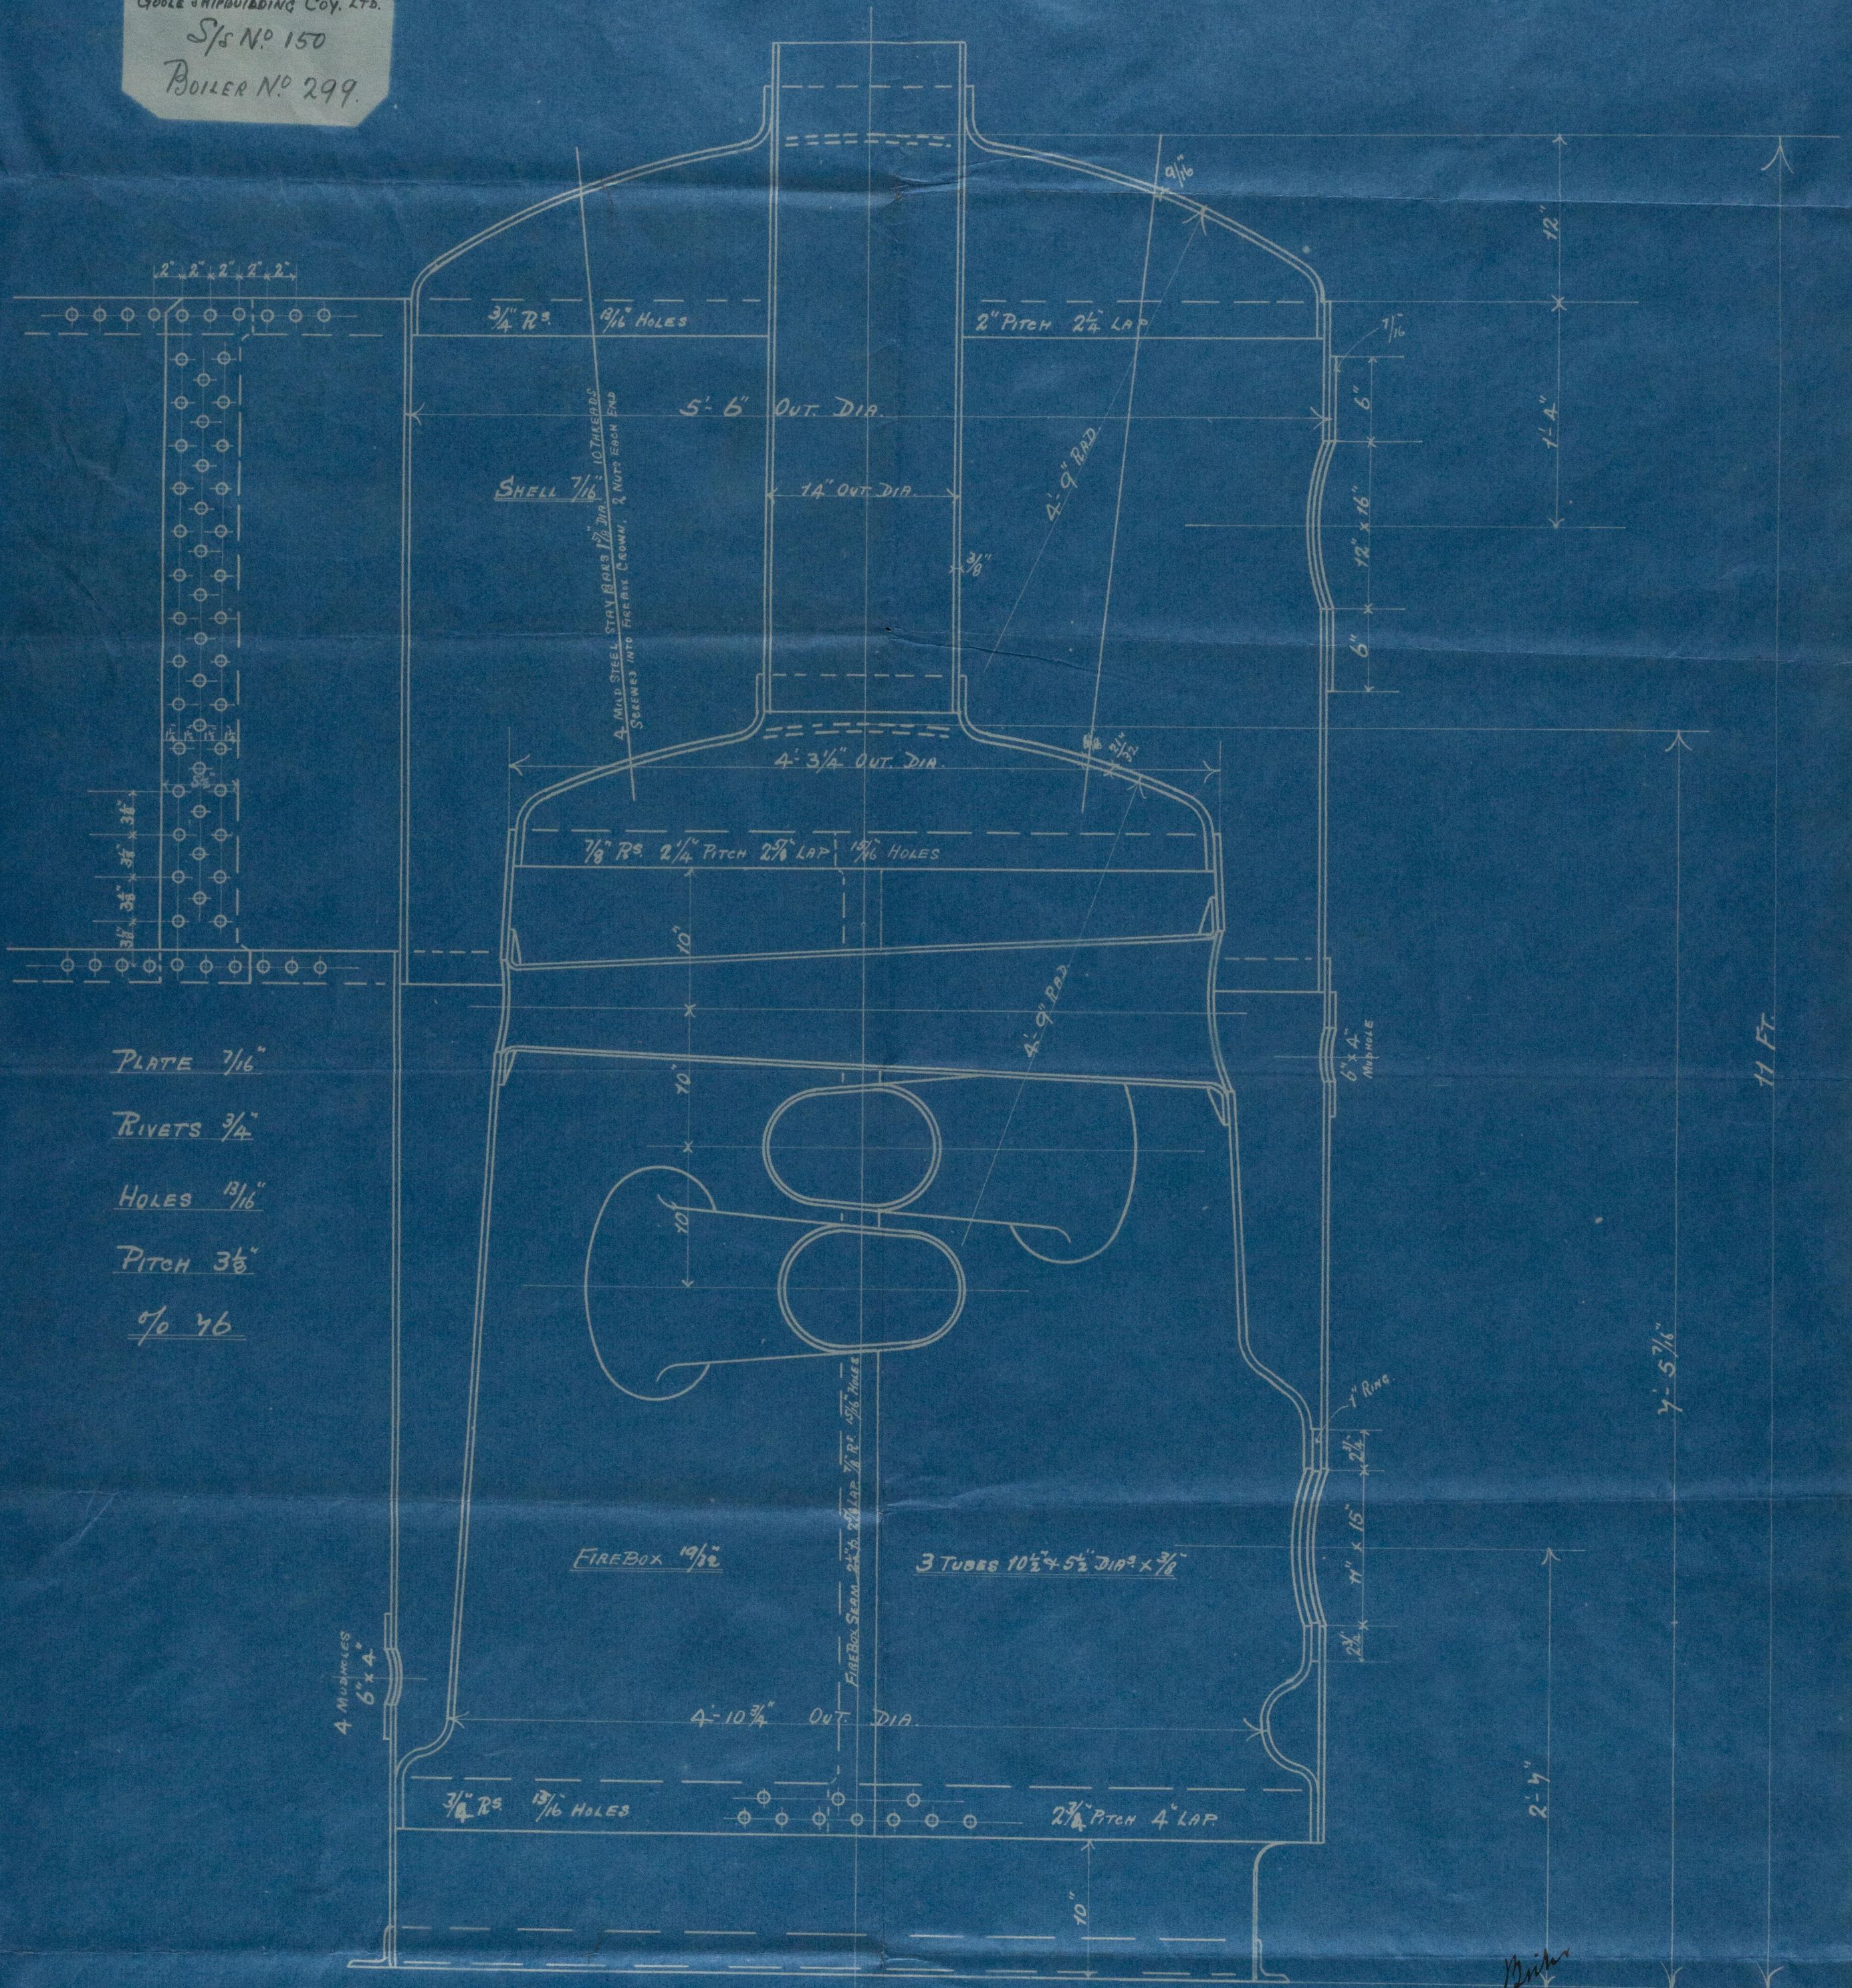


PLATE $7/16"$

RIVETS $3/4"$

HOLES $13/16"$

PITCH $3\frac{1}{2}"$

$\% 46$

FIREBOX $19/32$

3 TUBES $10\frac{1}{2} \times 5\frac{1}{2}$ DIA. $\times \frac{7}{16}$

4'-10 3/4" OUT. DIA.

3/4" R. 13/16" HOLES

2 3/4" PITCH 4" LAP

GEO. BLACK & SONS
TWEEDMOUTH BOILER WORKS
BERWICK-ON-TWEED.

Imp. 7 294/294
En. 21/11/11



Lloyds Register of Shipping
W 88-0168