


7.5.06

PROFILE
 LBP 340'-0" BEX 47'-0" DM 29'-10"
 SCALE 1/8" = ONE FOOT.

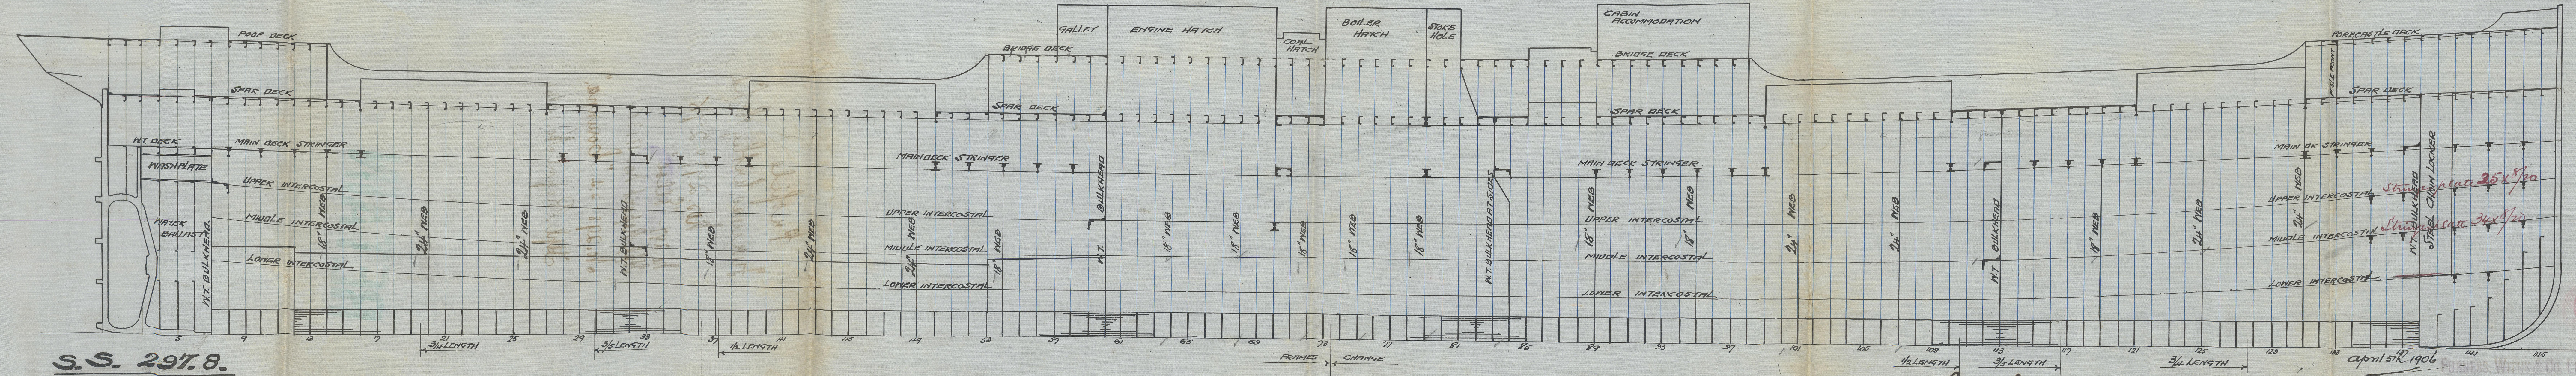

S.S. 297.8.

7.5.06

Bottom forward strengthened as per rule

APR 5 1906
 FORNERS, WITBY & CO. LIMITED
 SHIPBUILDERS & REPAIRERS
 WEST HARTLEPOOL

7.5.06
 J.P.

Profile
Furness, Witley No. 10

No. 297° 298

No. 297 - "Elle"

Hpl. Report No. 13130

No. 298 - s.s. "Counna."

Hpl. Report No. 13144

RETAIN

W880-0001



© 2020

Lloyd's Register
Foundation