


N^{os} 498 TO 502

STEEL.

4548.9 A. PLATING N°

60 4 WARP.

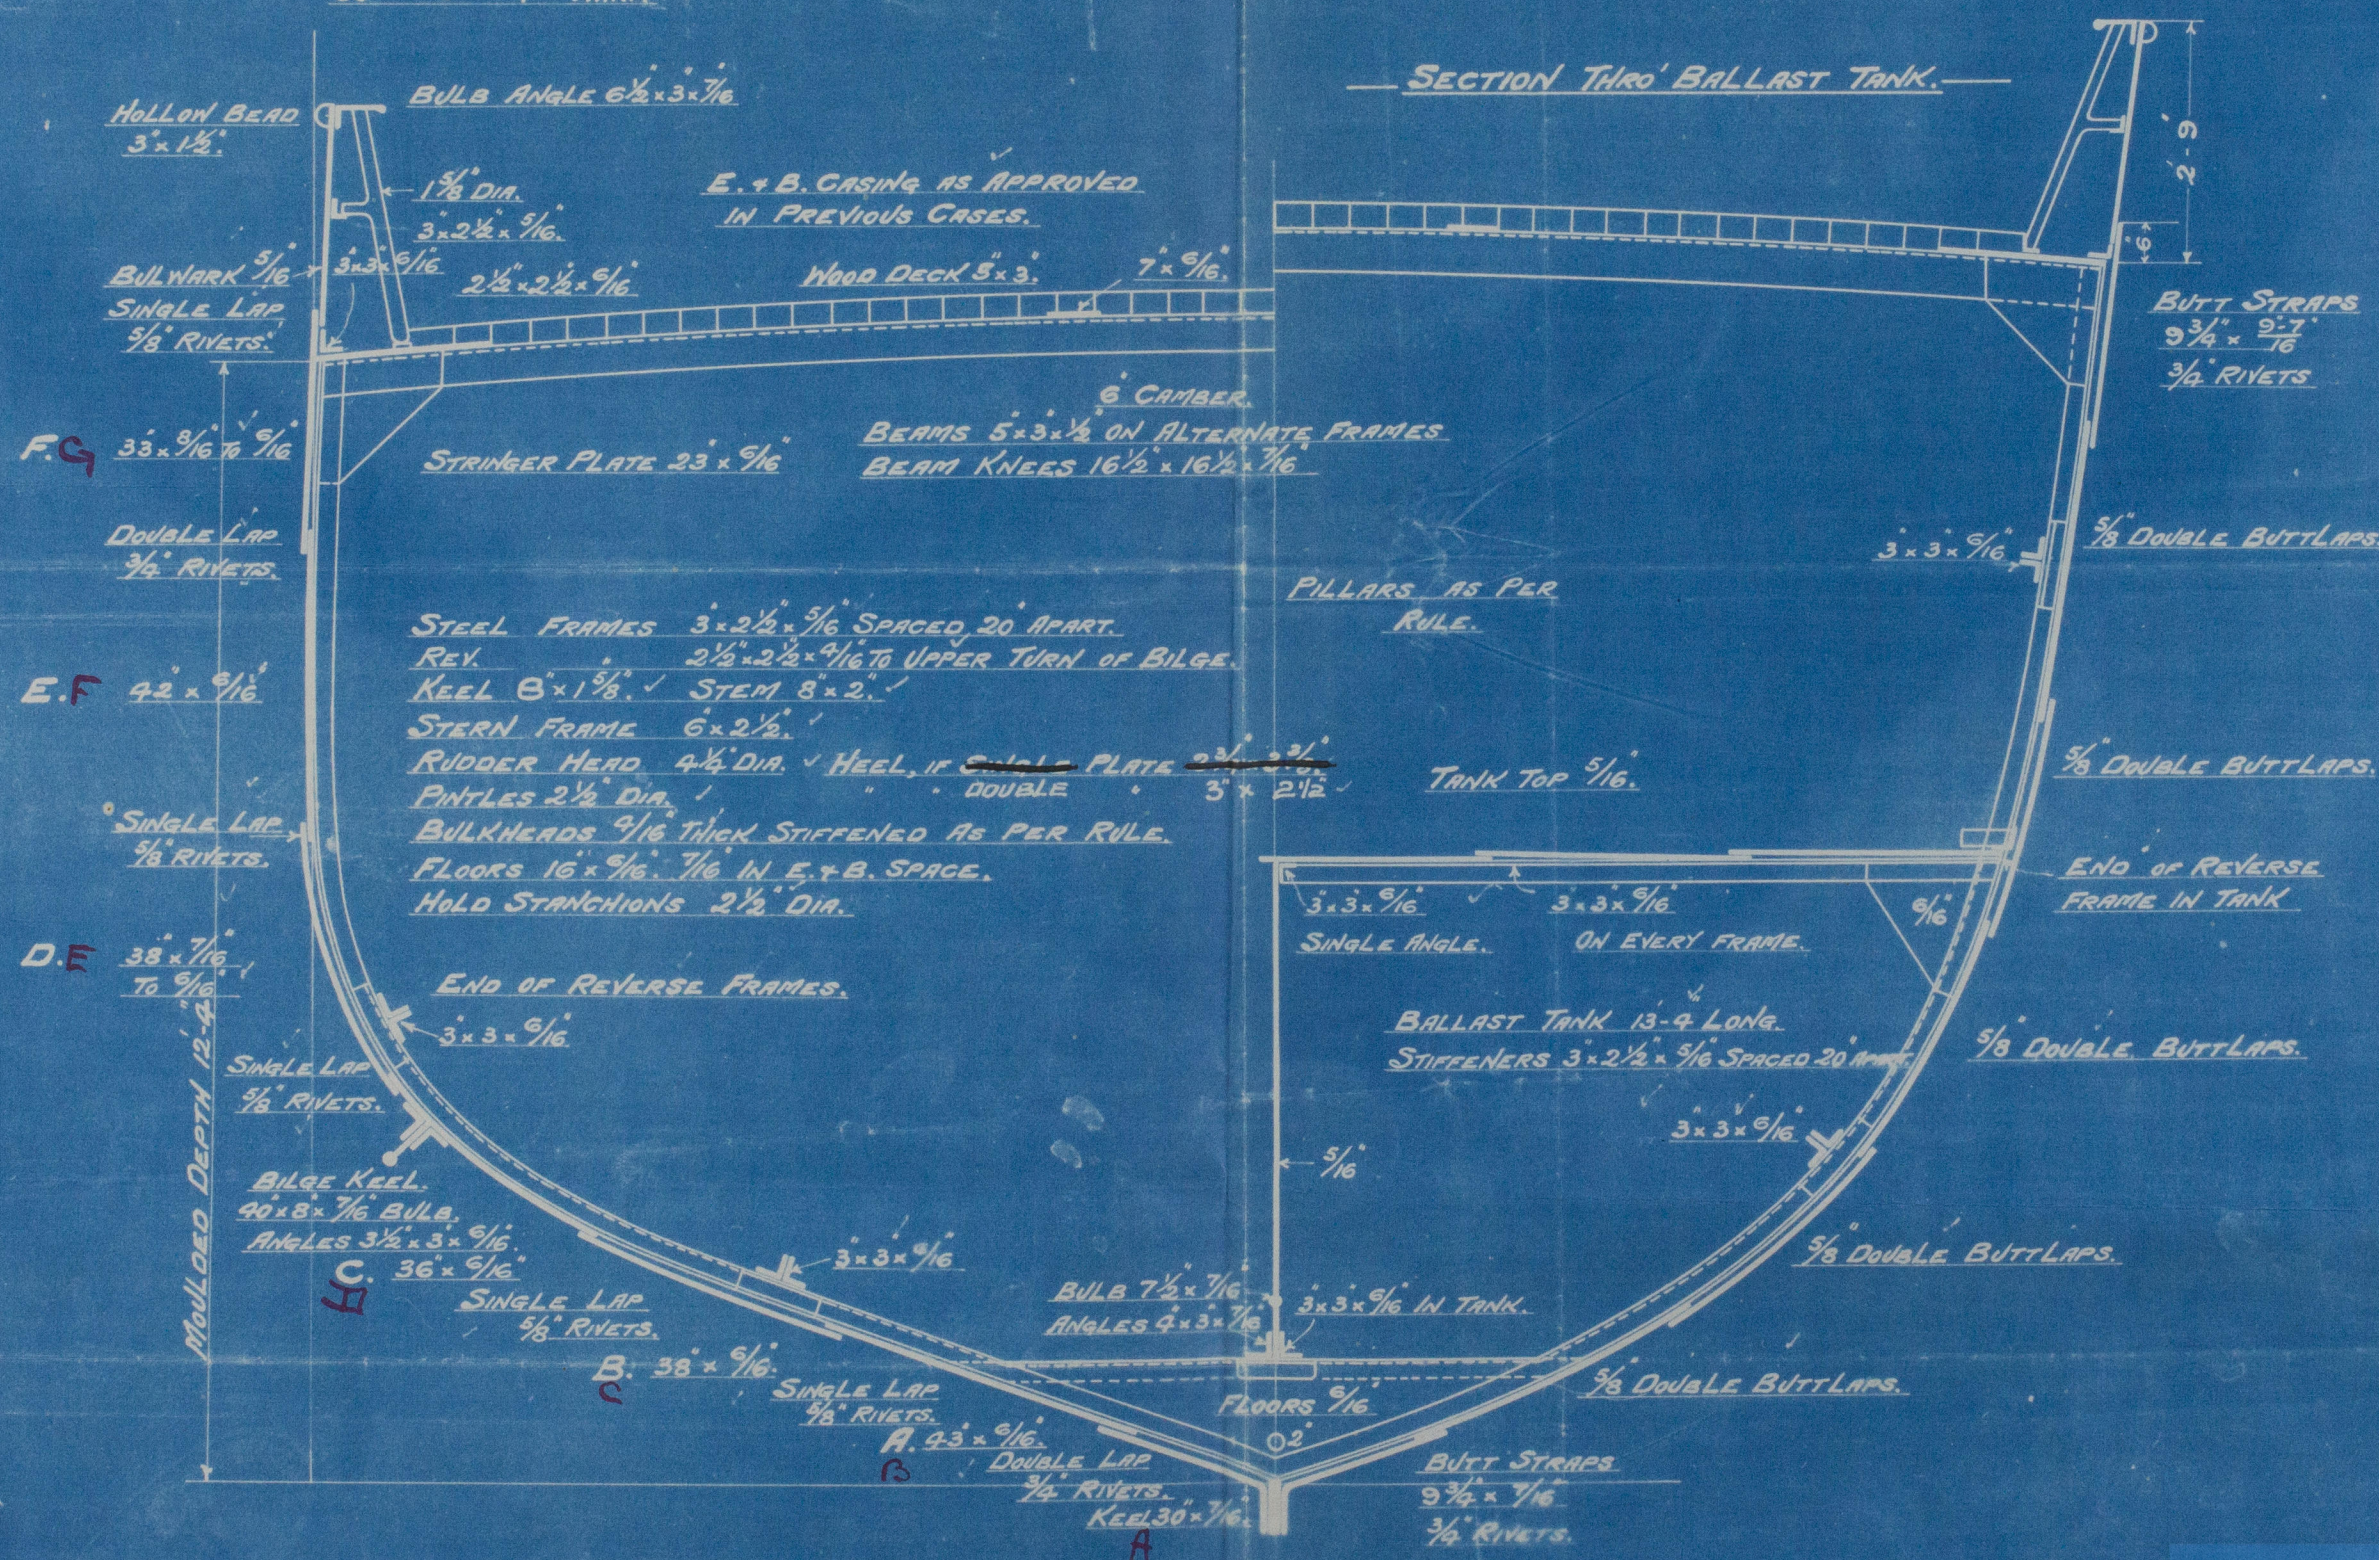


Garle's S. & R. Co.
Nos 498 to 502
Duplicate.
Midship Section.

S/S "Isle of Man". No 501

Hull Report No. 17203

RETAIN

W880-0125



© 2020

Lloyd's Register
Foundation