
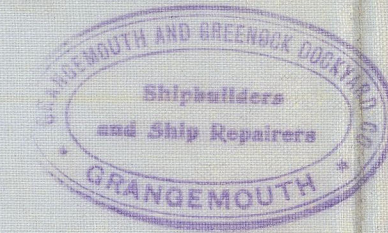


24.11.03
10.12.03
21.12.03


Handwritten notes and calculations in the upper left corner, including dimensions like 3' x 1/2" and 4' x 1/2".

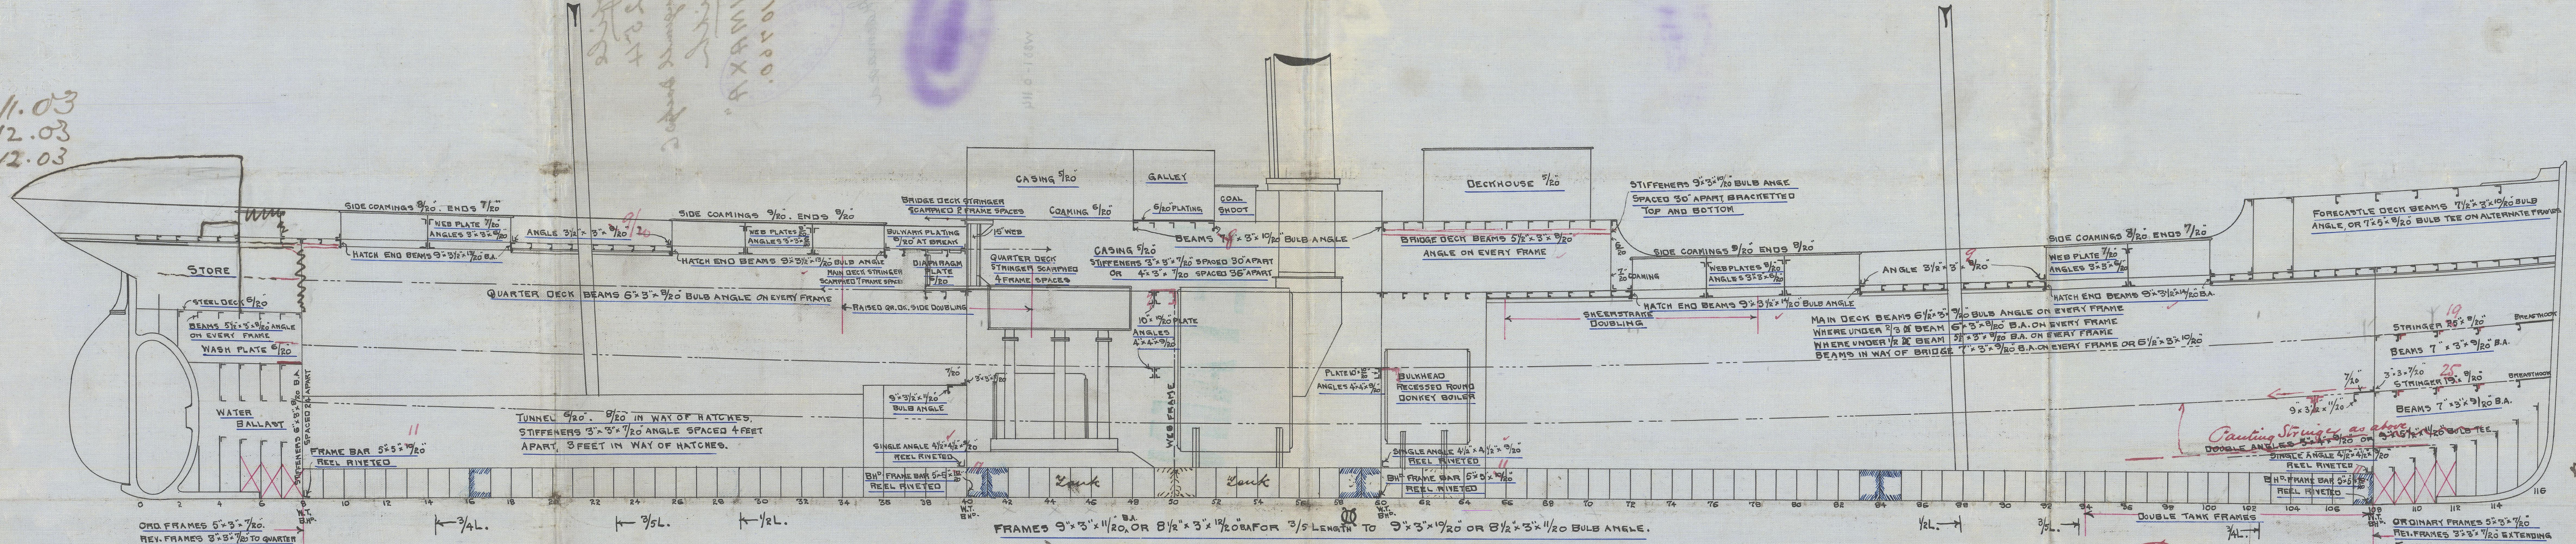

Nº 254.
PROFILE & DECK PLANS.
DIMENSIONS 235'-0" x 37'-0" x 19'-0" MOULDED.
SCALE 1/8" = 1 FOOT.

Bottom forward strengthened
as per rules.

Base plating increased
2/20 for ice.

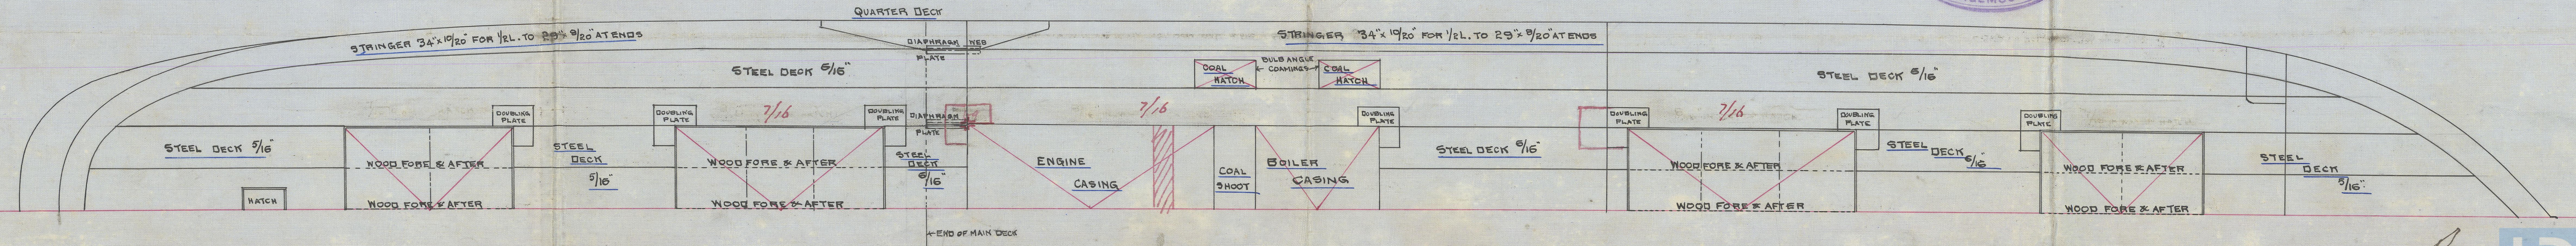

Handwritten signature and date, "21.11.03".



Profile

Nº 254

Messrs. Granger & Co.

Liab

S.S. "MAIMAXA"

Rept Nº. 10760.

Maimaxa

w881-0114



© 2020

Lloyd's Register
Foundation