


28.8.07
6.9.07
7.10.07

— N° 245 —
PROFILE AND DECK PLANS

SCALE $\frac{1}{8}" = 1 \text{ FOOT}$

164 x 29.9 x 14

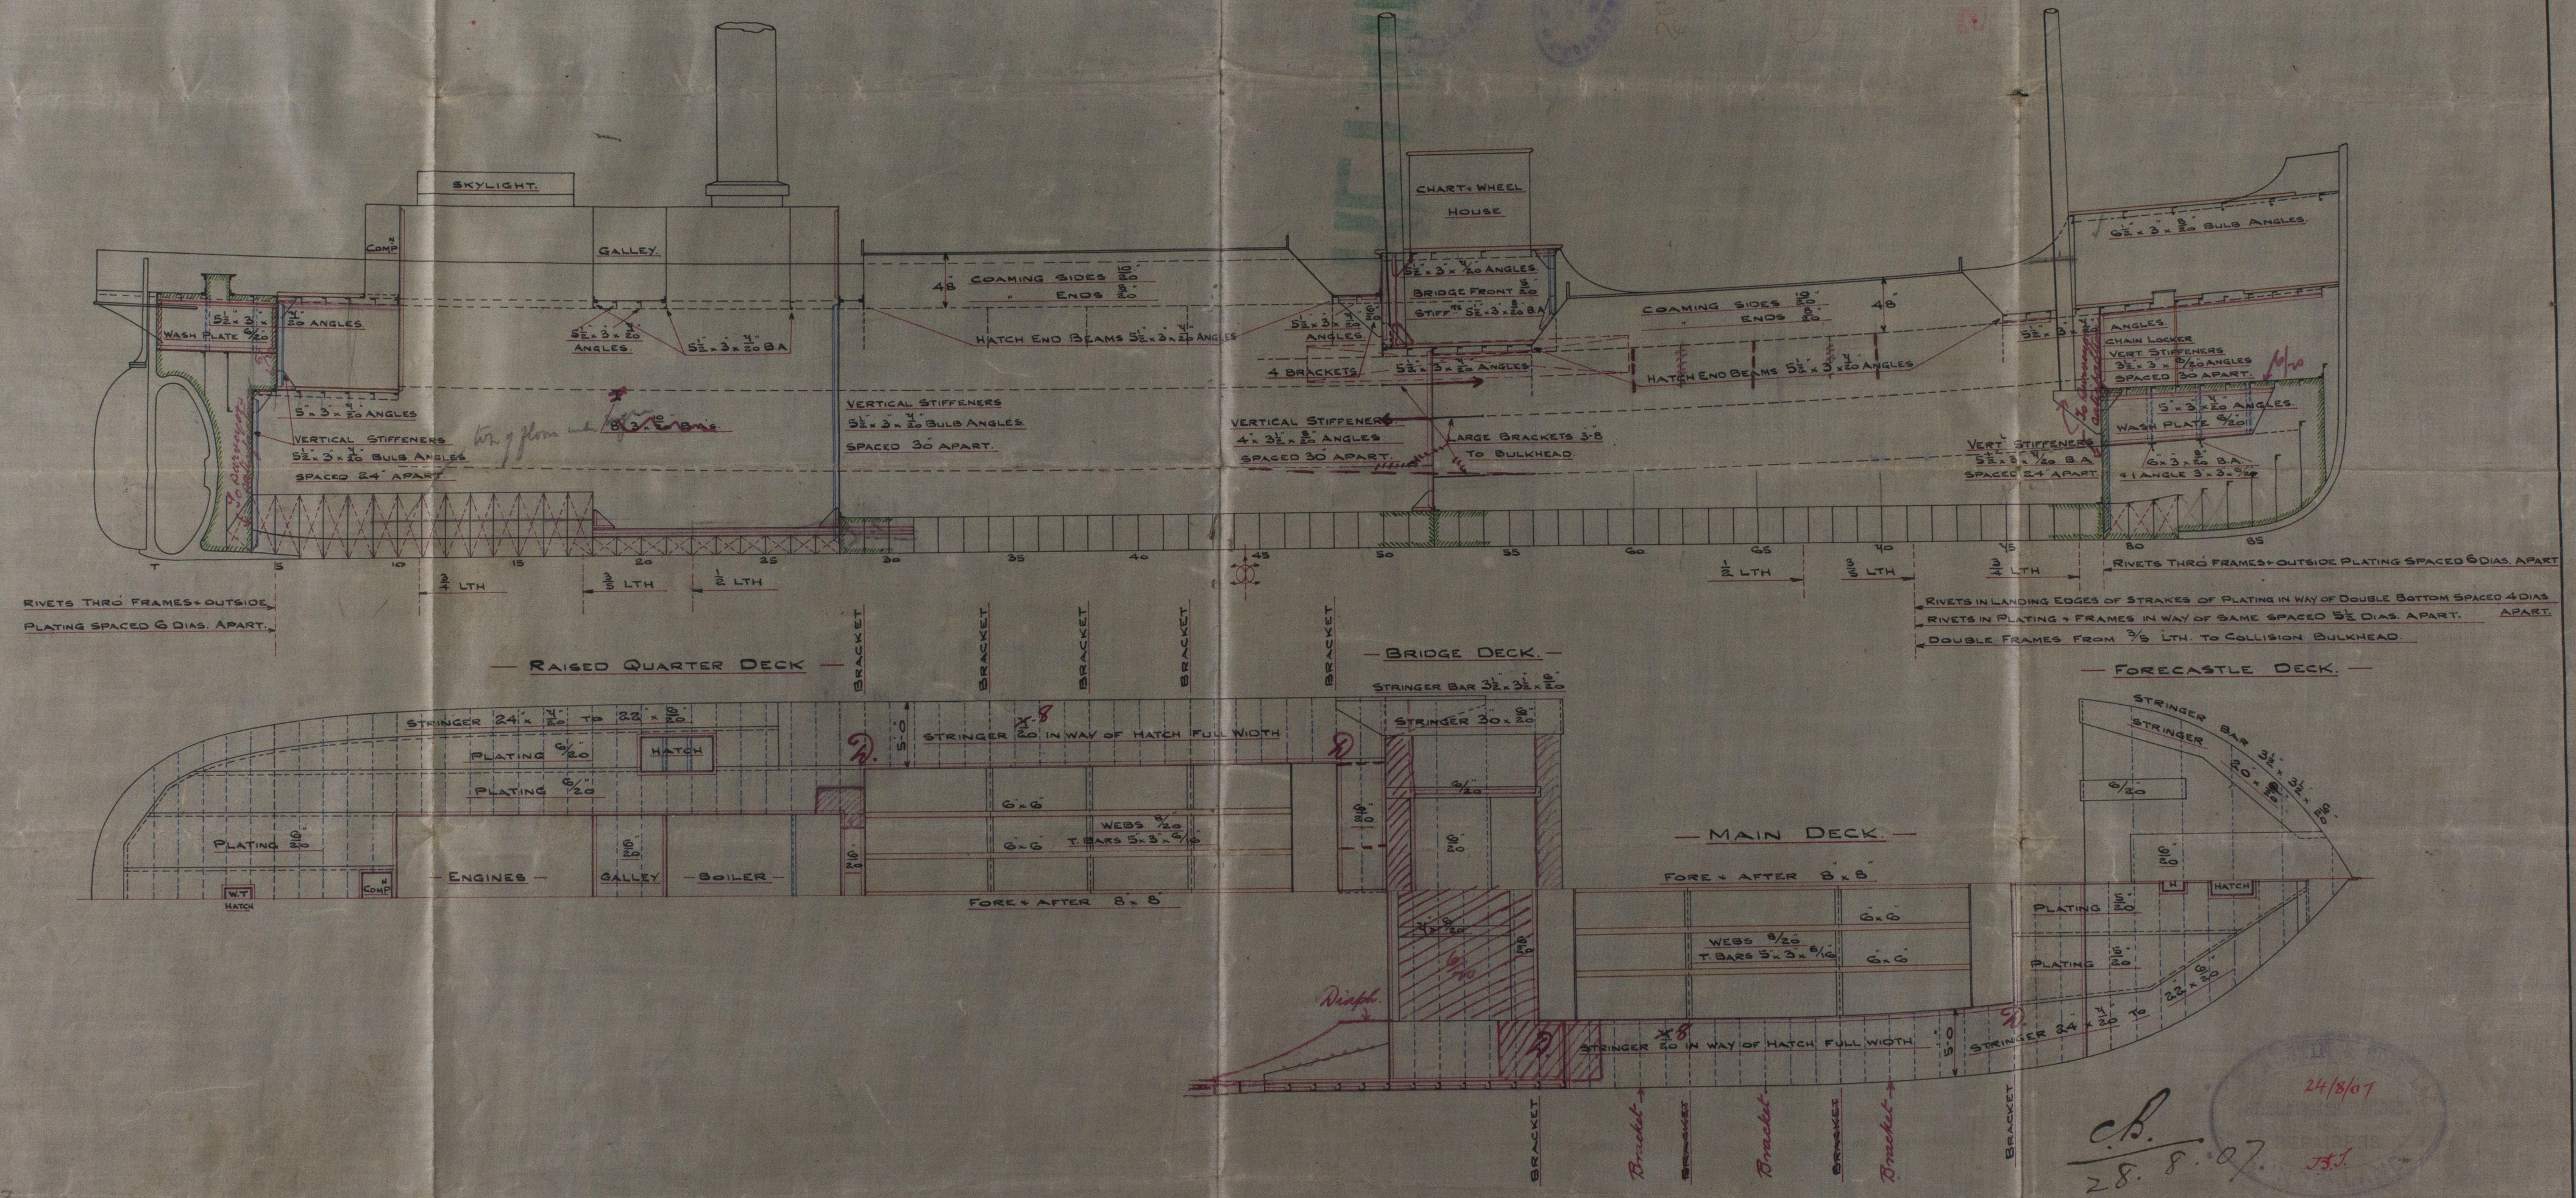

C.B.
28.8.07
24/8/07


*St Aubin
& Sons*

No 245

Profile & Deck

S.S. JOHN MILES

Slack rpt No 23589.

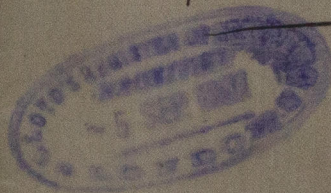

© 2021

Lloyd's Register
Foundation