

No 514-13-14

MIDSHIP SECTION.

DIMS. 130' B.P. x 22'-1" M^{LD} x 12'-10" M^{DE} - 12'-0" HOLD.

STEEL CLASS 100 A.I. (FOR FISHING PURPOSES)

SCALE 1/2" = 1 FOOT.

1/2 GIRTH. 20.16
1/2 BREADTH. 11.04
DEPTH. 13.33 1/2 N^o
44.53

128.792 LENGTH PER RULE.

8906

40077

31171

35624

8906

4453

5735-10776 2ND N^o

$\frac{L}{B} = 5.83$ $\frac{L}{D} = 9.64$

EQUIPMENT.

ONE ANCHOR 5 3/4" CNTS EX. STOCK


5 1/4" --- ---

3" --- ---

105 FTHMS 1 1/2" CHAIN.

60 --- 6" HANSE.

60 --- 5" HARR.

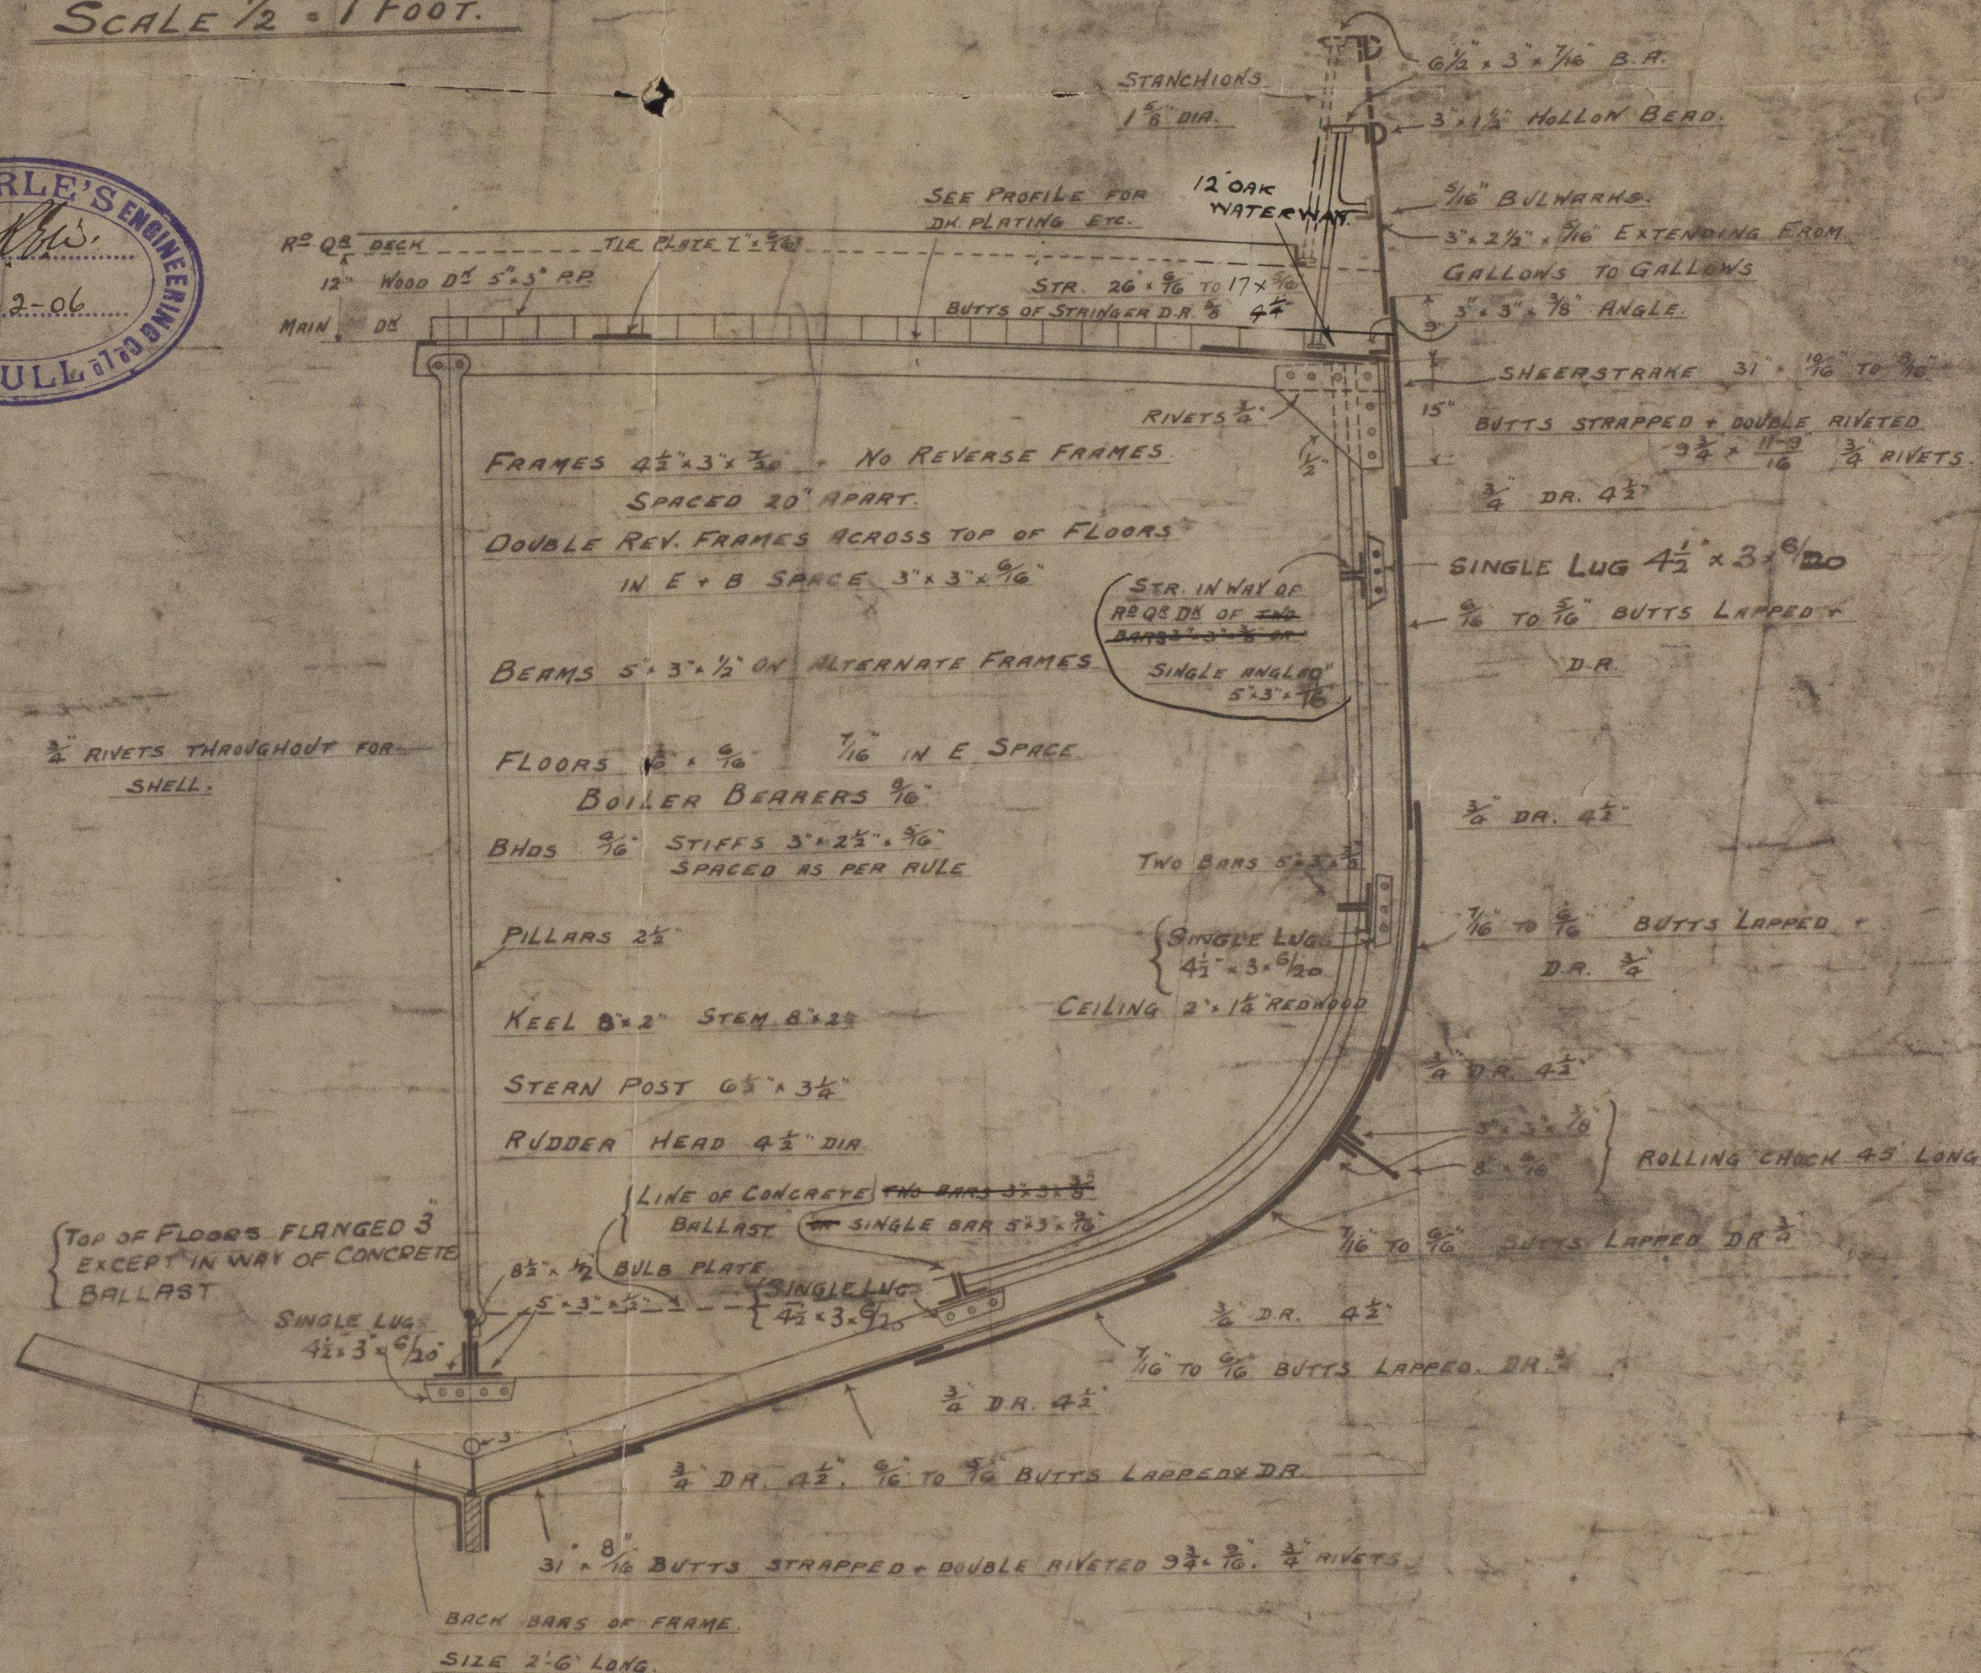

© 2020

Lloyd's Register Foundation

W 884-0137

Earle S. & E. C. Sim.

RETAIN


Nº 514.

Duplicate

Midship Section

s/s 'Gladys'

Hull Report Nº 17708

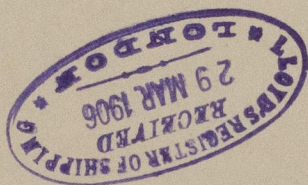

w984-0137



© 2020

Lloyd's Register
Foundation