



18.9.05

# MIDSHIP SECTION OF CARGO STEAMER.

— TO CLASS BRITISH LLOYDS 100A, STEEL —

— SCALE  $\frac{1}{2}'' = 1$  FOOT. ENGL. —

## DIMENSIONS.

LENGTH LLOYDS	167'-0"
BREADTH	28'-0"
DEPTH	14'-5"
DEPTH MOULDED	13'-10"


## NUMBERS.

$\frac{1}{2}$ BREADTH	14'-0"
DEPTH	14'-5"
$\frac{1}{2}$ GIRTH OF FRAME	26'-0"
LENGTH	167'-0"
$1.5[49.5+22.17] \cdot 7 =$	9088.14 = IV
	752.54
	9840.68 = IV.EQUIPM.

$$\frac{L}{B} = 11.6$$


## EQUIPMENT

3 BOWER ANCHORS STOCKLESS	14½ CWT. = 41¾ CWT. COLLECTIVE
1 STREAM ANCHOR EXCL. STOCK	4¼ "
1 KEDGE	" " " 2 "
195 FATH. 1½" STUD CHAIN CABLE.	
60 " 3" CIRC. STEEL WIRE.	
75 " 2¾" " " " "	
90 " 6" HEMP HAWSER	

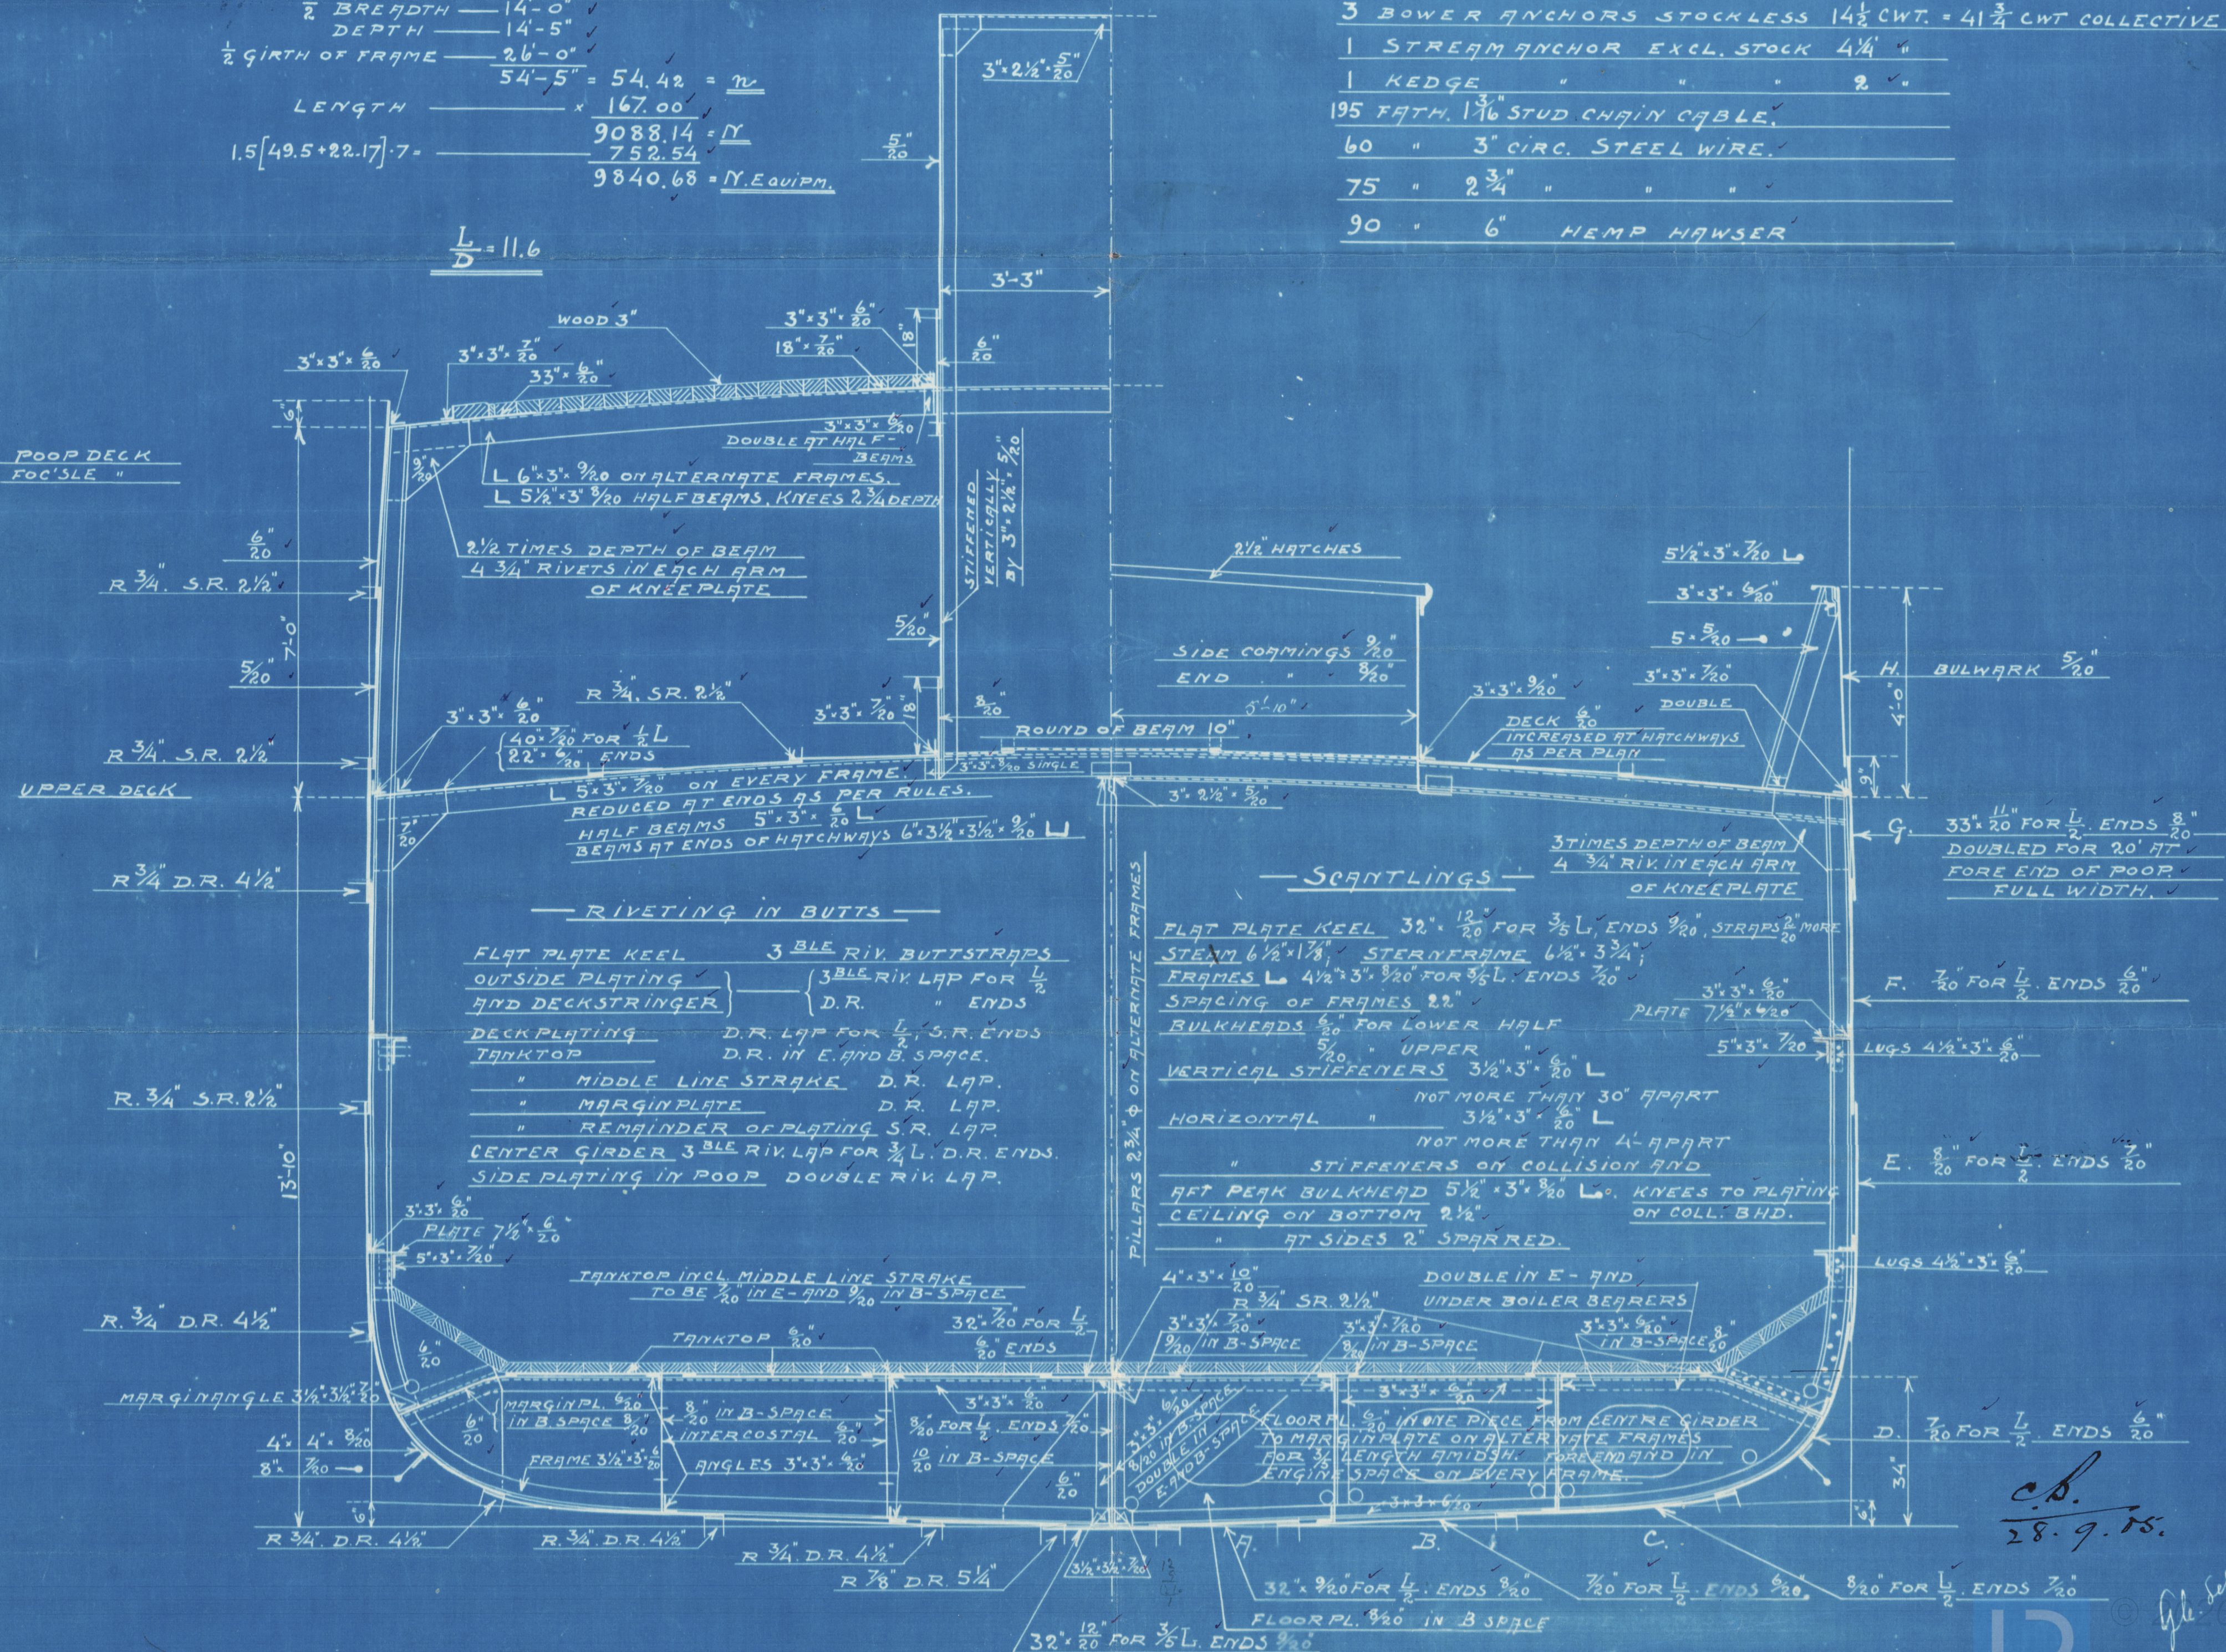

c.b.  
28.9.05.



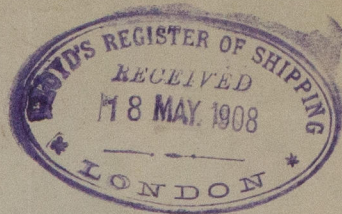

Midship Section



for

S.S. No 21

Aktiebolaget Kødöse Varf



Kødöse

(Göthenburg)

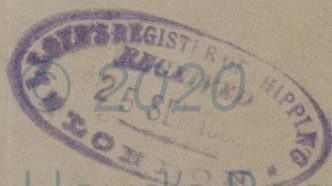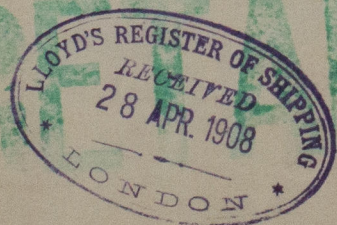

Lloyd's Register  
Foundation  
W885-0076



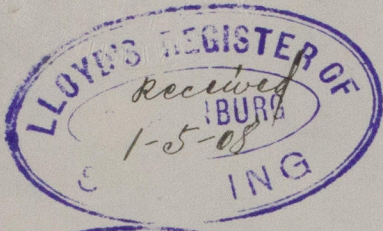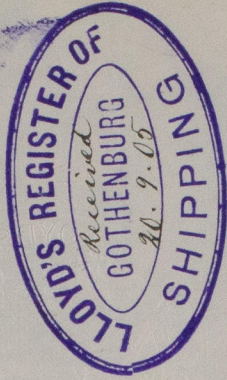

W885-0076



© 2020

Lloyd's Register  
Foundation