

# MIDSHIP SECTION.

— OF A —  
WELL DECKED SCREW STEAMER —

## DIMENSIONS.

LENGTH --- 255-0  
BREADTH MLD --- 38-0  
DEPTH MLD --- 19-6

CLASS 100. A.1.

SCALE 1/2" = ONE FOOT

Lloyds Numerals  
Breadth MLD --- 38.00  
Depth MLD --- 19.50  
Transverse No --- 57.50  
Longitudinal No --- 14662.50

Depths to length 13.07 Main Deck  
— do — 10.85 R. & Deck

## Anchors & Cables.

Equipment No 15602

1st Bow or Stock 26 1/2 cuts of Stockless 33 cut  
2nd do 26 1/2 " " do 33 " "  
3rd do 22 " " do 28 " "  
Stream or Stock 8 1/2 " "  
Ridge do 4 1/2 " "  
240 fathoms Stud Chain Cable 1 1/16  
75 do Stream Chain 1 1/16 or 4 Steel Wire


## Hawsers & Warps.

90 fathoms Towline 11 or 3 1/2 Steel Wire  
2-90 do Hawsers 6' or 2 1/2 " "  
2-90 do Warps 5' or 2 1/2 " "


Bridge Stringer Plate 4 1/2 x 34  
— do — Angle 3 x 3 x 34  
Ice plates 8 x 34  
Side plating 34  
Wood Deck 5 x 3 P.P.

Side Stringer Plate 25 x 30  
— do — Angle 3 x 3 x 30  
Plating under Windlass 30  
Side Plating 30  
Wood Deck 5 x 3 P.P.

13.10.14  
30.10.14  
5.11.14  
11.11.14

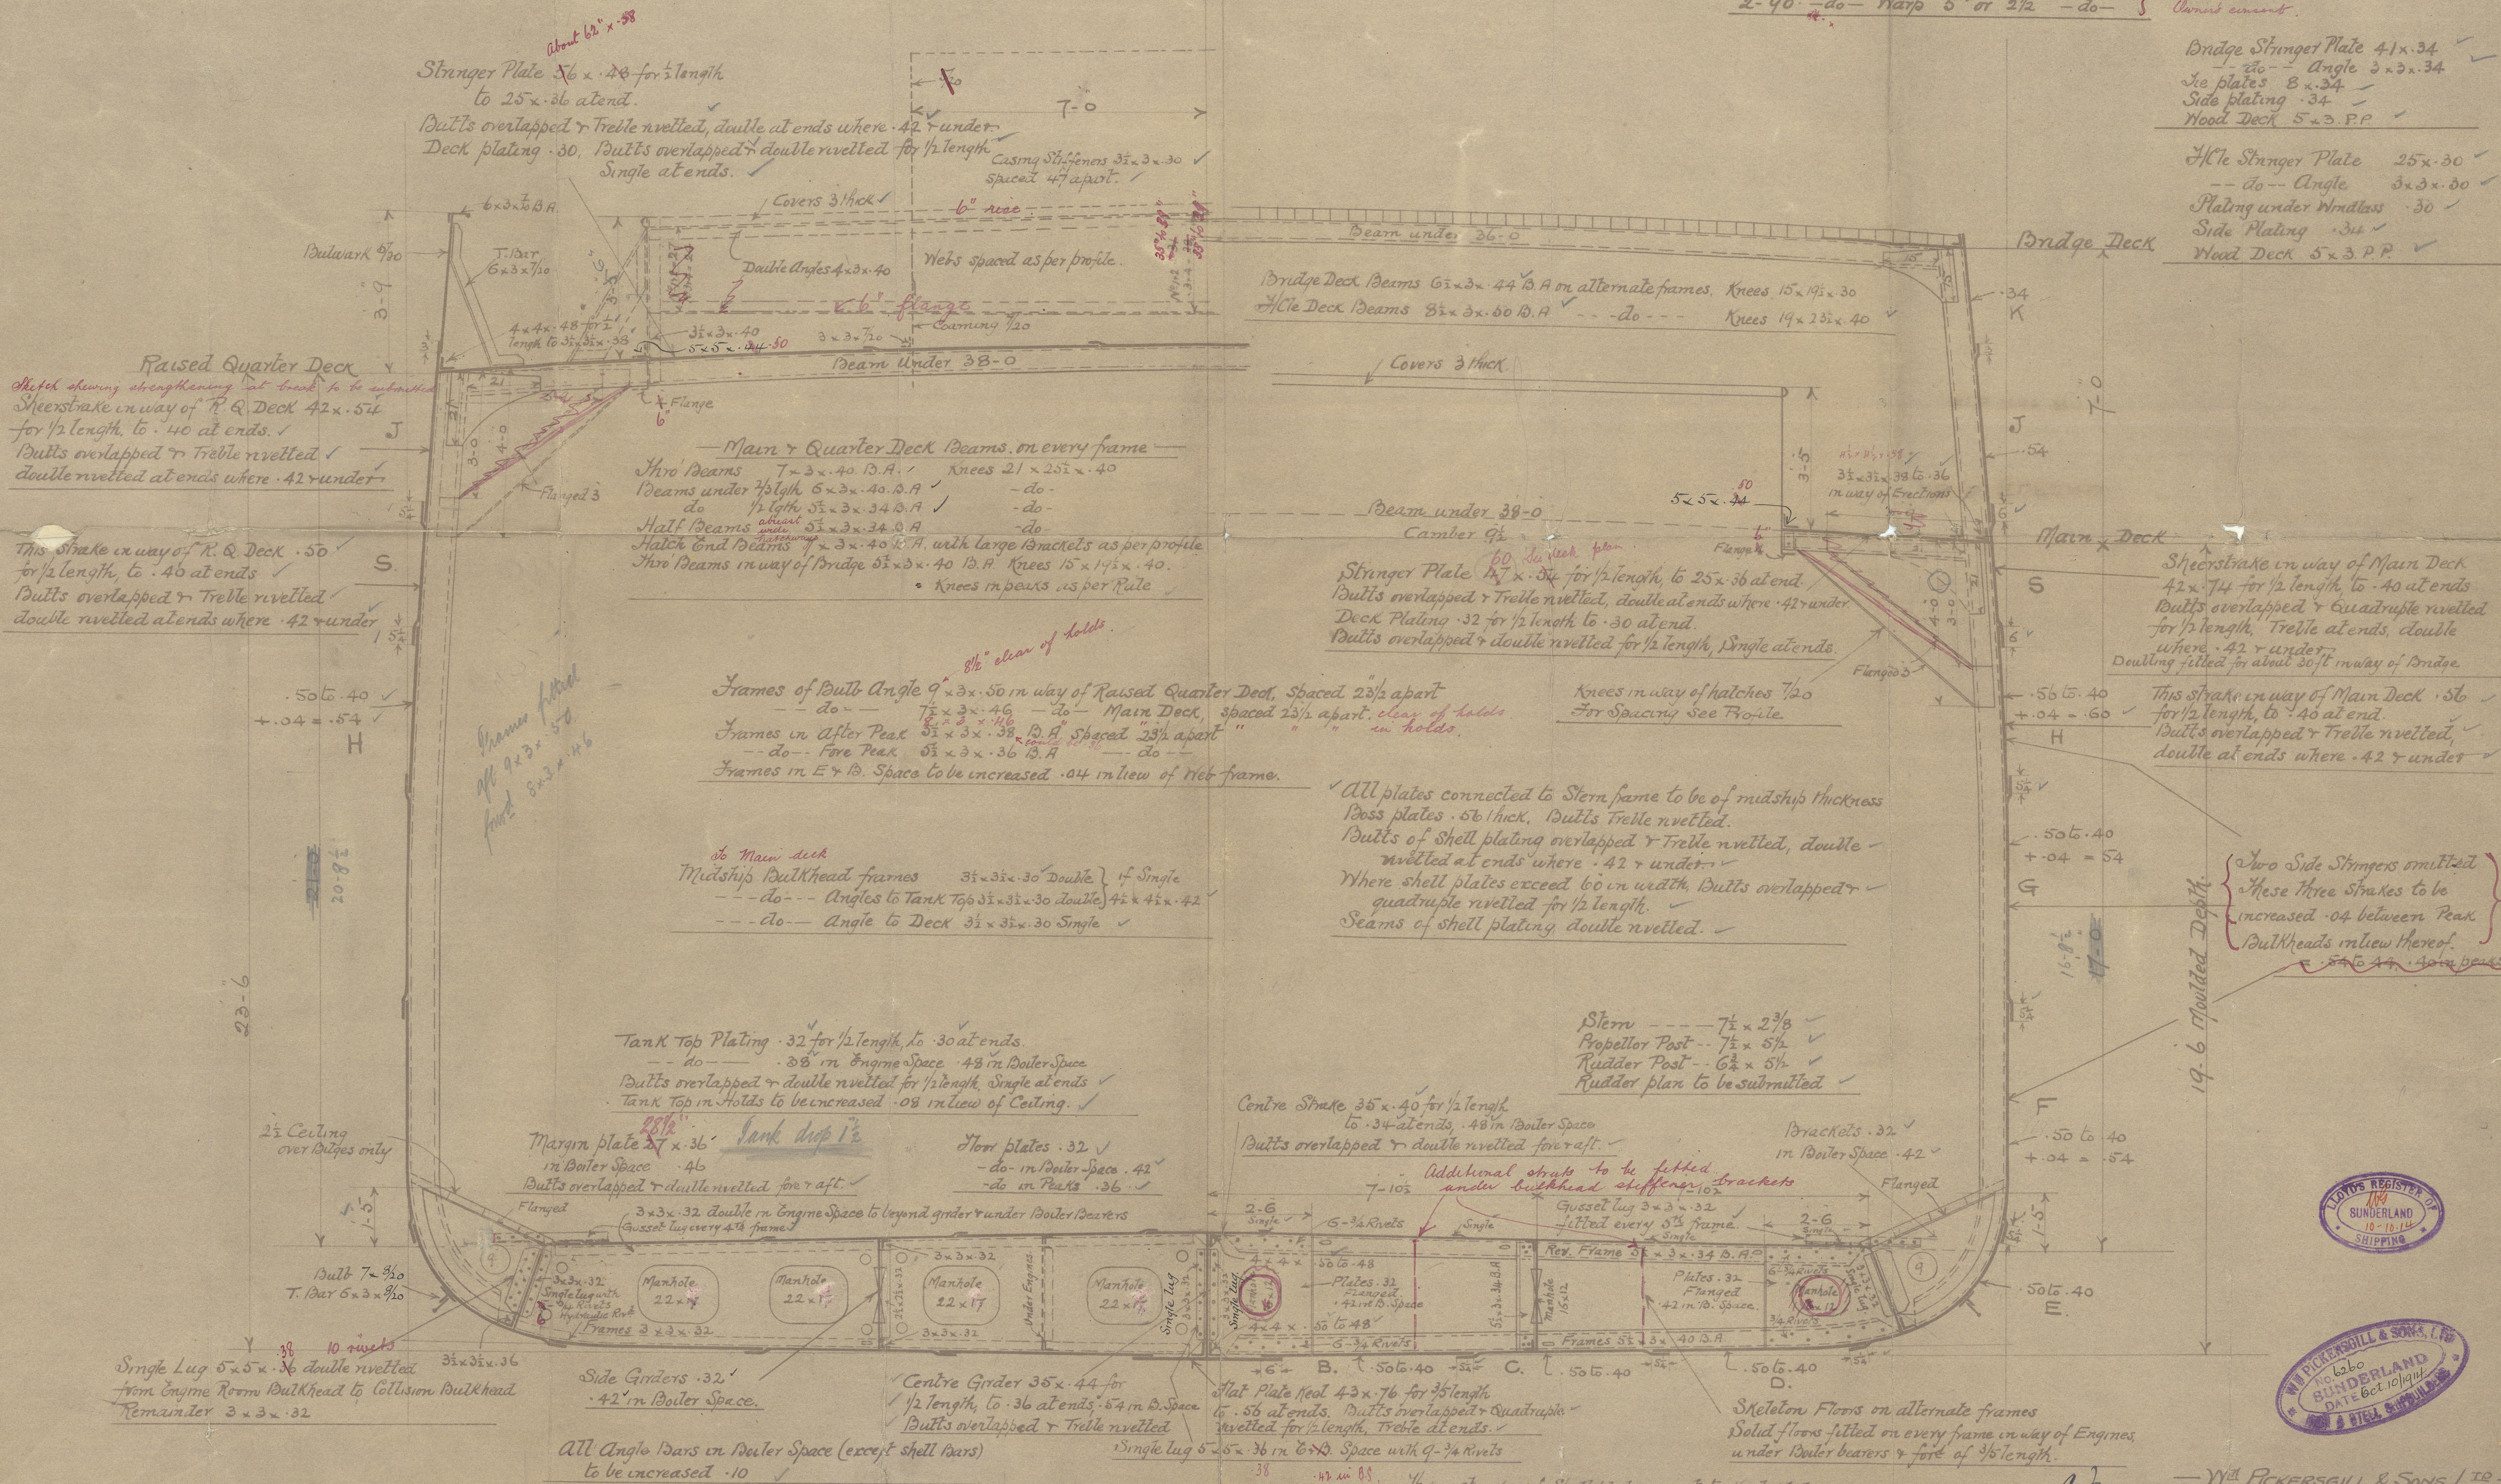

No 189.



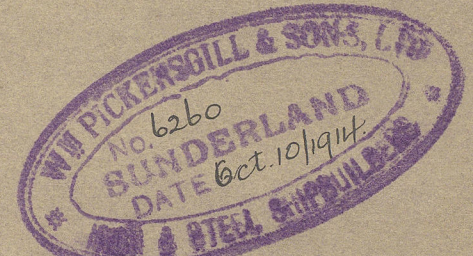


W. PICKERSGILL & SONS LTD  
+ SHIPBUILDERS 2020  
SOUTH WICK  
SUNDERLAND



Lloyd's Register  
Foundation

S. B. ELFORD  
PICKERSGILL'S N<sup>o</sup> 189

MIDSHIP SECTION  
SLO RPT N<sup>o</sup> 26476

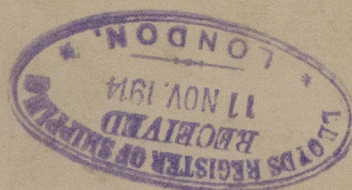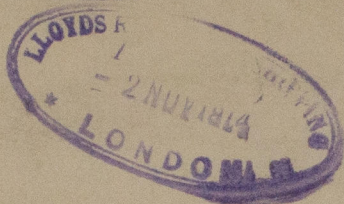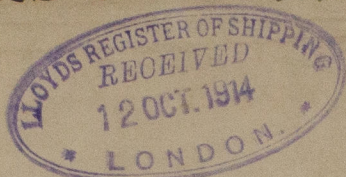

REMAIN

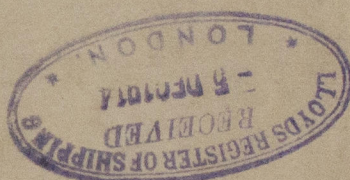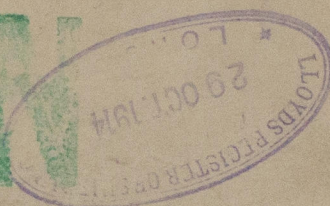

W886 - 0010

REMAIN



© 2020

Lloyd's Register  
Foundation