
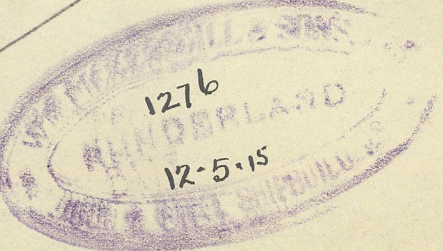


PROFILE & DECK PLANS.

SCALE $\frac{1}{8}$ " = 1 FOOT.

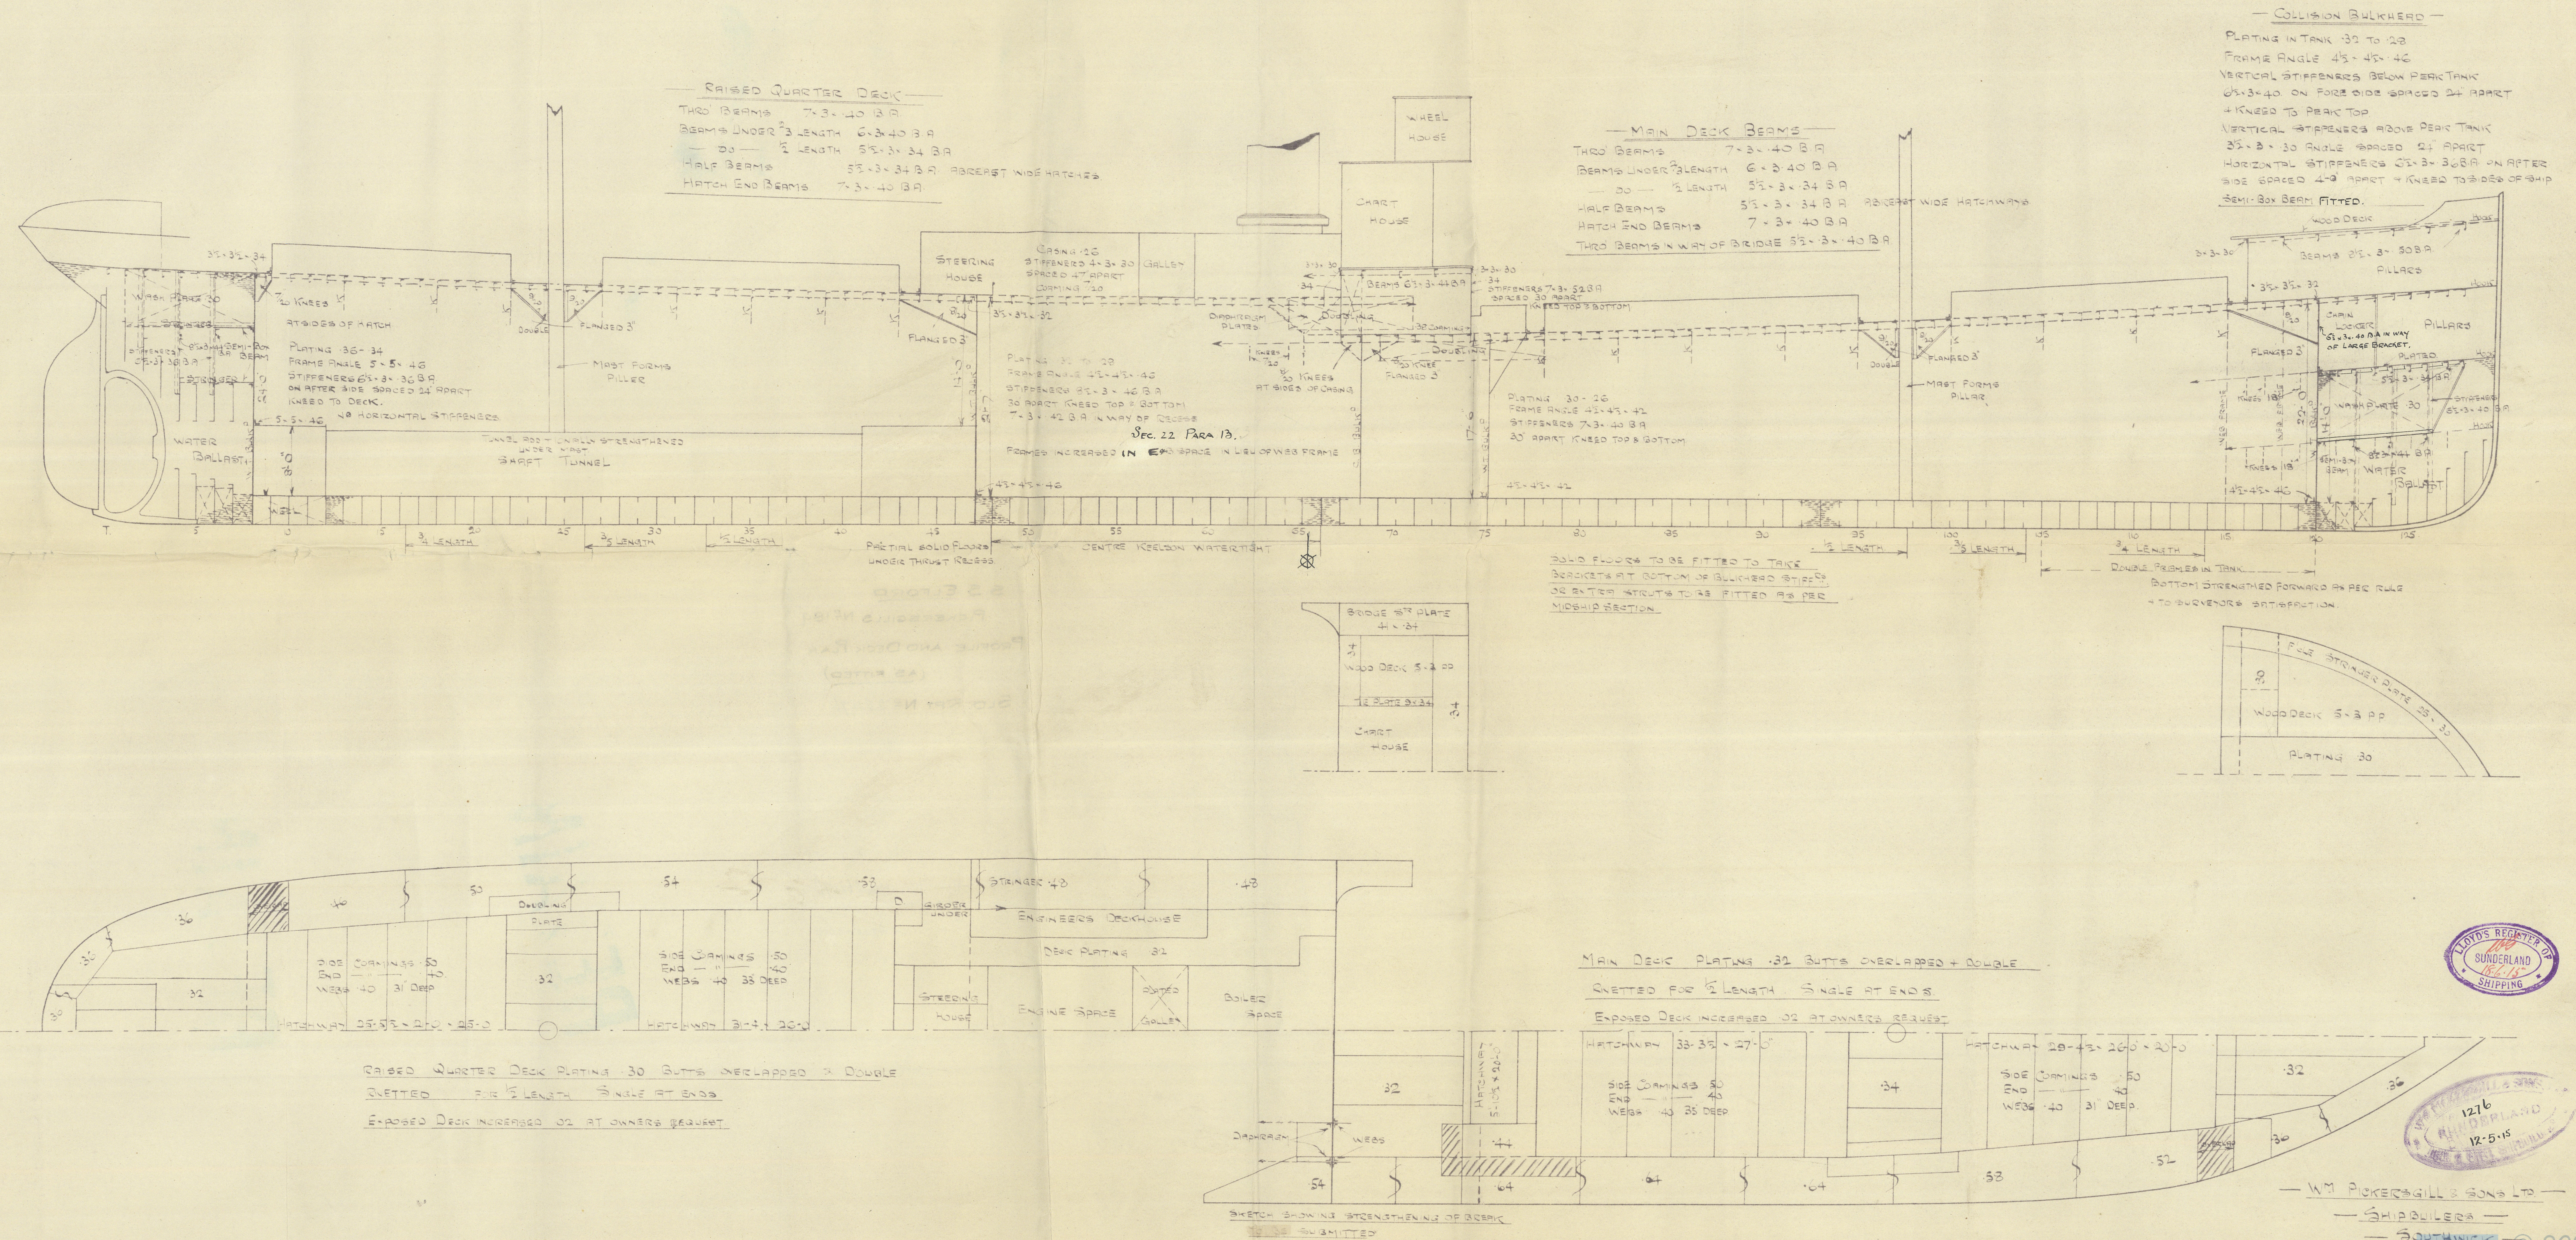

SHIPBUILDERS

SOUTHWICK
SUNDERLAND

S.S. ELFORD

PICKERSGILLS N° 189

PROFILE AND DECK PLAN

(AS FITTED)

SLO. RPT N° 26476

SUNDERLAND RPT. NO. 26476

W886-0014

REPAIR

REPAIR



© 2020

Lloyd's Register
Foundation