

22.2.09

# PROFILE & DECK PLAN.


STEEL SCREW TRAWLER.

N<sup>o</sup> 453.

DIM<sup>s</sup> 160'-0" B.P. \* 27'-0" BREADTH EX. \* 15'-0" DEPTH MOULDED.

SCALE  $\frac{1}{4}$  = 1 FOOT.

PLAN No. 3470  
FOR ENCLOSURE TO  
Messrs. Surveyors  
FROM  
DATE 19/2/09. *OK*

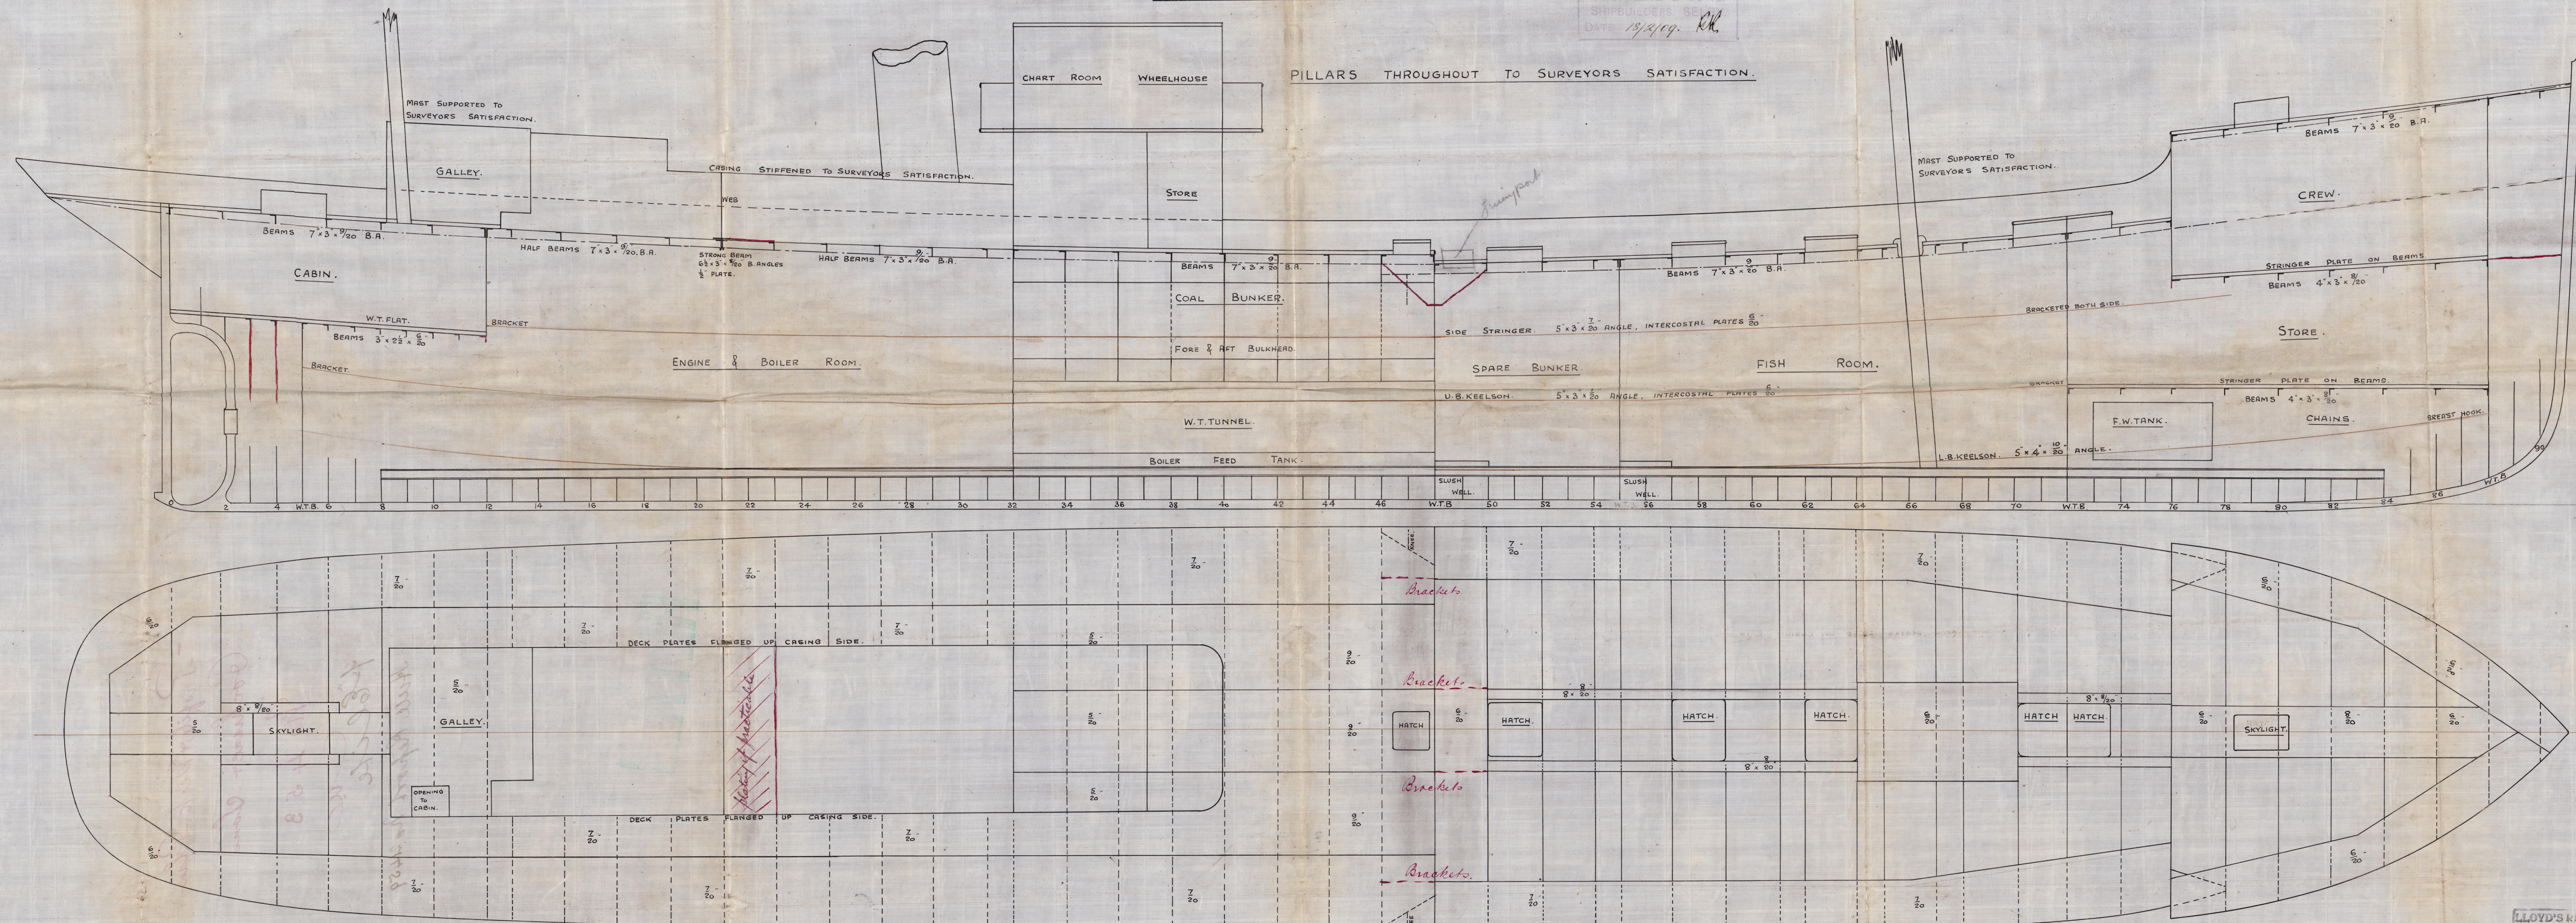

*C.B.*  
22.2.09.

LLOYD'S REGISTER  
OF SHIPPING  
19 FEB. 1909  
HULL



- Profile & Deck Plan

Cochrane & Sons

No 453

<sup>uo</sup>  
to Elite

Hull Report No. 21459

RETAIL



© 2020

Lloyd's Register  
Foundation

WAPP-0127