






21.2.14.
4.3.14
17.3.14

471 SHIP.
Nº 2087 DN
PROFILE & DECK PLANS.

380'-0" x 51'-9 1/4" x 29'-6" MLD


SCALE 1/8" = 1 FOOT

INTERCOSTAL AT WELL DECK
HATCH CORNERS

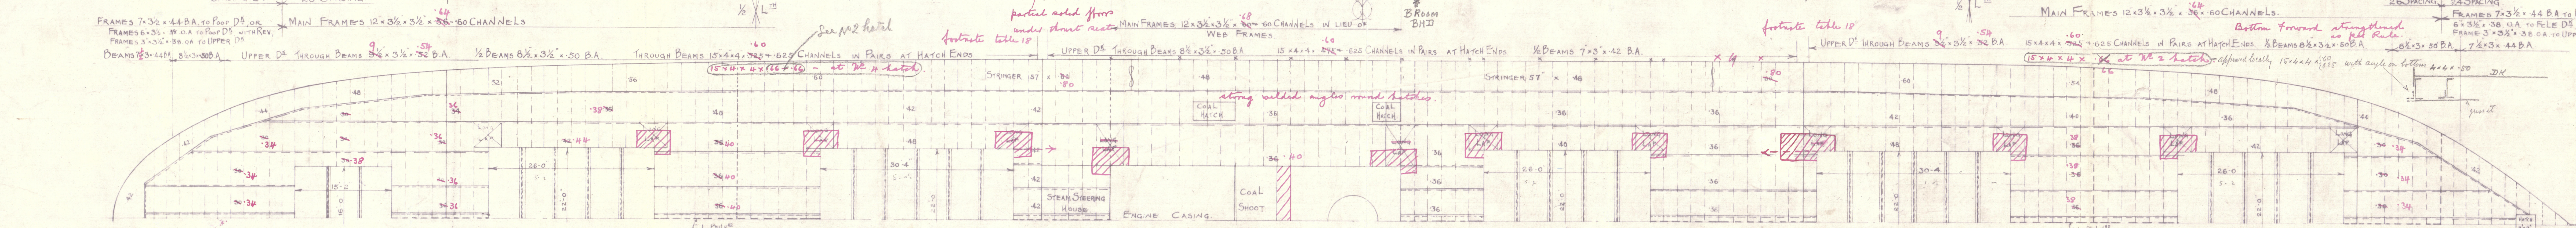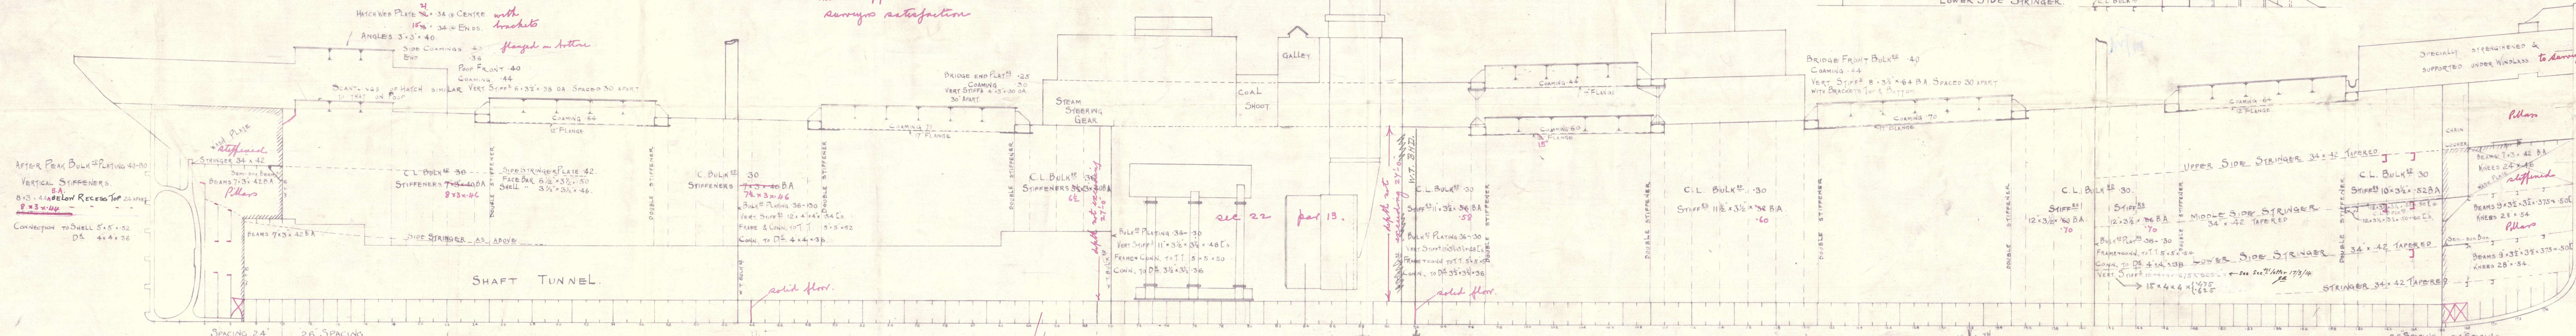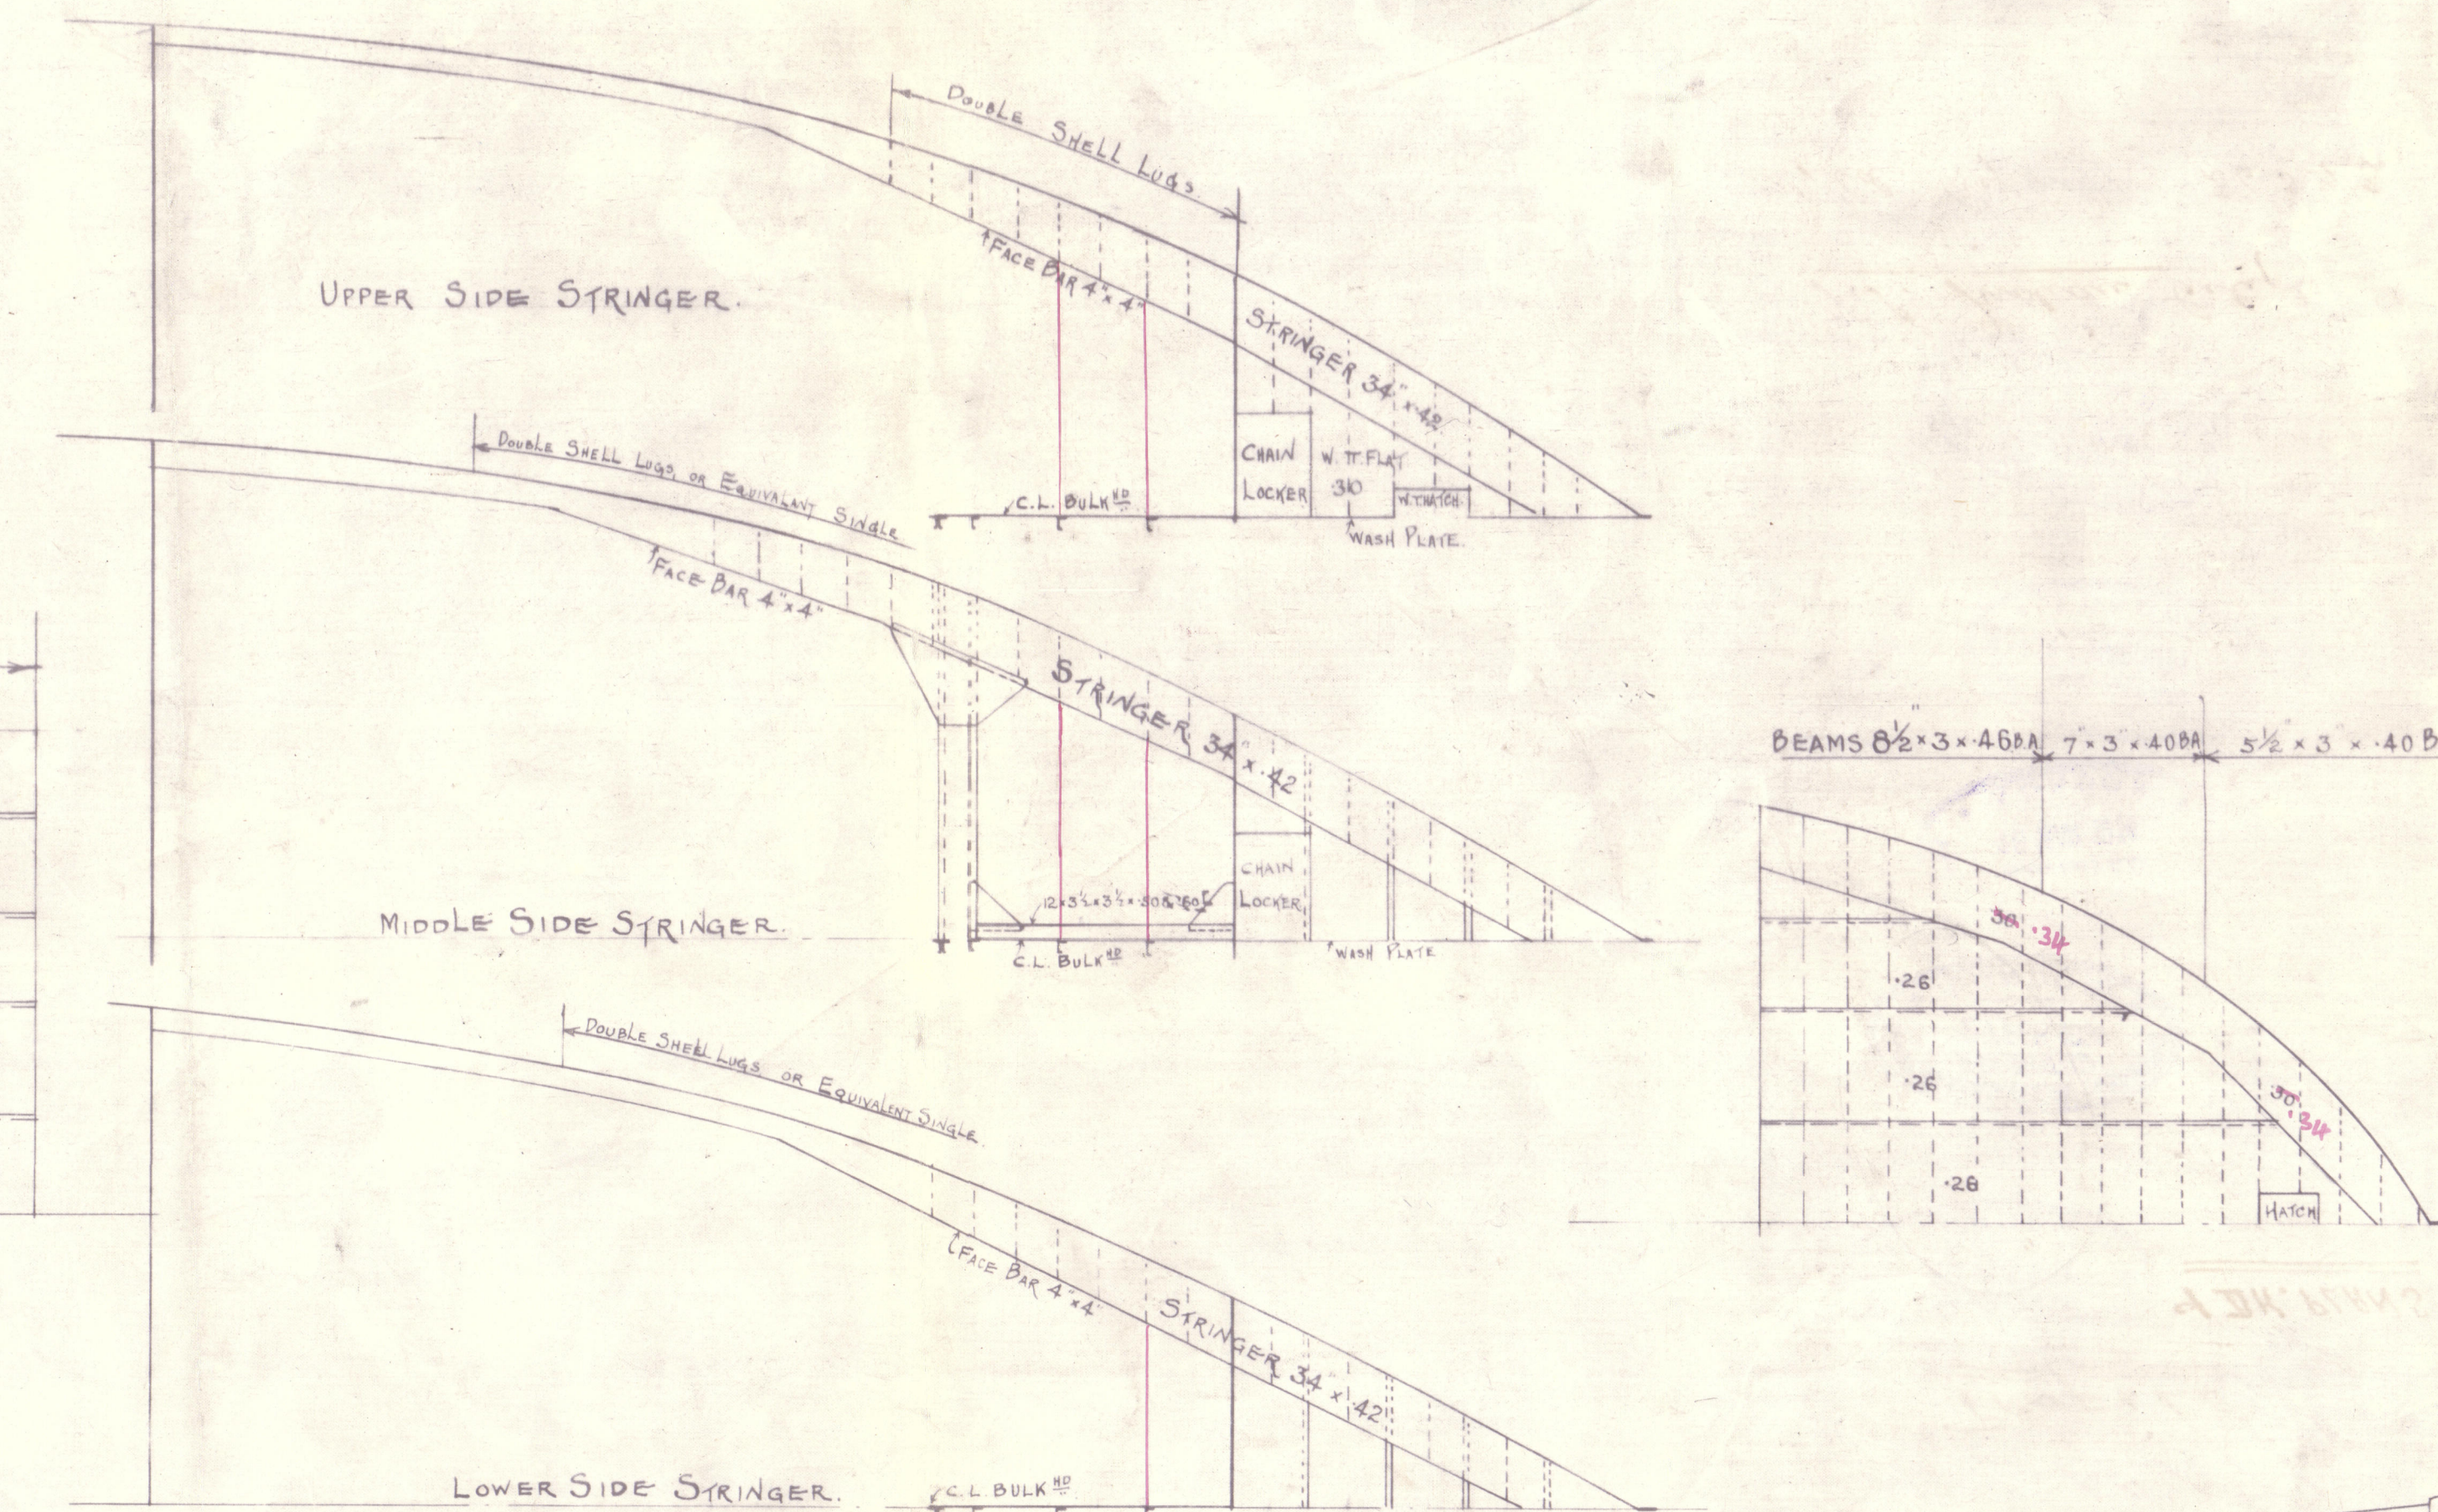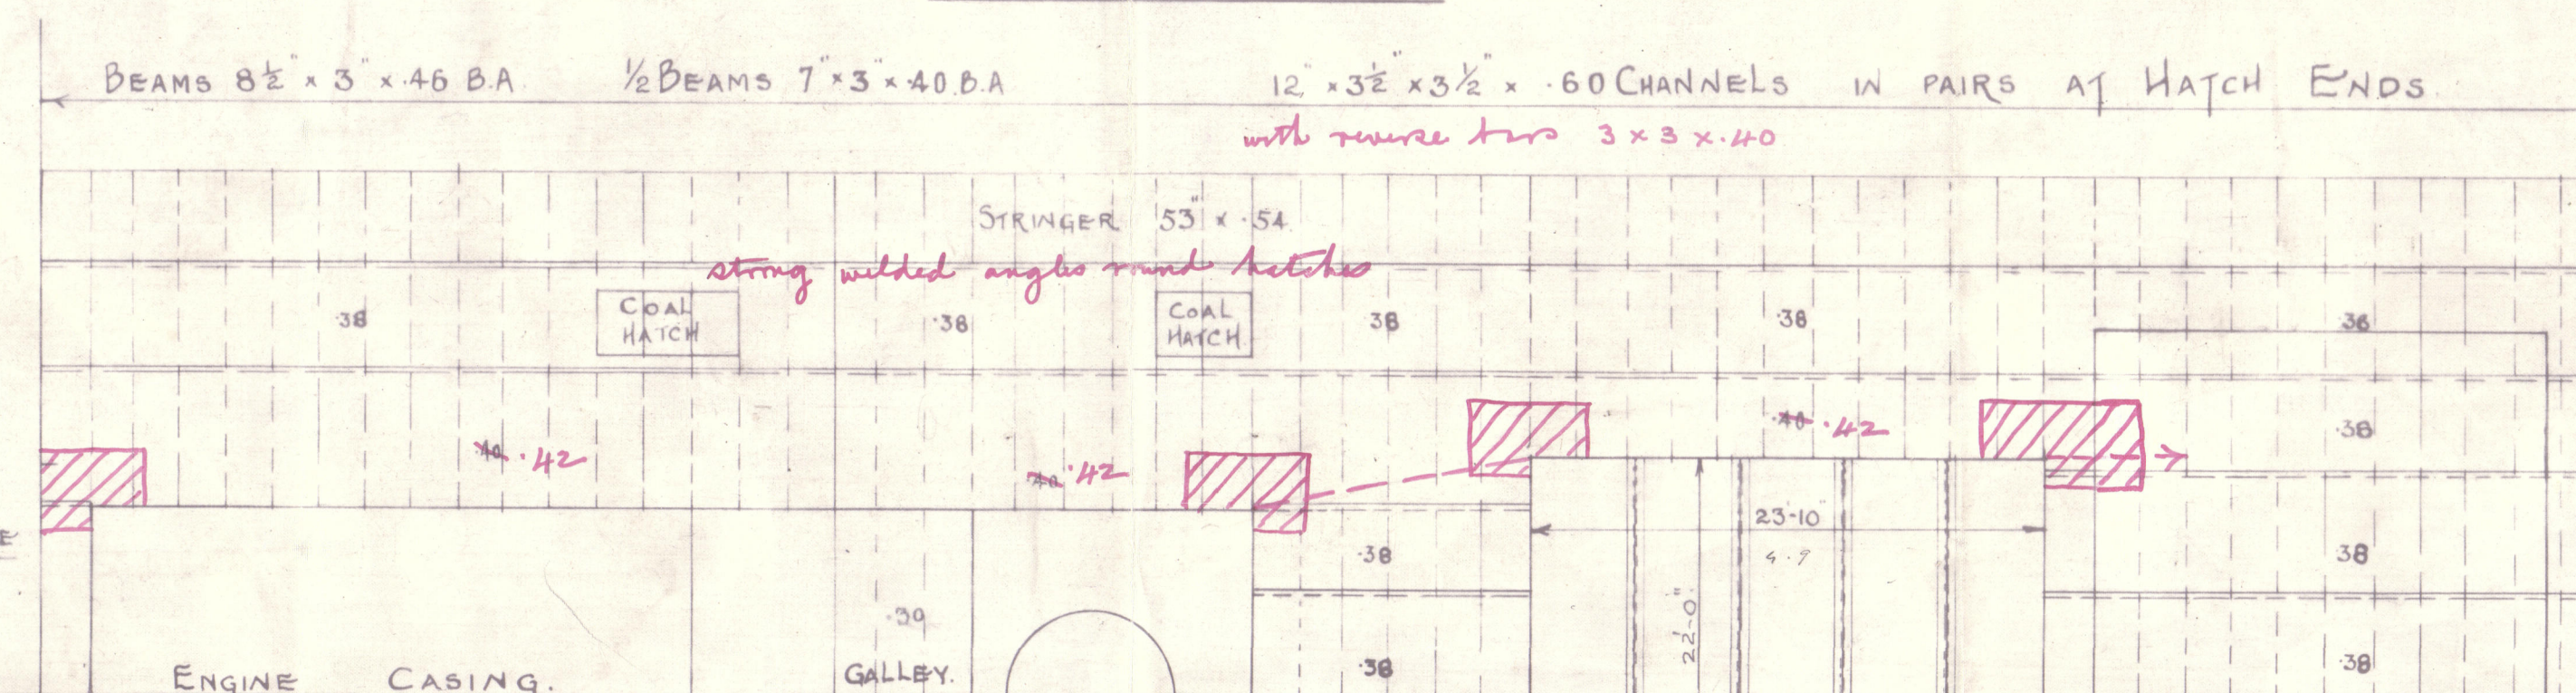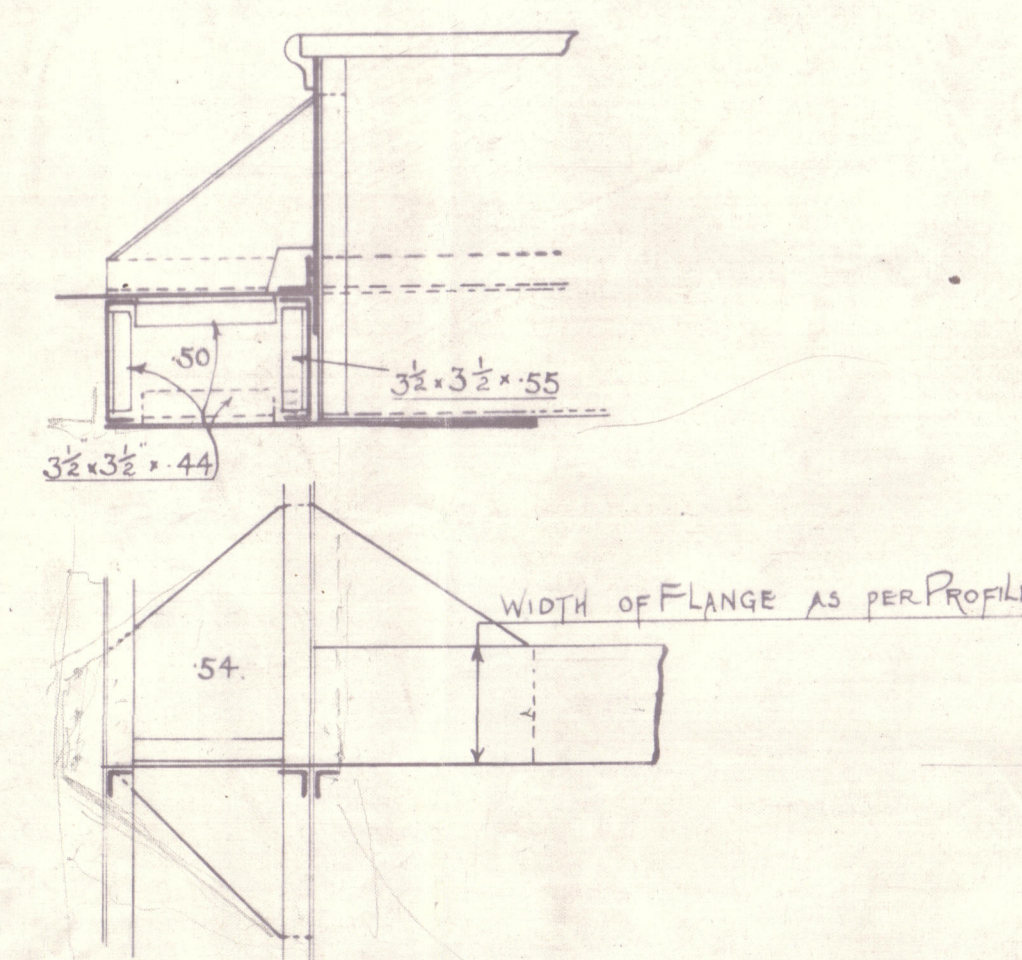

MAIN CHANNELS FRAMES INDICATED X EXTEND TO BRIDGE DECK.

21.2.14

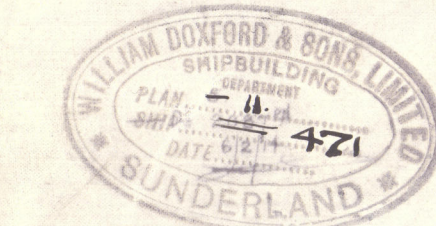

m/m

W. Doxford & Sons

~~Proposed SS~~

Nº 471

PROFILE




4 DR. PLANS



S.S. Indian City

Std. Report Nº 26343

RETAIN

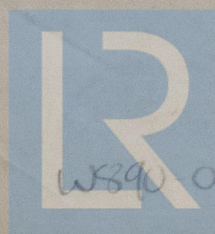

© 2020

Lloyd's Register
Foundation