


10377

STEEL BOILER N<sup>o</sup> 2259



TITLE *Steel Boiler*  
FOR VENDOR  
DATE *11/8/12*  
ORDER *2259.*  
IF MADE *Yes*  
SOLE *1 foot*  
*W890-016 1/2*

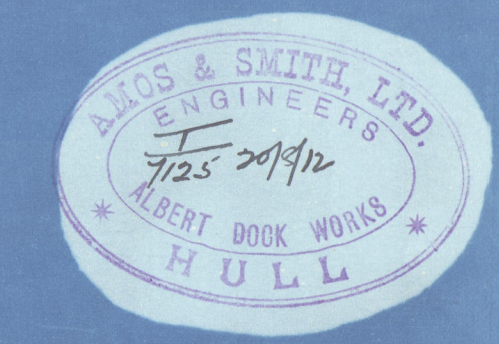

LLOYD'S REGISTER  
OF SHIPPING.  
22 AUG 1912  
HULL



From AMOS & SMITH, Ltd., HULL.  
Enclosure for

Lloyds Surveyors  
Hull

W 890-046  $\frac{2}{3}$



Amos Smith

Box No.


2259.

AMENDED

W. P. = 200 LBS

J. Inawilliam

Hull Report No: 26608.

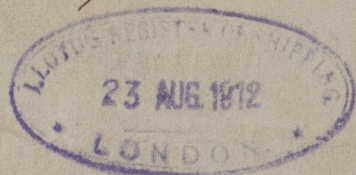

RETAIN

W890-046



© 2020

Lloyd's Register  
Foundation