


25'6" Hatchway
2nd deck.



29'9" Hatchway; 2nd deck.

№ 838
PROFILE AND DECK PLANS
DIMENSIONS 330' O.P.P. x 50'6" EXT x 30'4" MLD TO UPPER DECK
TO CLASS 100A1 AT LLOYD'S
SCALE 1/8" = 1 FOOT.

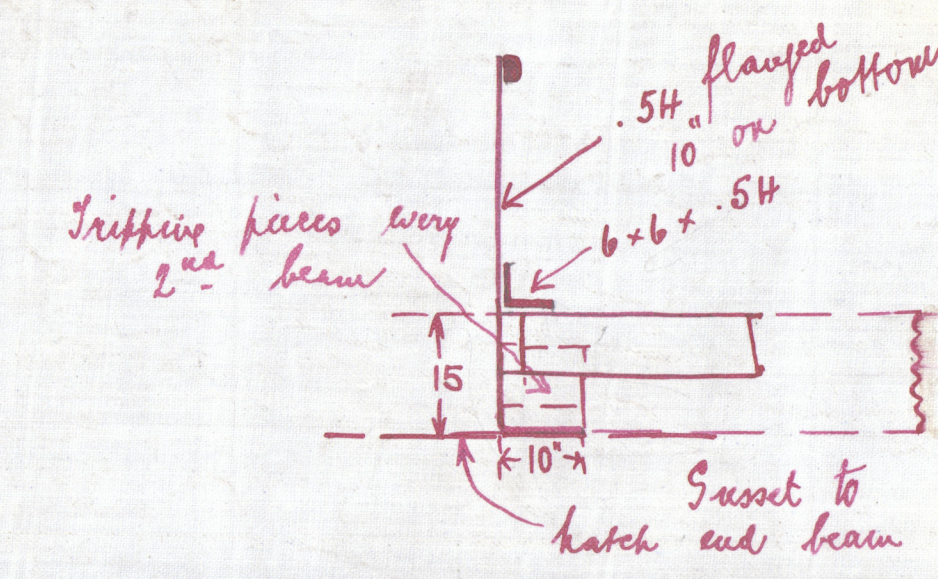

29'9" Hatchway, upper deck.

25'6" Hatchways: upper deck.

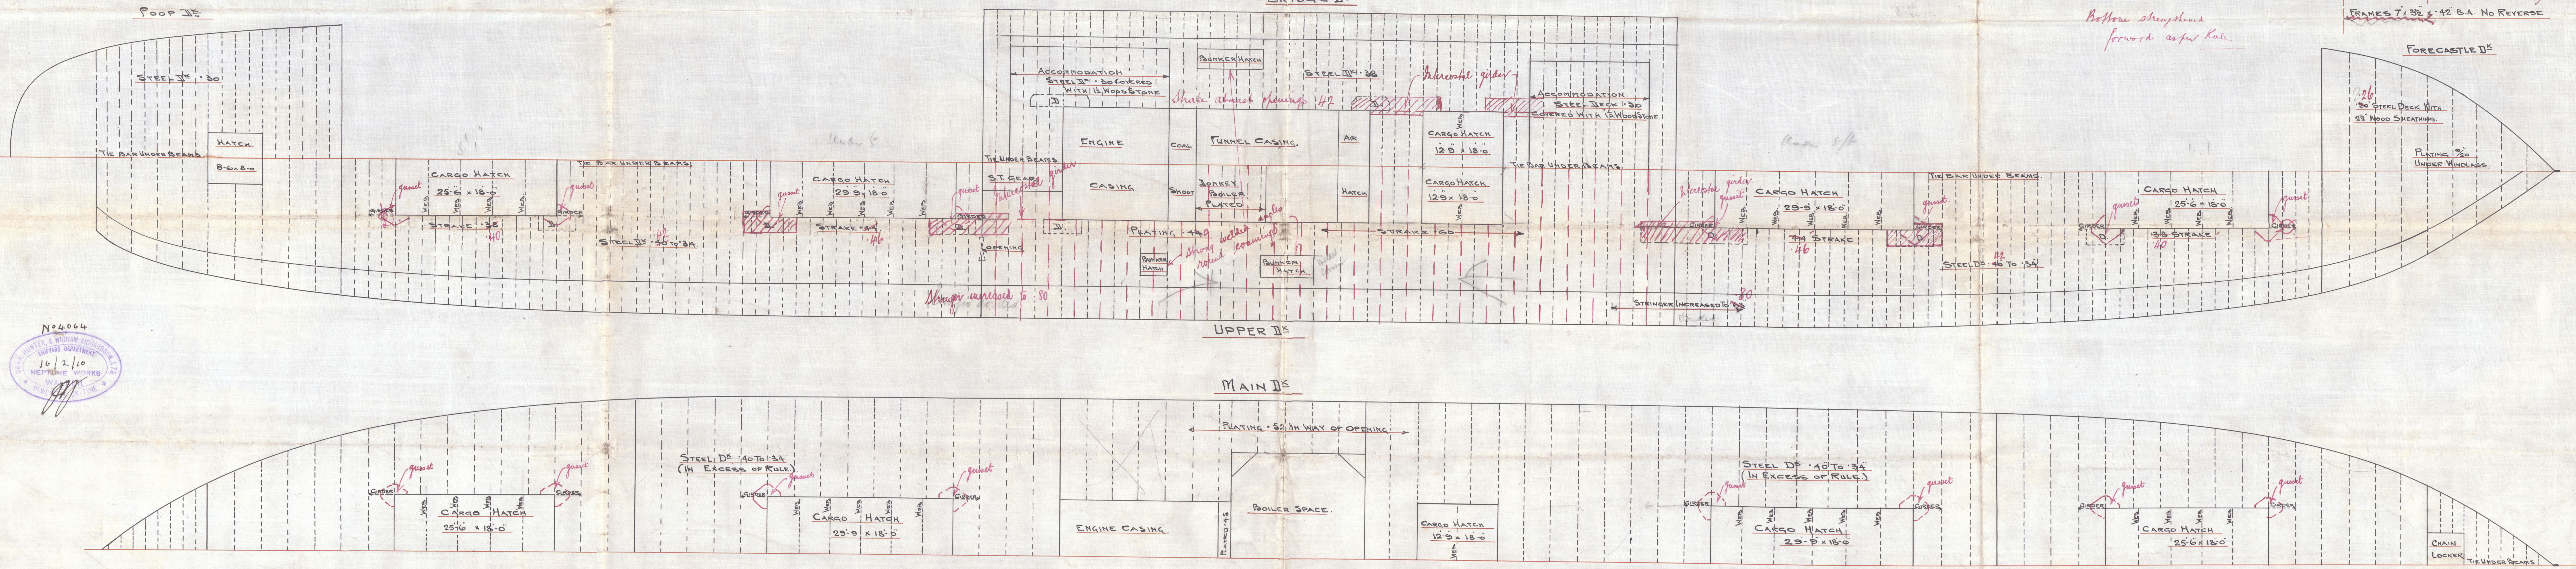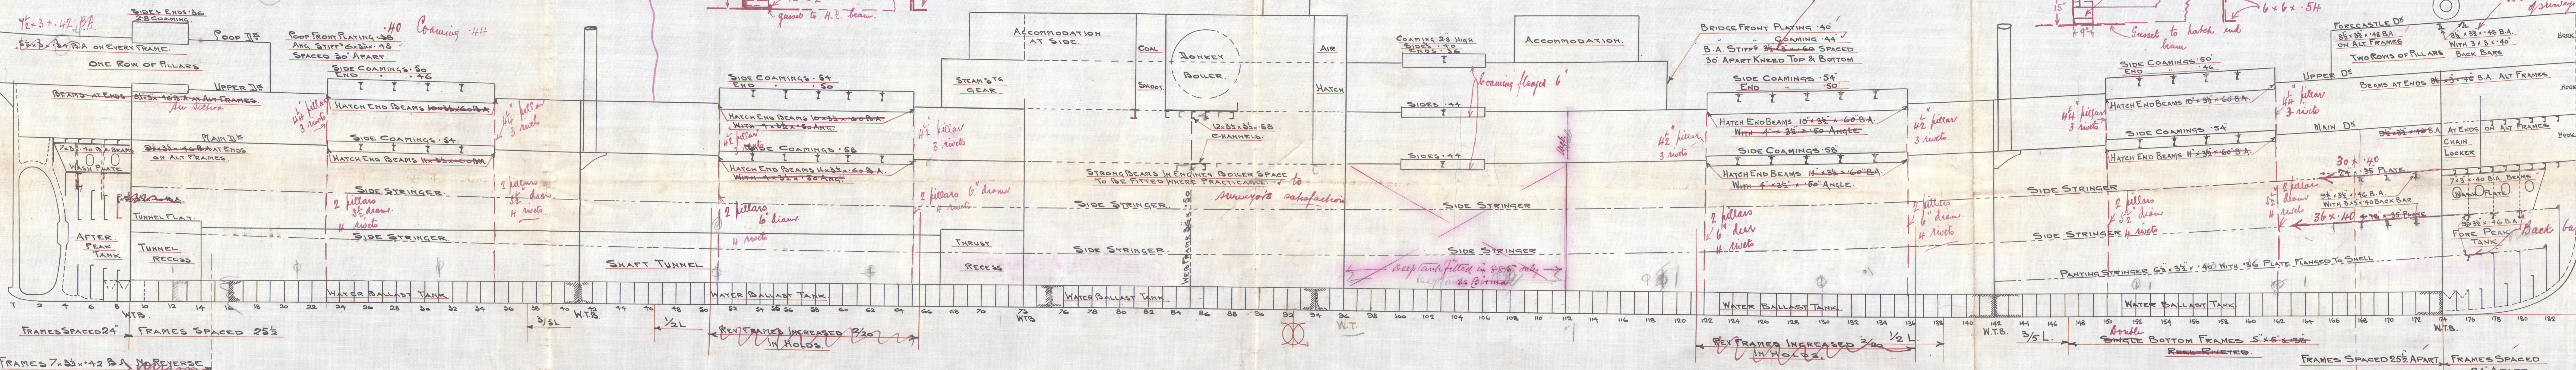

№ 4064
16/2/10

Messrs Swan Hunter &
Wigham Richardson Ltd

S.S. 838885

Profile & Deck plans



S.S. "HARMATTAN"


NEWCASTLE ON TYNE

REPORT No 09555

S.S. "BIRMA"

NEWCASTLE - ON - TYNE.

REPORT No 61988

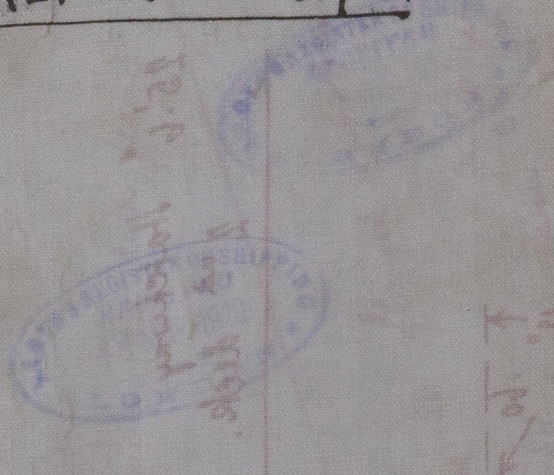

RETAILED

W891-0044



© 2020

Lloyd's Register
Foundation