

25.11.09
10.1.10
23.2.10

PROFILE

Scale 1/8" = 1 foot

Beams marked A. Plating 15' x 50. 2 angles 6' x 6' x 50. Knees = 3' 6" x 50 at Bridge & 4' 0" x 50 at upper & 2' 6" x 50 at lower.
B. Bulbs 10' x 50. 2 " 3 1/2' x 3 1/2' x 34. Knees 27' x 54 or 11' x 3 1/2' x 56. Built Ang.
C. " 12' x 54. one " 6' x 4 1/2' x 54 " 26' x 54
D. " 12' x 64. one " 6' x 4 1/2' x 70 " 29' x 54
Gussets fitted to surveyors satisfaction.

Bridge Deck & Beams = 9 1/2' x 3 1/2' x 50. Built Angs. Knees = 22' x 42
" " " = 7 1/2' x 3' x 42 " " " = " "

Note. No Pillars at Hatch Sides in Holds, Main or Bridge Deck.

2nd Deck Beams.
Midship Beams. Built Angs 11' x 3 1/2' x 58. Knees = 25' x 46
Half " " 9' x 3' x 46 " " " = " "
Beams in Peaks " " 7' x 3' x 40 " " " = 23' x 42



upper Deck Beams.
Midship Beams. Built Angs. 9 1/2' x 3 1/2' x 50. Knees 22' x 42
Half " " 7 1/2' x 3' x 42 " " " = " "
Beams in Peaks " " 6 1/2' x 3' x 40 " " " = " "

Note. No Hatch Sides in Holds, Main or Bridge Deck.
Wood covers fitted in soft.

Deck Plating doubled at corners of
Hatchways and large openings.

Beams marked A. Plating 15' x 50. 2 angles 6' x 6' x 50. Knees = 3' 6" x 50 at Bridge & 4' 0" x 50 at upper & 2' 6" x 50 at lower.
B. Bulbs 10' x 50. 2 " 3 1/2' x 3 1/2' x 34. Knees 27' x 54 or 11' x 3 1/2' x 56. Built Angs.
C. " 12' x 54. one " 6' x 4 1/2' x 54 " 26' x 54
D. " 12' x 64. one " 6' x 4 1/2' x 70 " 29' x 54
Gussets fitted to surveyors satisfaction.

Poof Deck Beams = 8' x 3' x 42. Built Angs. Knees = 19' x 40.

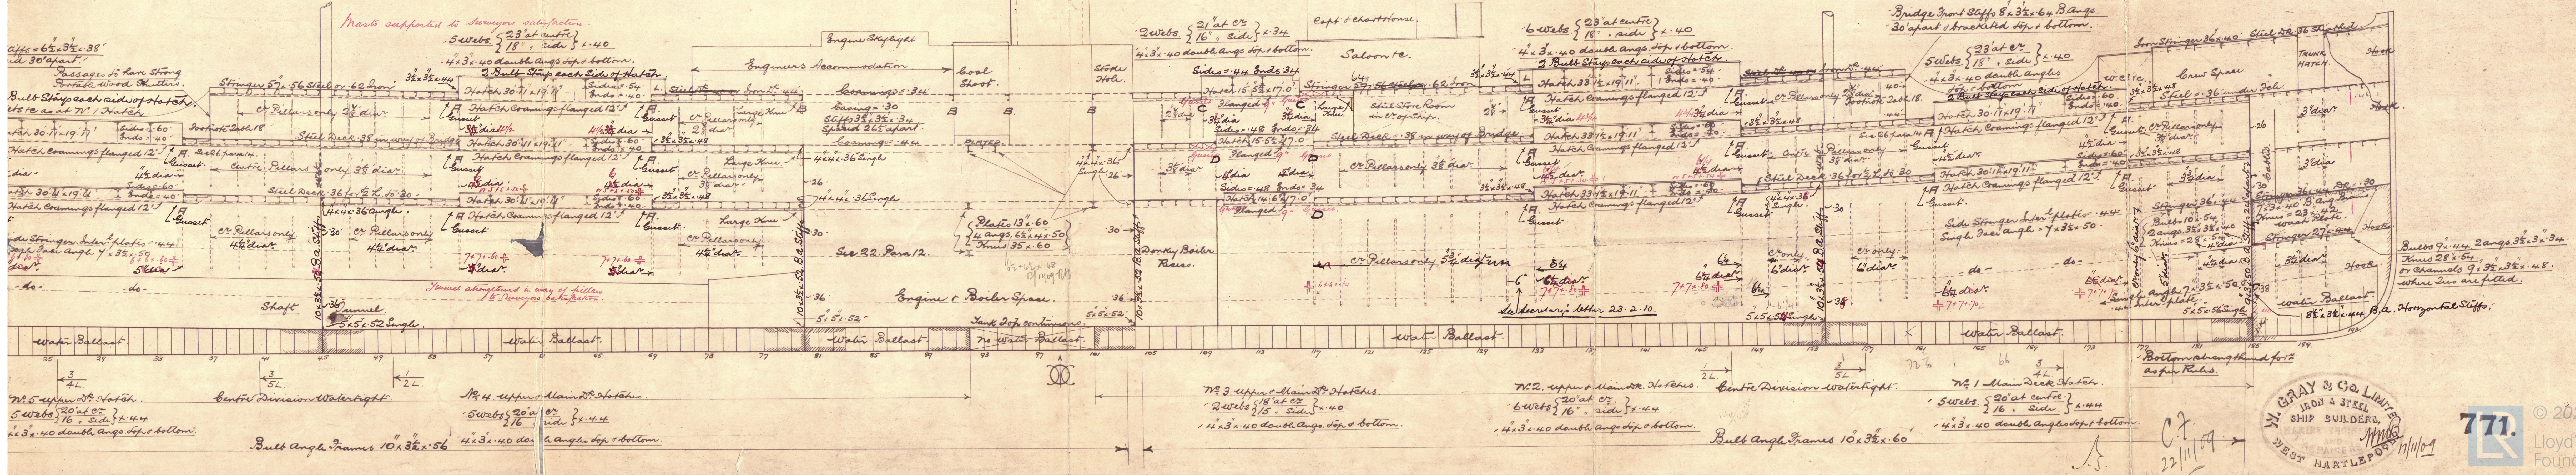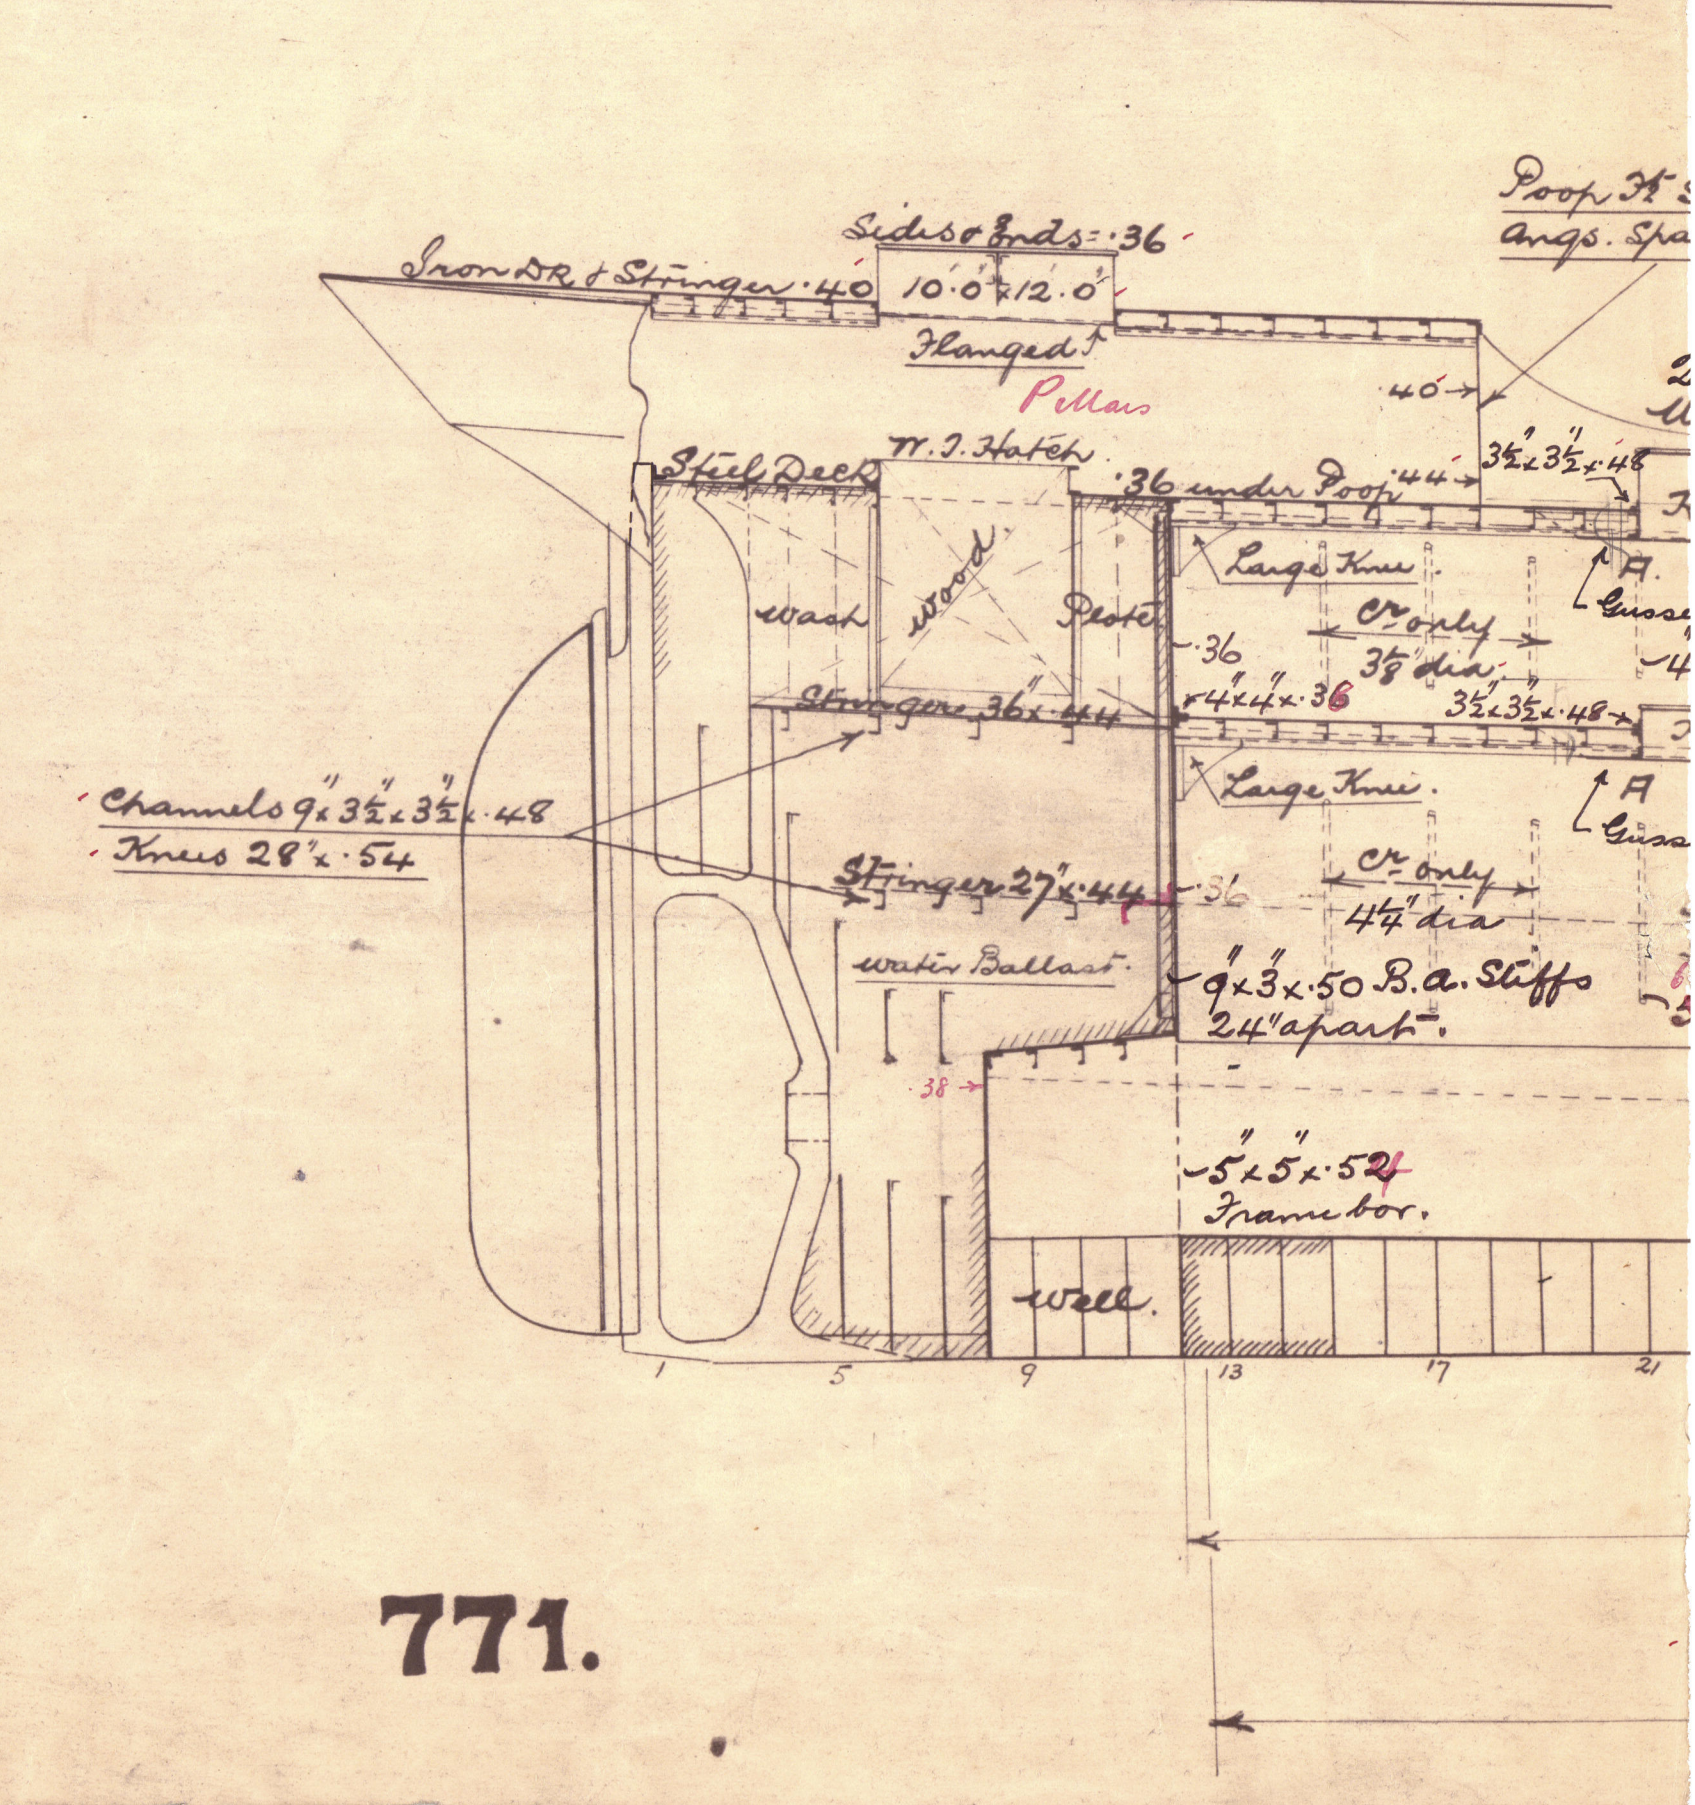

771.

W. GRAY & CO. LTD.
IRON & STEEL
SHIP BUILDERS
WEST HARTLEPOOL






W Gray & Co Ltd

No 771

Profile

S.S. 'Kantagius'

Apr Report: No 13939

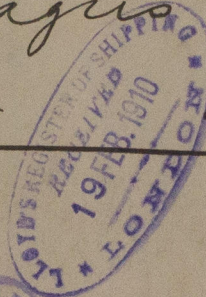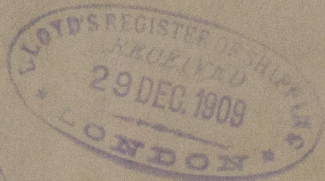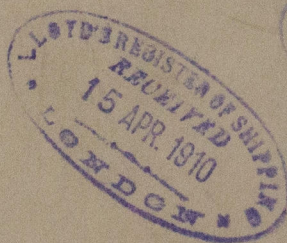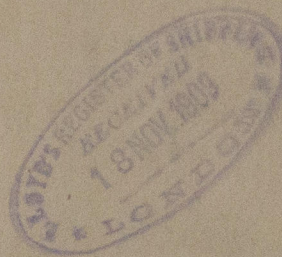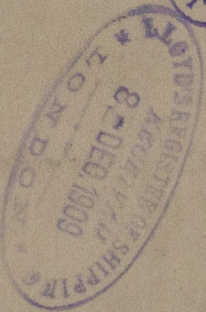

RECEIVED



© 2020

Lloyd's Register
Foundation

W891-0098