


Boilers No 771.

Sketch showing amended position of Bottom Manholes.  
Scale 1" = 1 Foot.

25/1/10  
LLOYD'S REGISTER  
LONDON

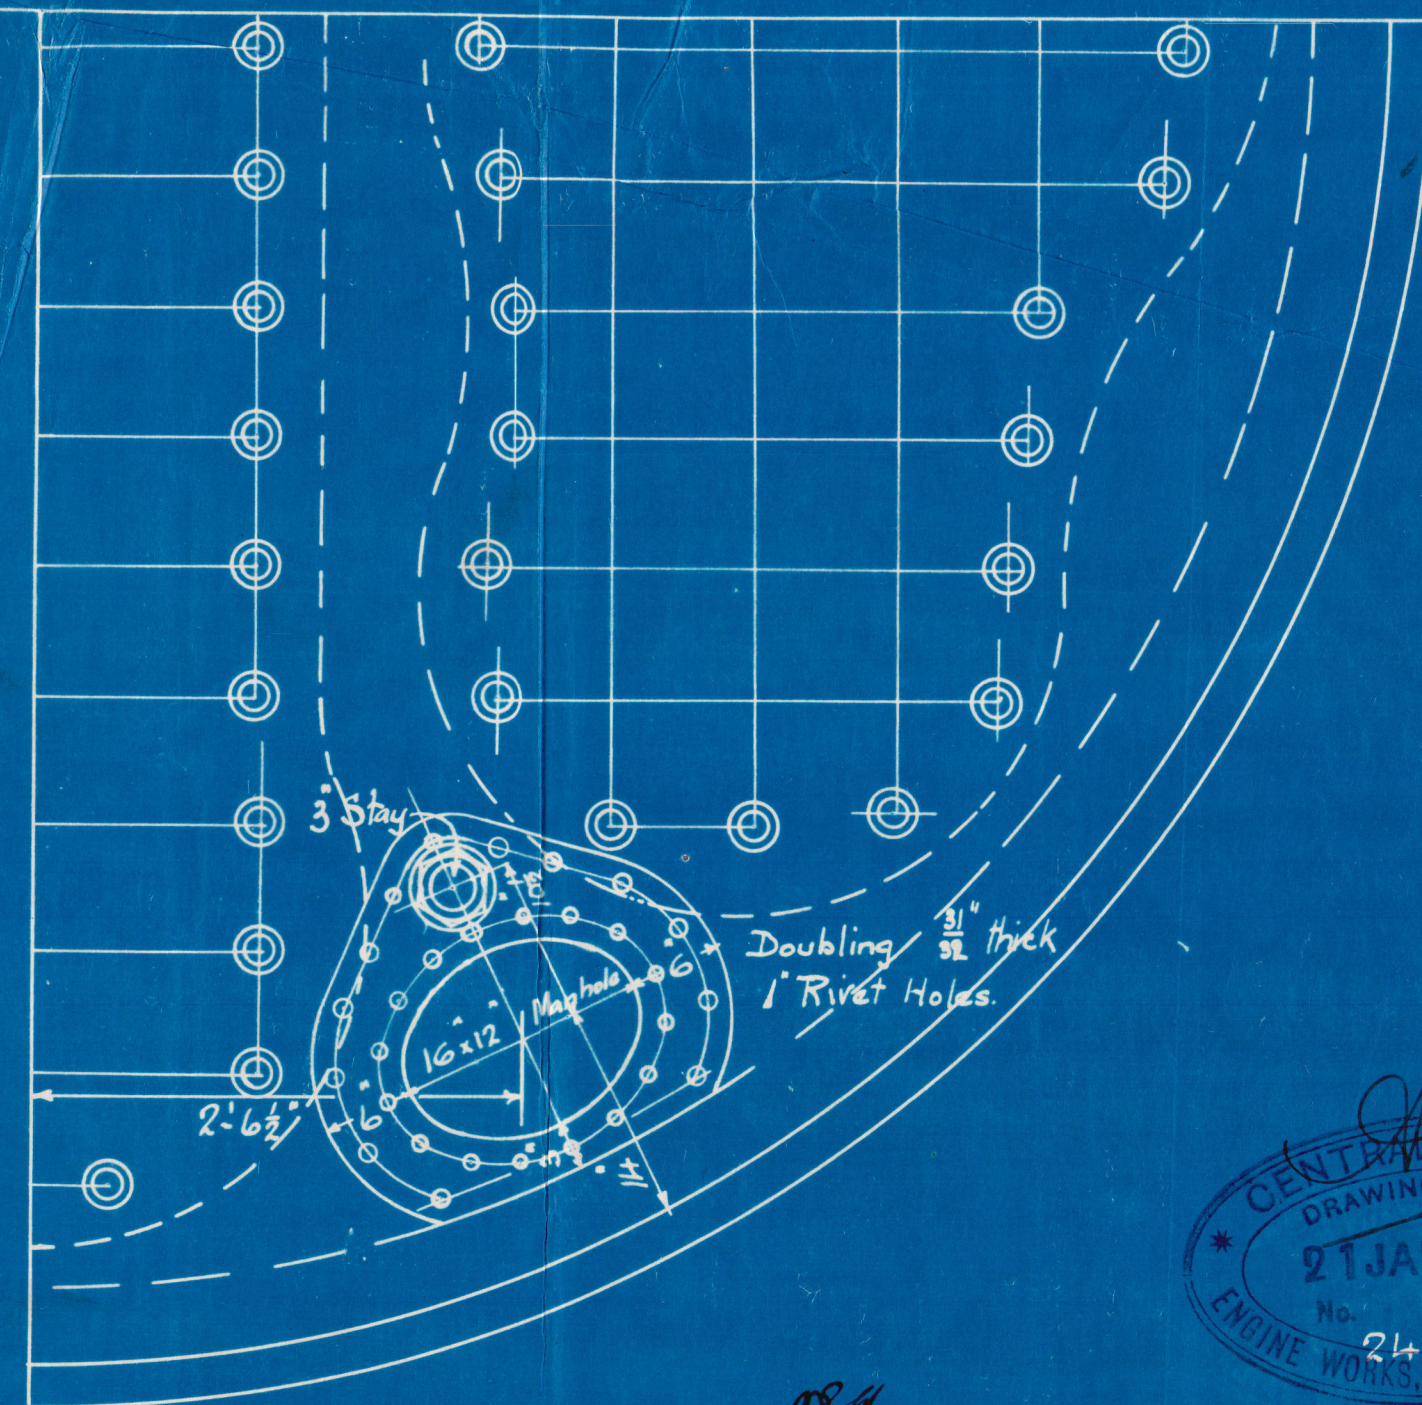


DRAWING OFFICE  
21 JAN. 1910  
No. 24025 A  
ENGINE WORKS, WEST HARTLEPOOL

J.M.  
25/1/10  
James Jones 24/1/10

Lloyd's Register  
Foundation



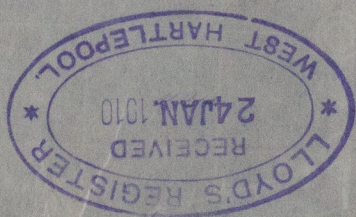

© 2020

Lloyd's Register  
Foundation