

3-13  
 4-18  
 4-B (No. 175)  
 4-5-13  
 6-6-13  
 19-8-13 (178/19)

# MIDSHIP SECTION.


## SS N° 174 & 5. 178 & 179

LENGTH B.P. 210'0" BREADTH MLD 31'9" DEPTH MLD 17'6"  
 Scale 1/2" = 1 foot

CLASS 100 A1 Lloyds.

Hatch Beams in N° 174-175

Match Webs alternate Spacing  
Main & Quarter Decks (See profile.)

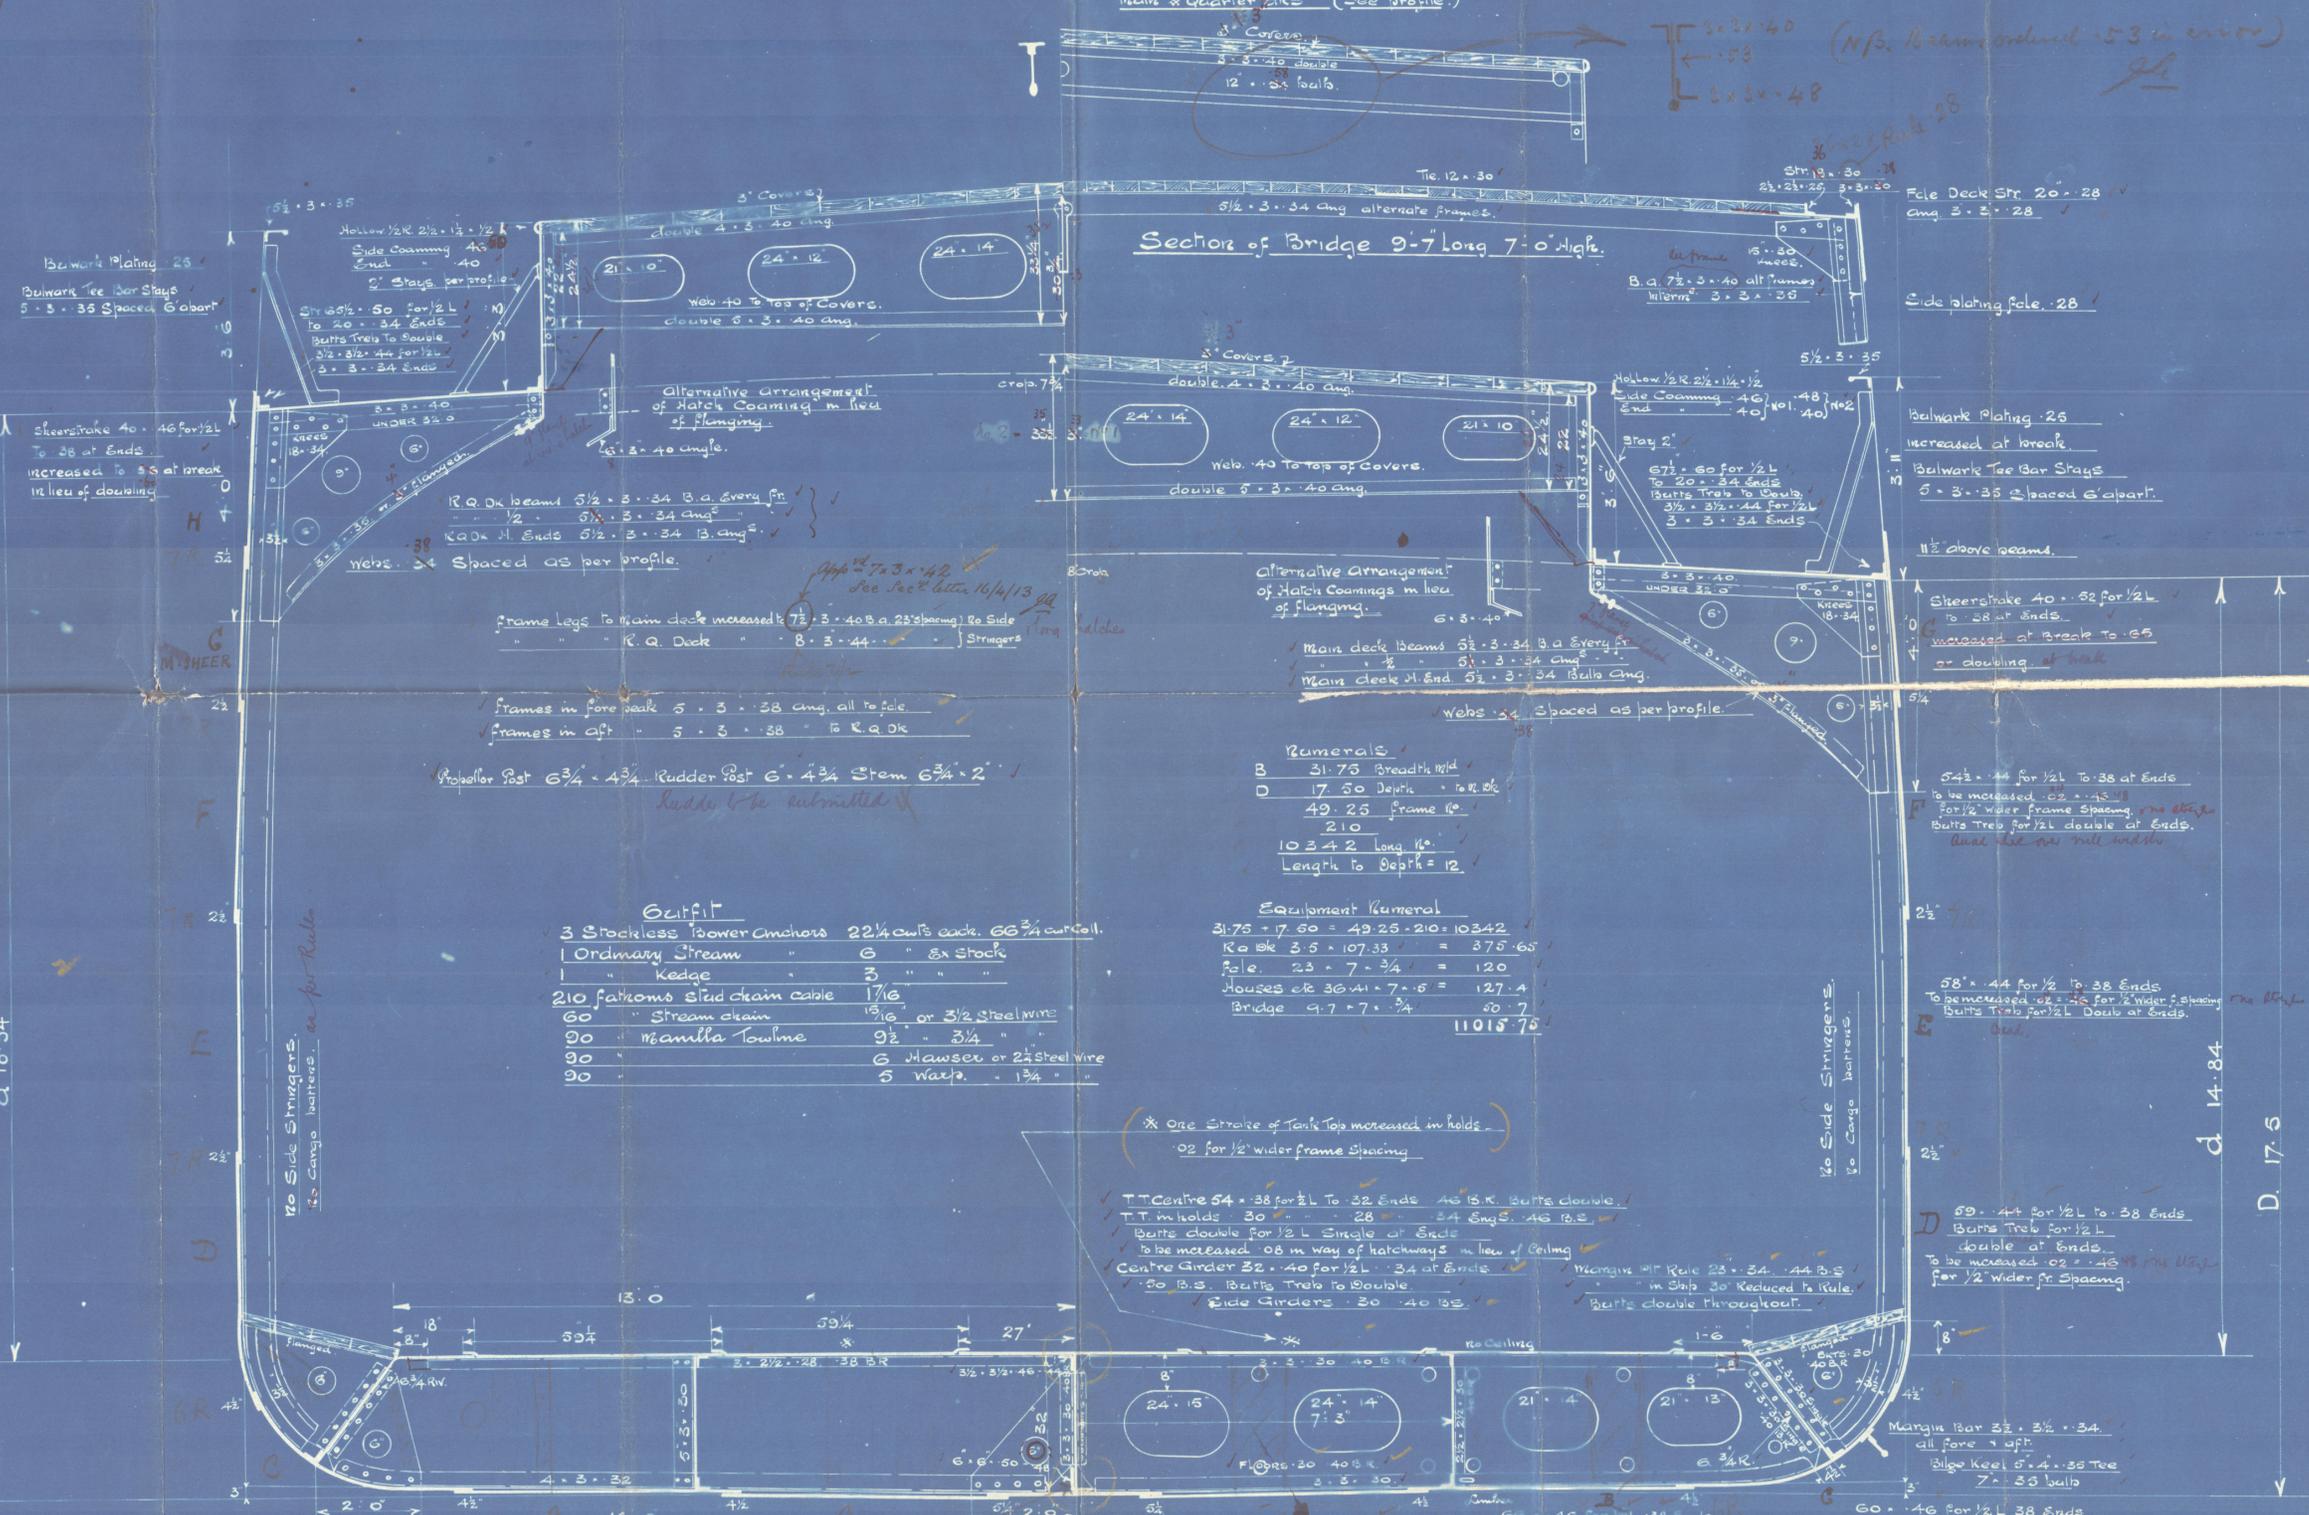

Section of Bridge 9'-7" Long 7'-0" High.

**NUMERALS**

B	31.75	Breadth Mid
D	17.50	Depth to 1st. Deck
	49.25	Frame No.
	210	
	10342	Long 1/2"
		Length to Depth = 12

**Equipment Numeral**

31.75	17.50	49.25	210	10342
Keel	3.5	107.33		375.65
Keel	2.3	7.34		120
Houses	28	41	7.5	127.4
Bridge	9.7	7.34		50.7
				<b>11015.76</b>

**Outfit**

3	Stockless Power Anchors	22 1/4 cwt's each.	66 3/4 cwt's Cell.
1	Ordinary Stream	6 "	6x Stock
1	Kedge	3 "	" "
210	fathoms Sled chain cable	1 1/16	" "
60	" Stream chain	1 5/16	or 3/2 Steelwire
90	" Manila Towline	9 1/2 "	3 1/4 "
90	" "	6 "	Mawson or 2 1/2 Steel Wire
90	" "	5 "	Watts. 1 1/4 "

D = 21.0  
d 18.34

d 14.84  
D. 17.5





fitted double...  
Sec. letter 16/4/13

29.3.13

179

S.S. Harlech

Sld Rpt no 26304

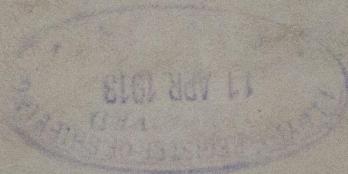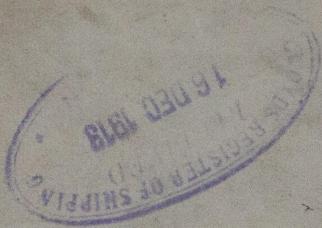

OSBOURNE, GRAHAM & Co.,  
SHIPBUILDERS,  
HYLTON,  
SUNDERLAND



RETAIN

MID. SECTION

OSBOURNE, GRAHAM & Co.,  
SHIPBUILDERS,  
HYLTON,  
SUNDERLAND


N° 174 & 175

178 & 179

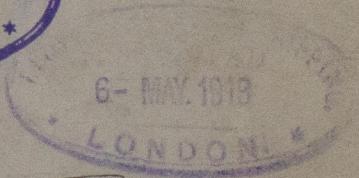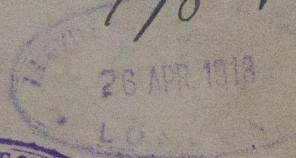

178 Cementing

Sld Rpt no 26059

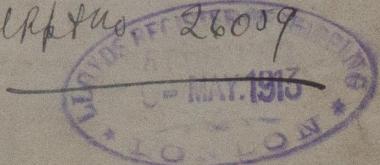

174 "Figulina"

Sld Rpt no 25901

175 "Gyula"

Sld Rpt no 26035  
Lloyd's Register  
Foundation