

29.3.13
 16.4.13
 28.6.13 (No. 175)
 4.5.13
 6.6.13
 19/8/13 (178/9)
 3'3" SHEER.

— PROFILE AND DECKS S.S. N° 174. & N° 175

LENGTH B.P. 210'0 BREADTH MLD 31'9 DEPTH MLD 17'6



CLASS 100 A1 LLOYDS

SCALE 1/8" = 1 FT.

178/9

Bulkhead lines or brackets to W.T. bulkheads as per rules
 and to Surveyors Satisfaction

SS N° 178 and 179
 Tiller of increased scantlings
 approved in lieu of fitting spare tiller
 See approved sketch of same 20

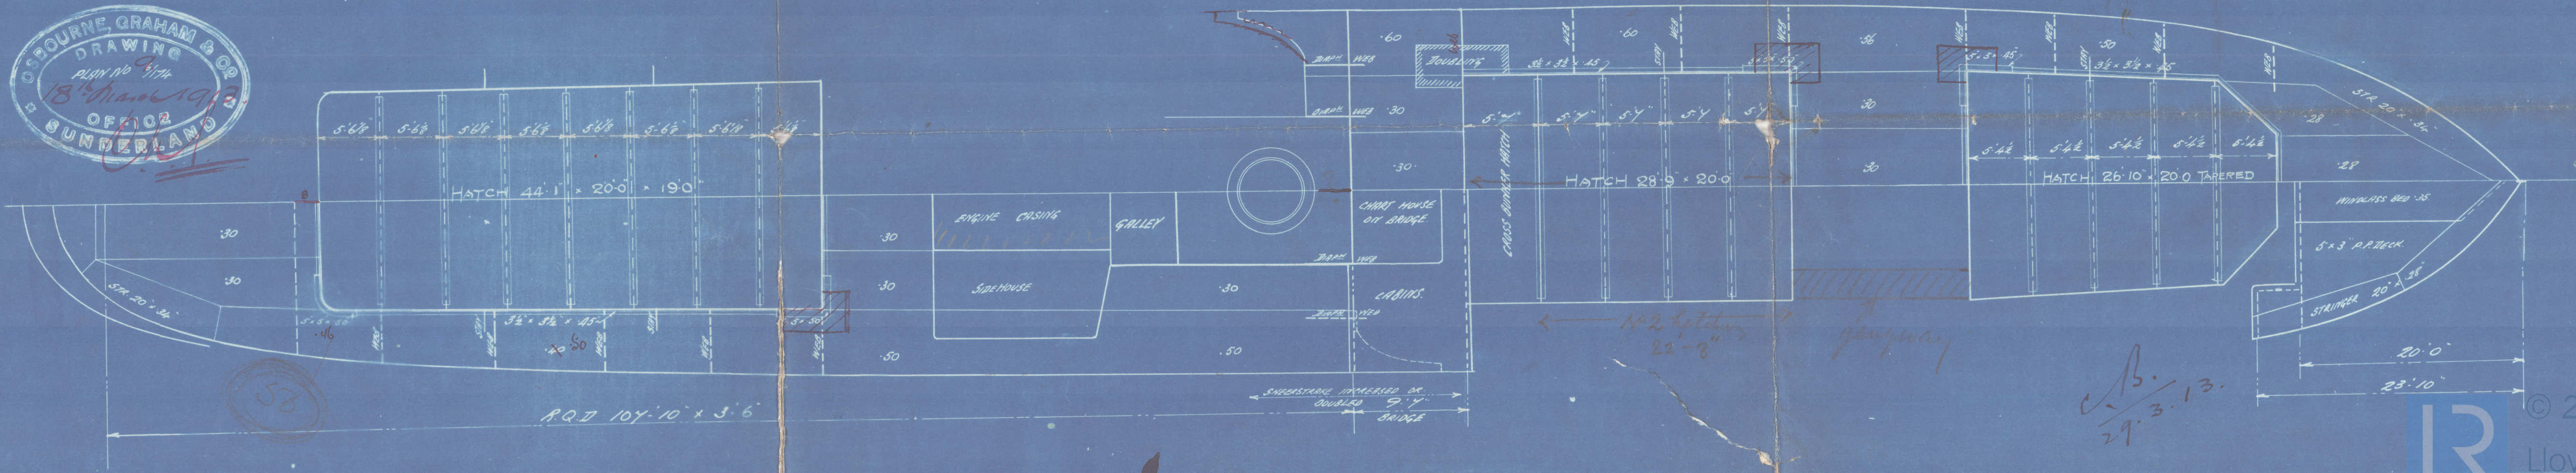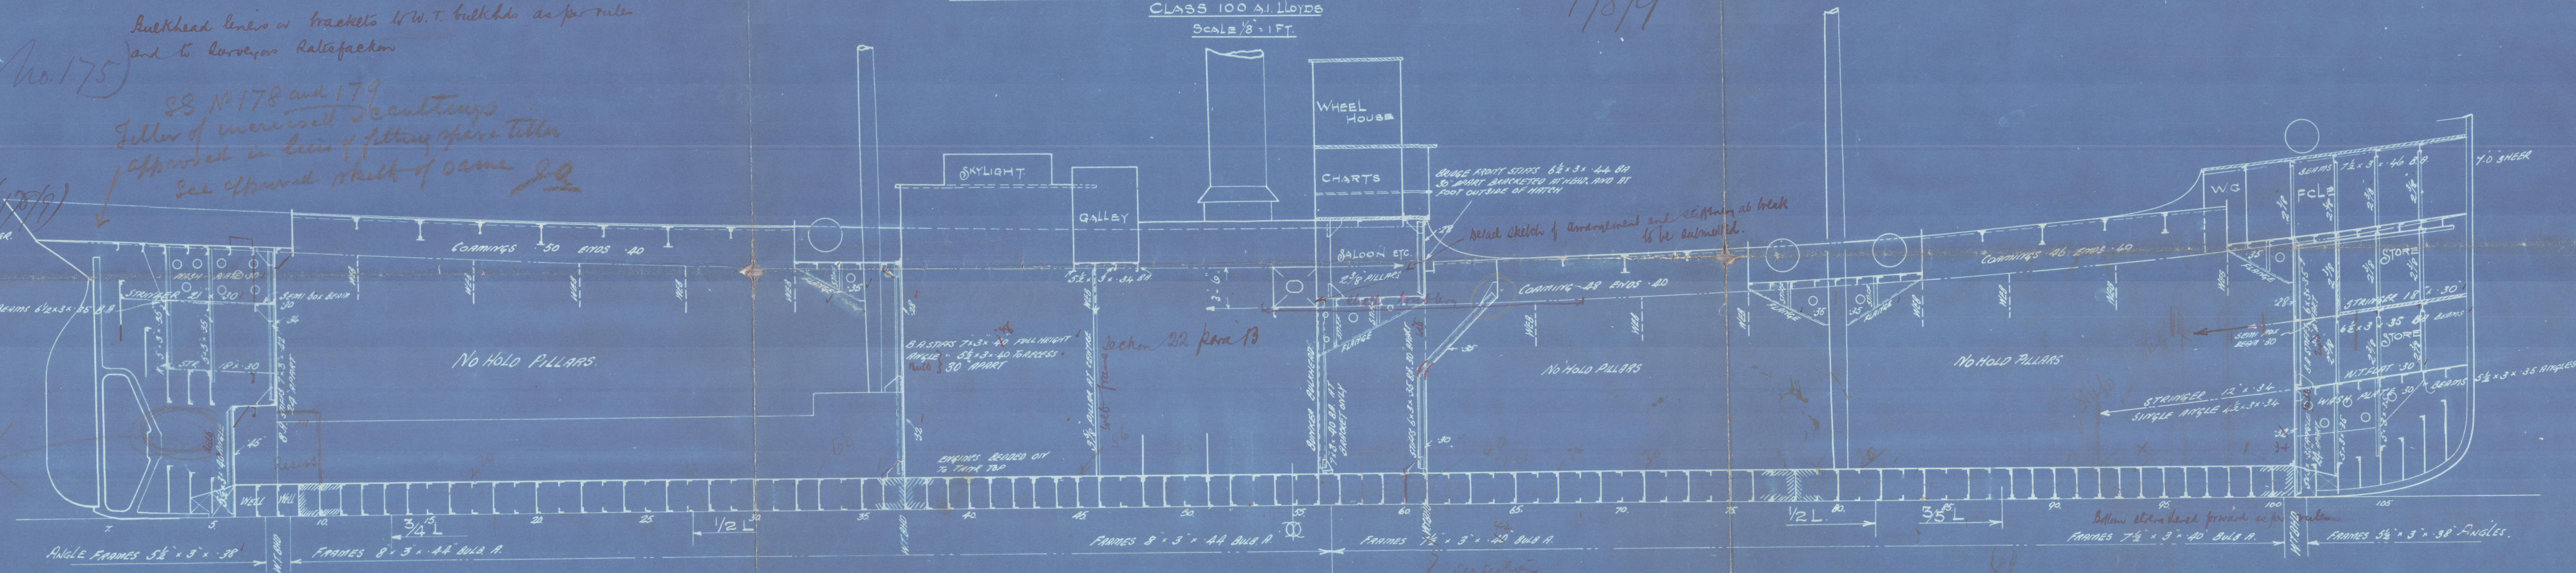

C.B.
 29.3.13.



© 2020
 Lloyd's Register
 Foundation




OSBOURNE, GRAHAM & Co.,
SHIPBUILDERS,
HYLTON,
SUNDERLAND

PROFILE


OSBOURNE, GRAHAM & Co.,
SHIPBUILDERS,
HYLTON,
SUNDERLAND

Nº 174 * 175
17849

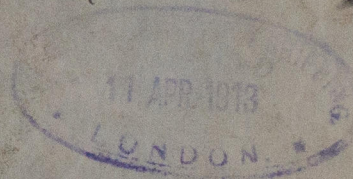


174

S.S. "Figulina"
Sld Rpt No 25901

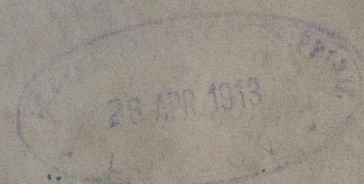

175

S.S. "Gyula"
Sld Rpt No 26035

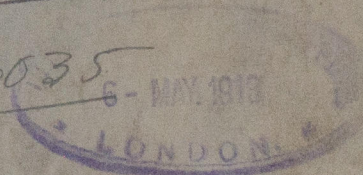

178

Cementing
Sld Rpt No 26059



179

S.S. "Harlech"
Sld Rpt No 26



Sld Rpt No 26

© 2020
Lloyd's Register
Foundation

17891-0154