

702-202-202 57

waited qidabim

9.5.11
7.5.11

PLAN No. 1052
FOR ENCLOSURE TO
Messrs. Lloyds Surveyors
Hull
FROM
COCHRANE & SONS,
SHIPBUILDERS, SELBY
DATE Dec 21/11 *RR*

MIDSHIP SECTION

STEEL SCREW FLEETERS

Nos 505-6-7

Messrs Lloyds Surveyors
Hull


13/5/11 *RR*

DIMNS 112'-0" x 22'-6" EX x 15'-2" D M^{LD}

SCALE 1/2" = 1 FOOT

TO CLASS 100 A 1 LLOYDS

DECK PLATED OVER IN WAY OF MACHINERY SPACE
ENGINE & BOILER CASING AS PREVIOUSLY APPROVED

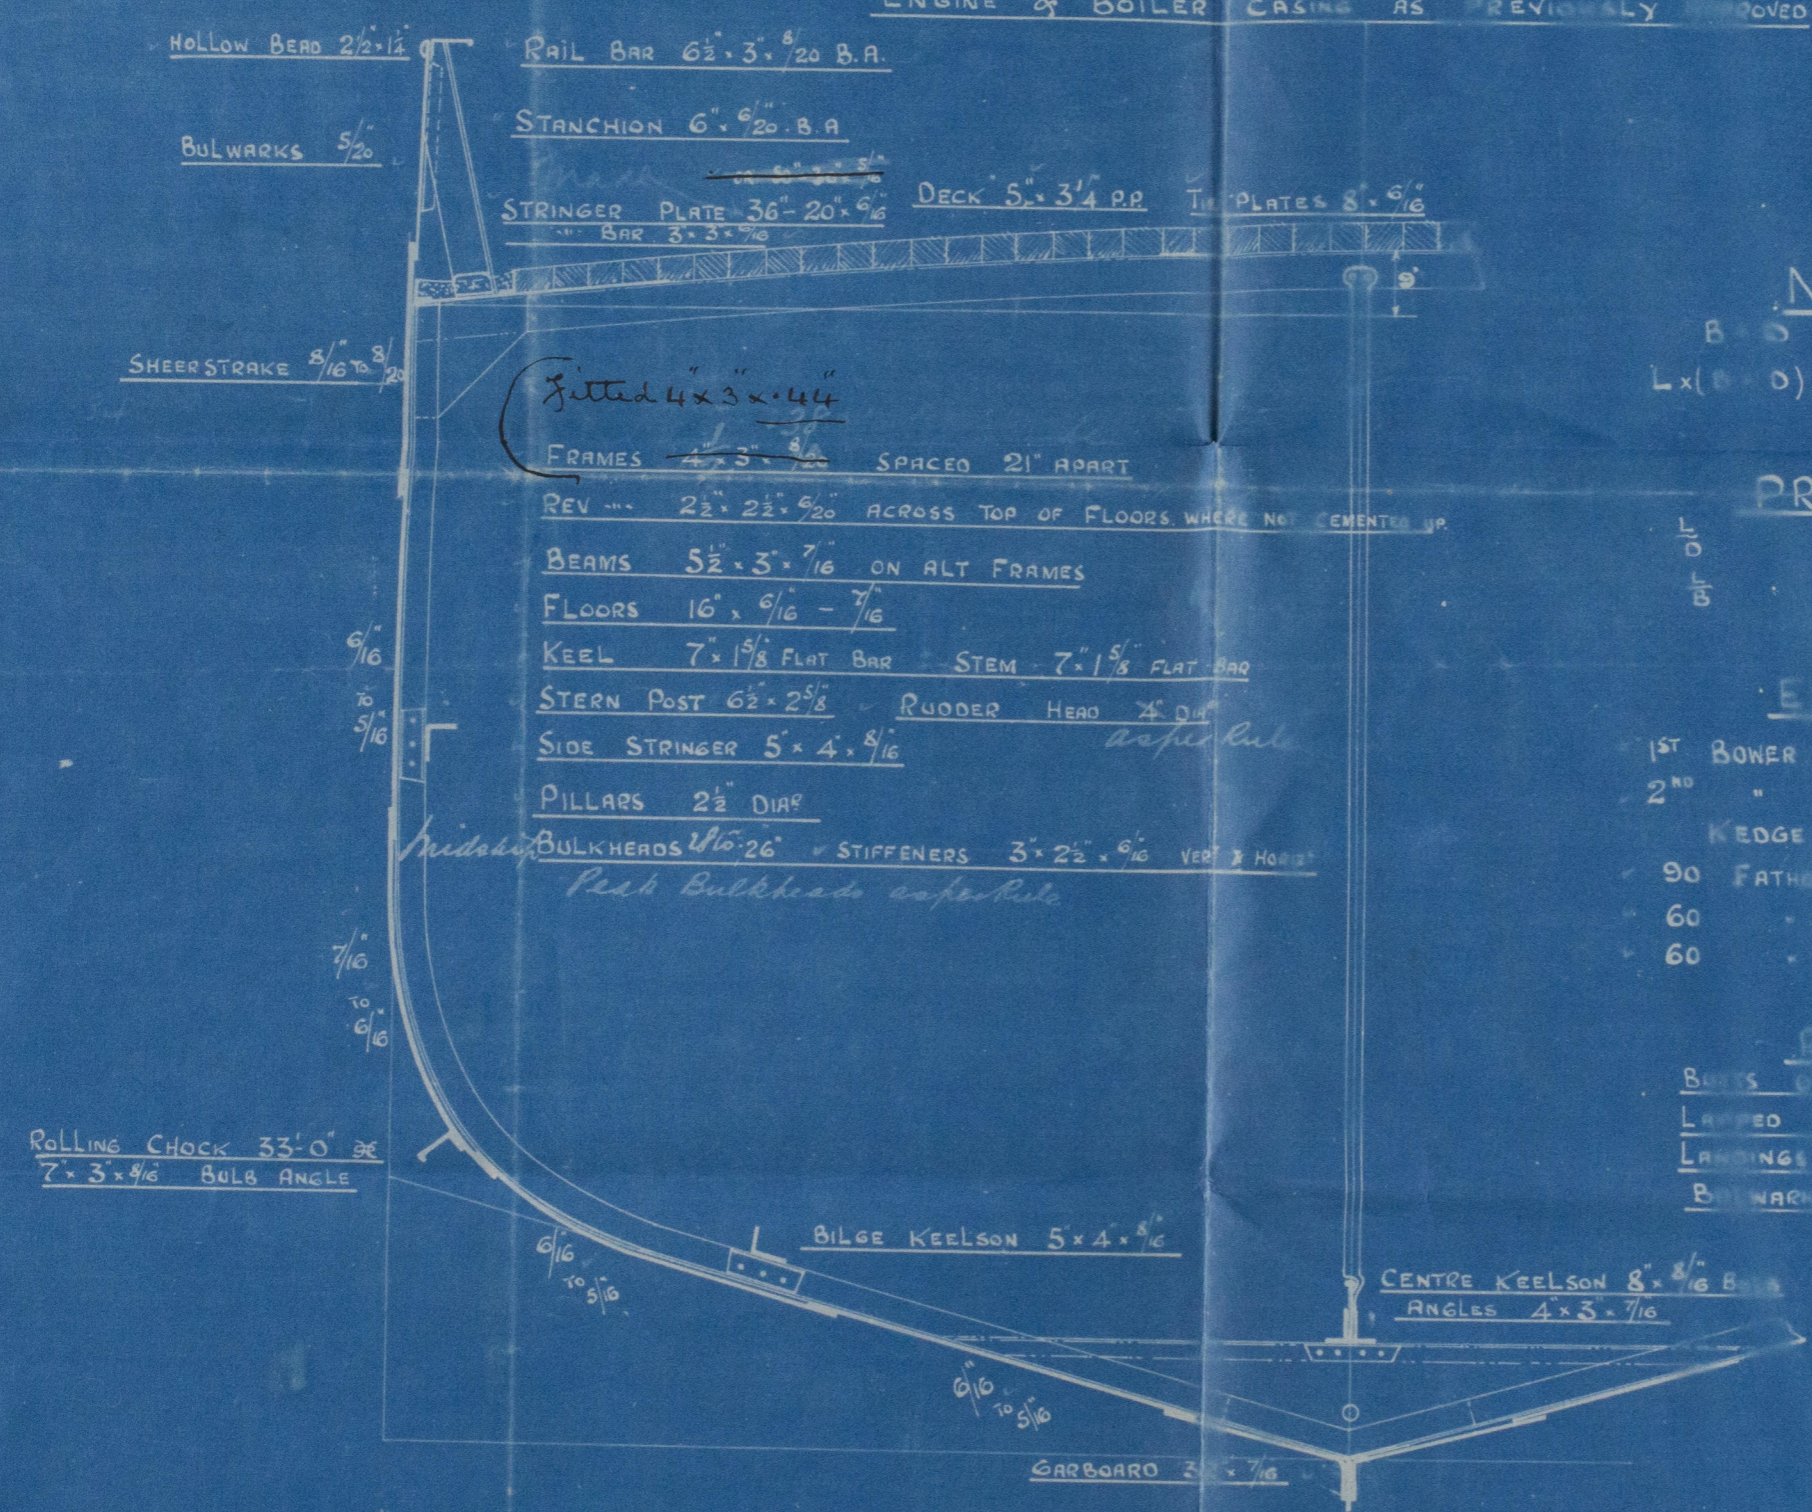

NUMERALS

B x D 35.52
L x (B x D) 3978.24

PROPORTIONS

L/D 8.35
L/B 5.0

EQUIPMENT


1ST BOWER ANCHOR = 5 CWTs EX STOCK OR 6 1/4 CWTs STOCKLESS
2ND " " = 4 1/2 " " " 5 1/2 " "
KEDGE " " = 2 1/2 " " " "
90 FATHOMS " " = 1" CABLE
60 " " = 5 1/2 HAWSER
60 " " = 4 WARP

RIVETING

BUTTS OF SHELL PLATING
LAPPED & DOUBLE RIVETED
LANDINGS DOUBLE RIVETED
BULKHEADS SINGLE RIVETED

C.B.

19.5.11.

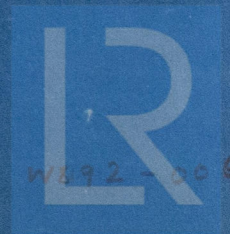

© 2020
Lloyd's Register
Foundation

Cochrane & Sons

Nos 505. 506. & 507

Duplicate

Midship Section.

Sr Epsworth
Hull Report No. 24575

W 892-0068

RETAIN



© 2020

Lloyd's Register
Foundation