
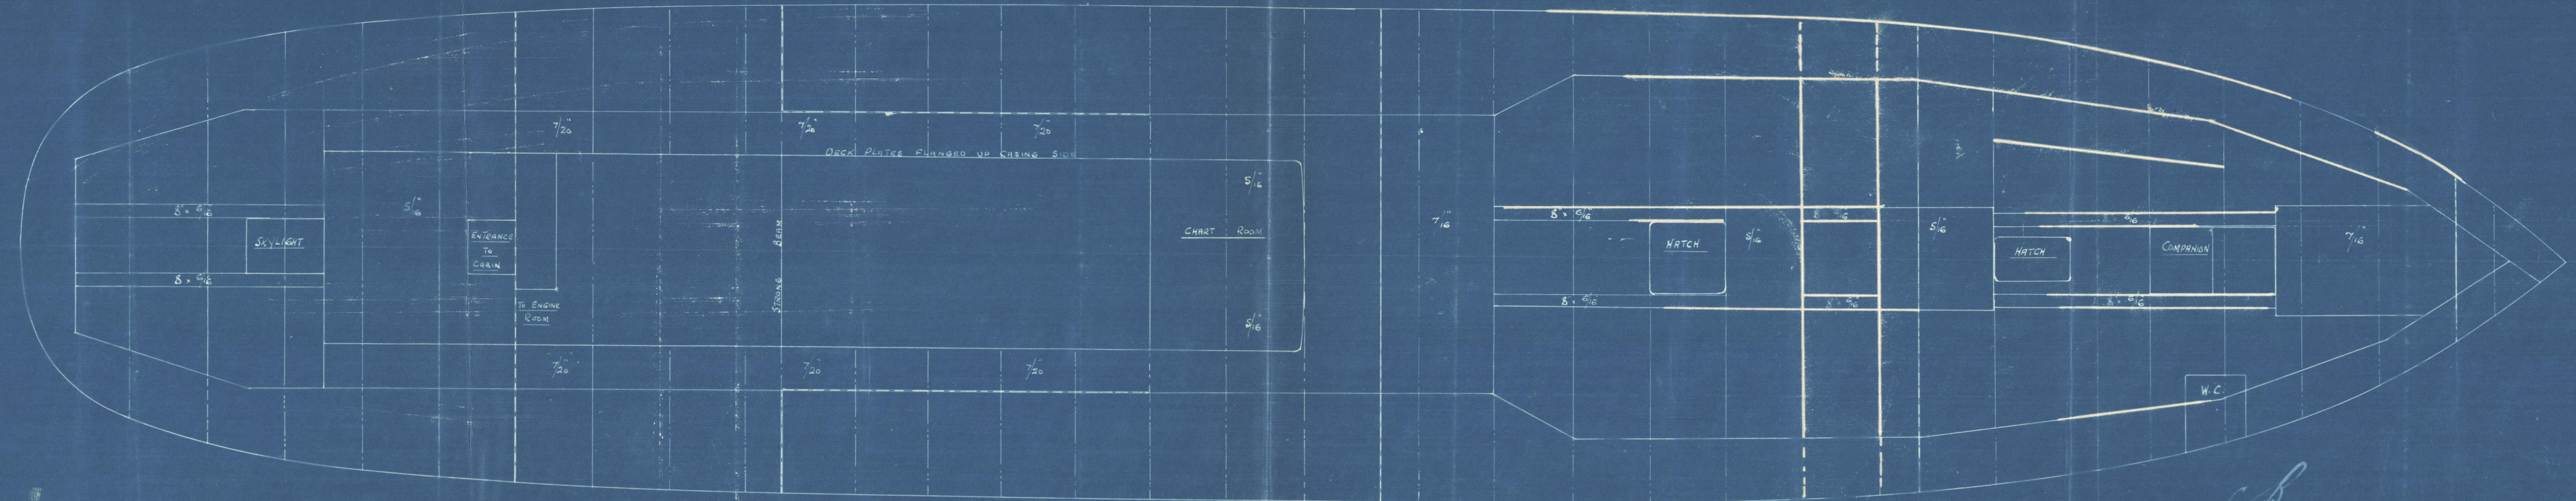


Wm P. Mearns
502-502-202-201
Wm P. Mearns

PLAN No. 1053
FOR ENCLOSURE TO
Messrs. Lloyd's Surveyors
FROM
COCHRANE & SONS,
SHIPBUILDERS, SELBY
DATE 19.5.11. RR

PROFILE & DECK PLAN
Nos 505 & 67
DIMNS 112'0" x 22'6" x 13'2" DEPTH M^{LD}
SCALE 1" = 1 FOOT
PILLARS TO SURVEYOR'S SATISFACTION

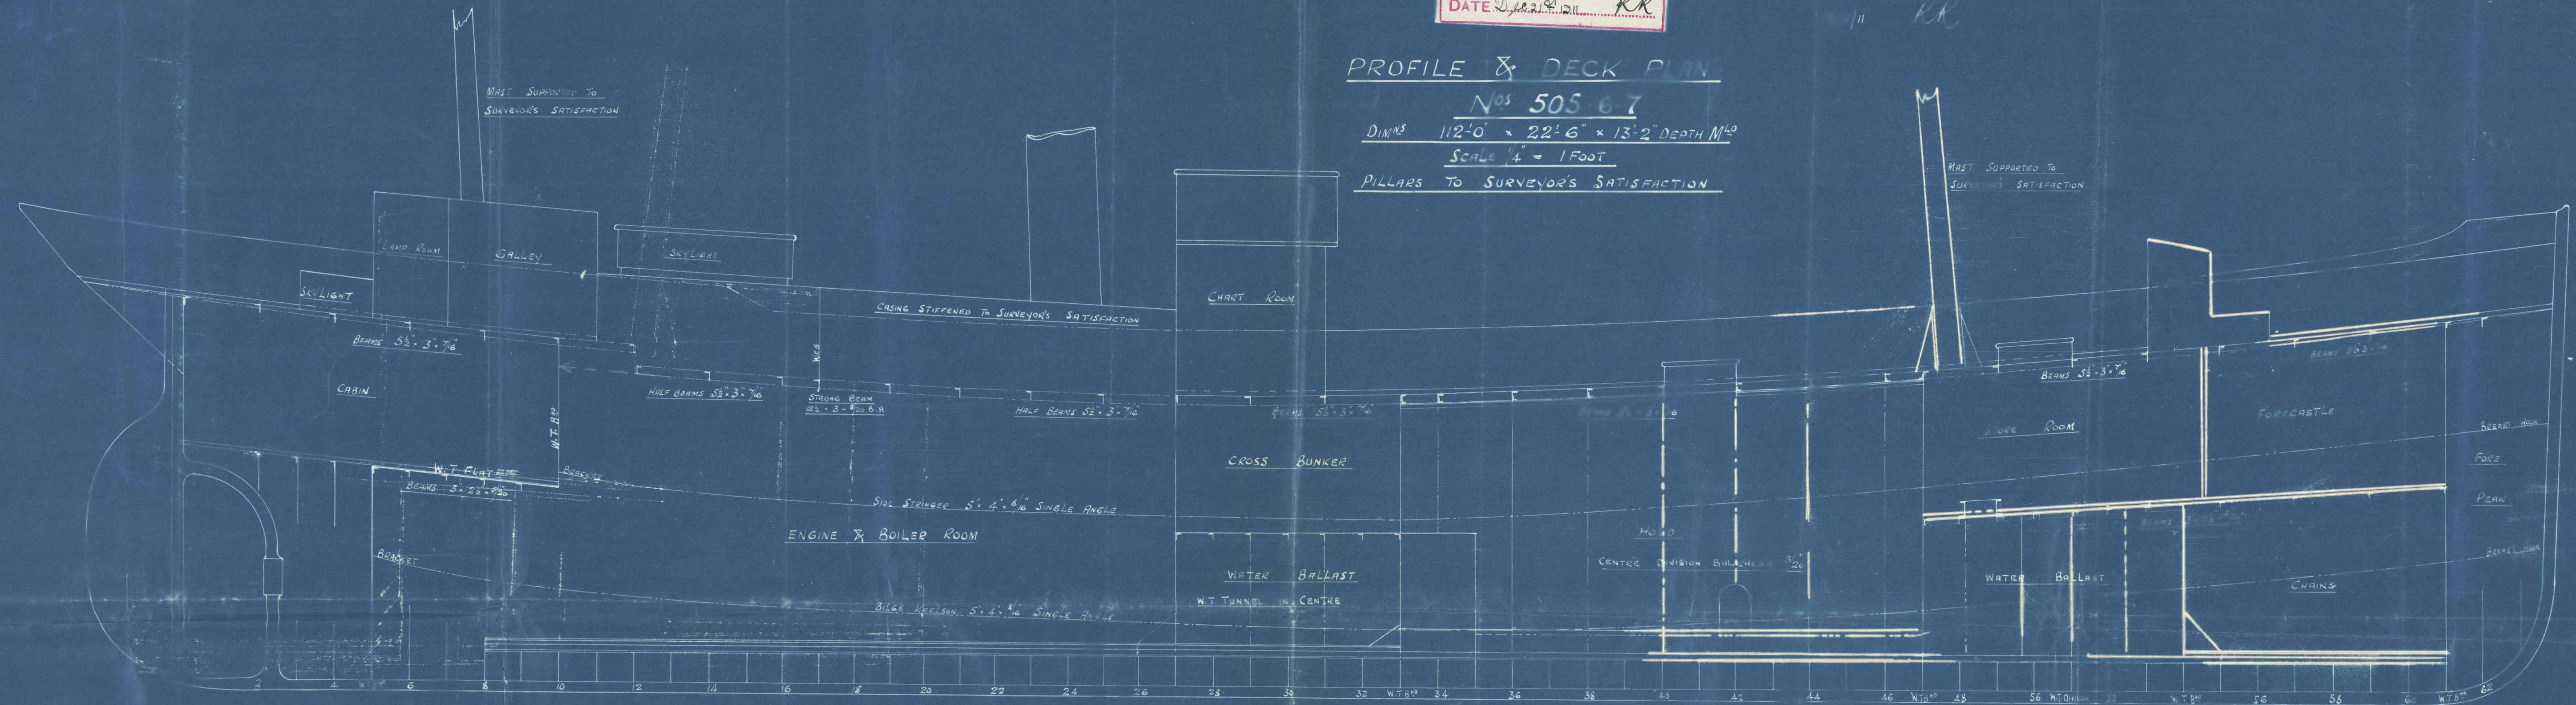

C.B.
19.5.11.

Cochrane & Sons
Nos 505. 506 & 507

Duplicate

Profile & Deck Plan

s/s Epworth

Hull Rpt No 24575-

W892-2069

RETAIN



© 2020

Lloyd's Register
Foundation