



25: 11: 05

HORIZONTAL MULTITUBULAR STEEL BOILER 10'-0" DIA BY 9'-6" LONG LLOYDS SURVEY 90 LBS W.P.




TO THE ORDER OF MESSRS SWAN & HUNTER, WIGHAM RICHARDSON & CO LTD, NEWCASTLE-ON-TYNE. No. 3379.

SCALE 1" = 1 FOOT.
BOILER No. 3379.

DOUBLE PLATE 25" THICK
NO RIVETTED WASHERS
Riveted Washers fitted
12" dia x 25"
R.D.O.

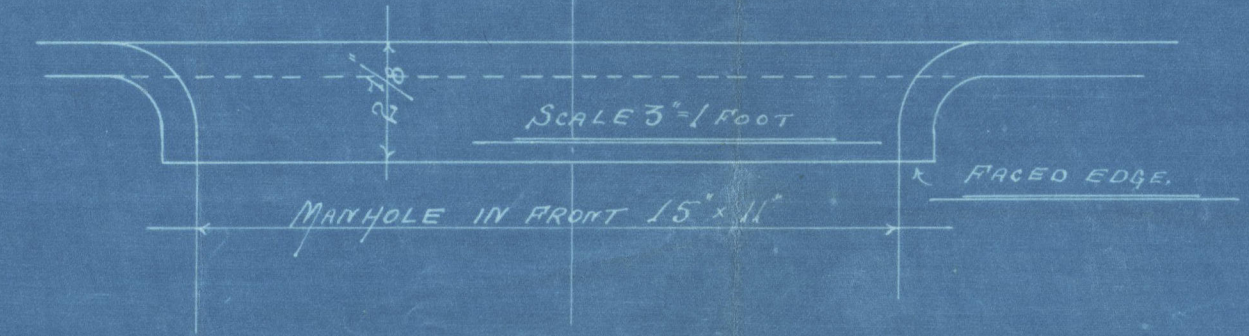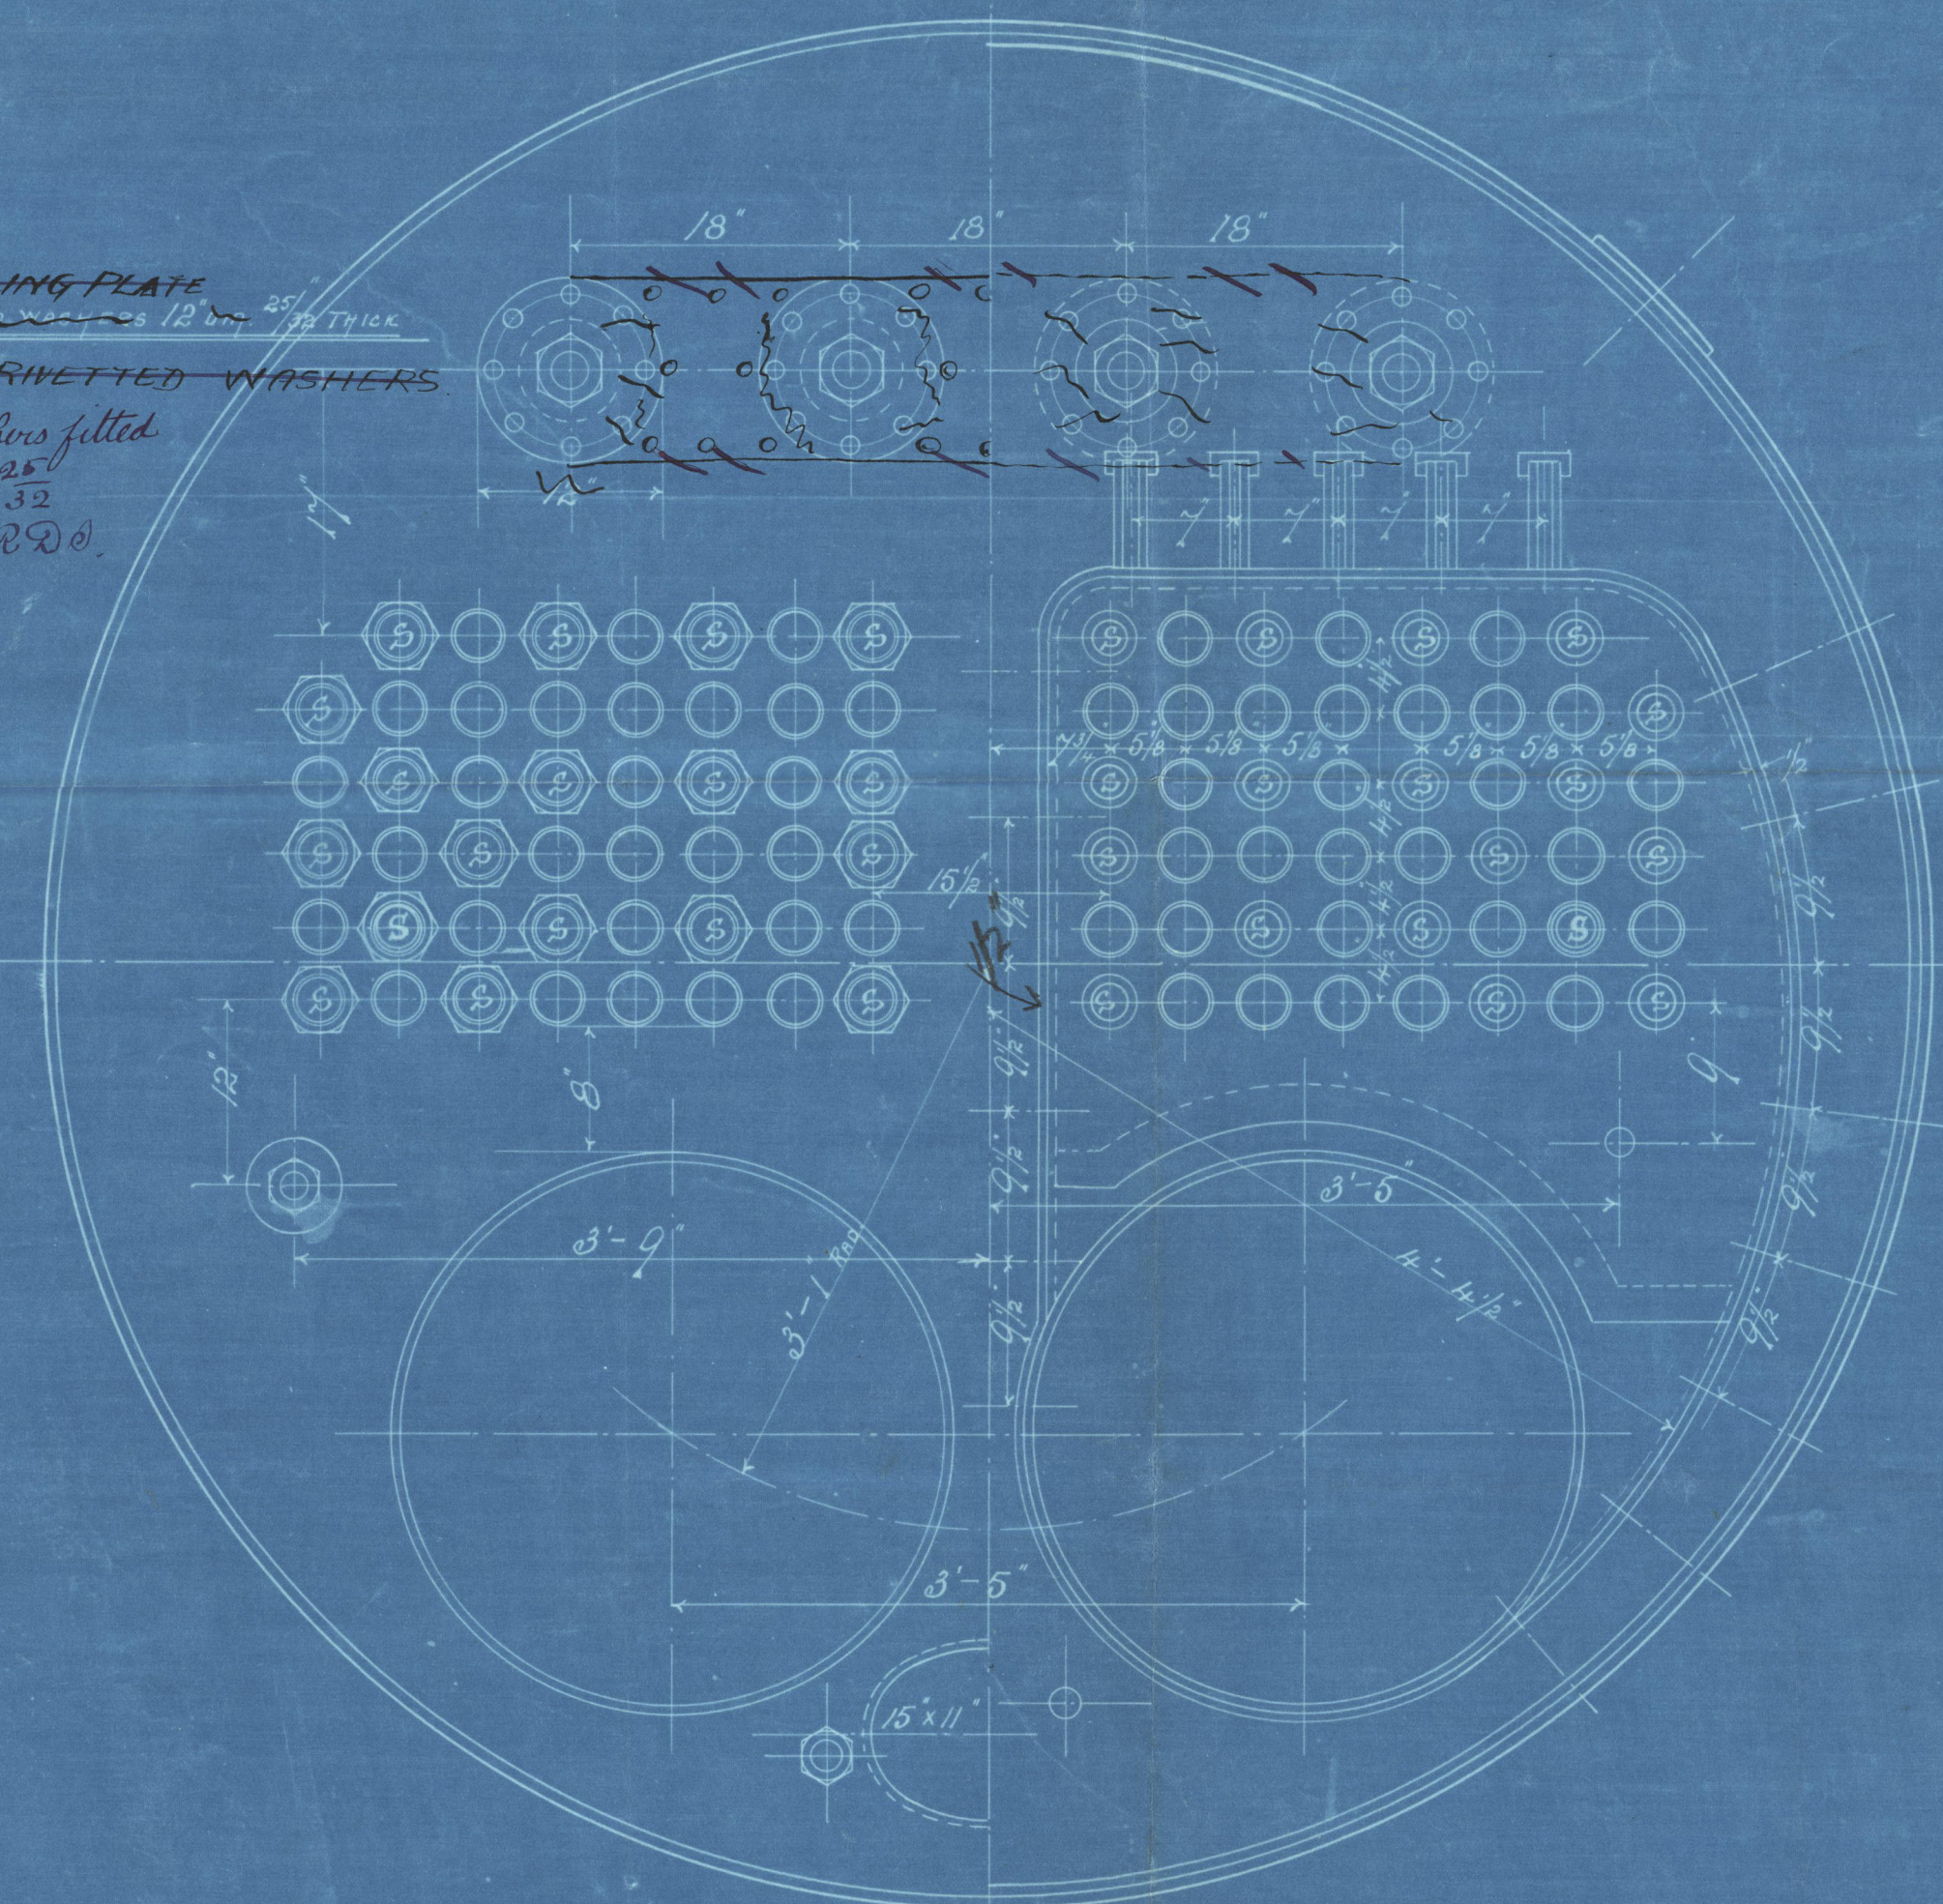

RILEY BROS. BOILER MAKERS
No. 3379
DATE Feb. 1904
S. W. Riley

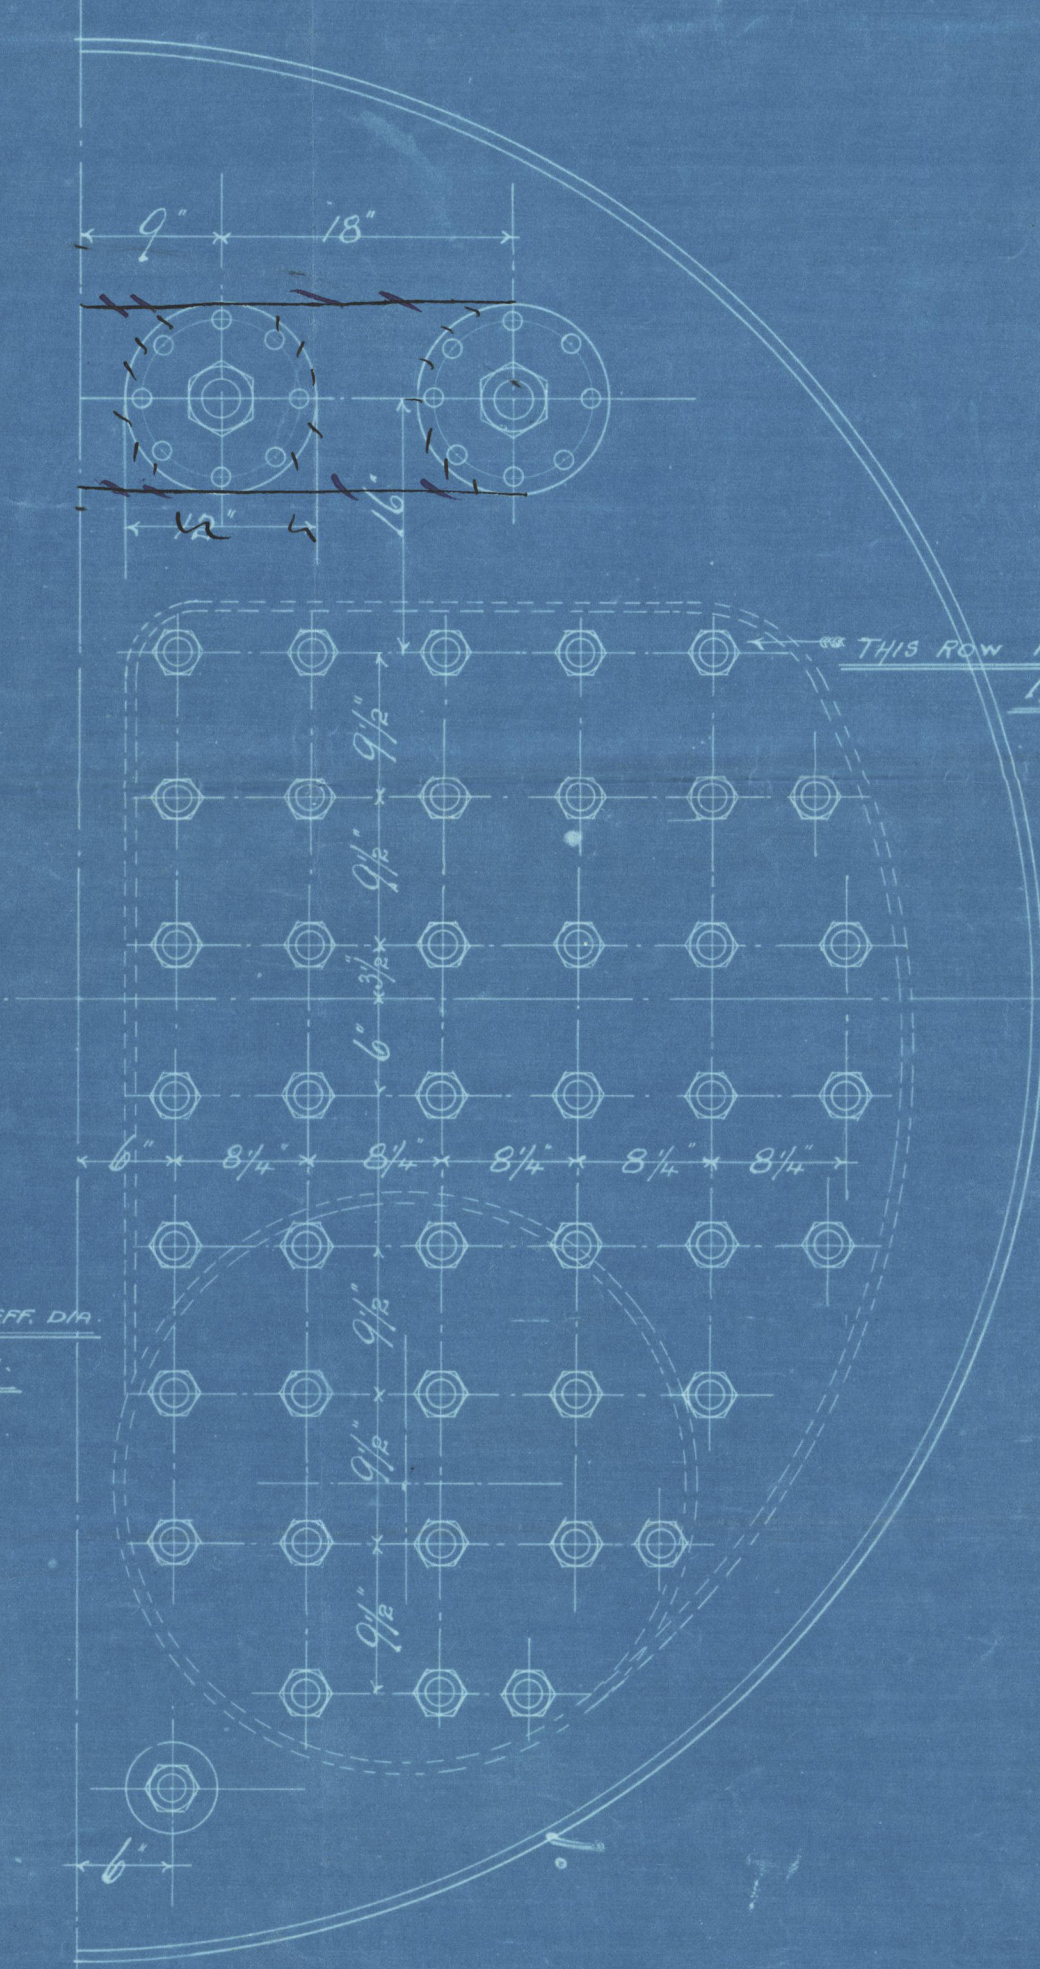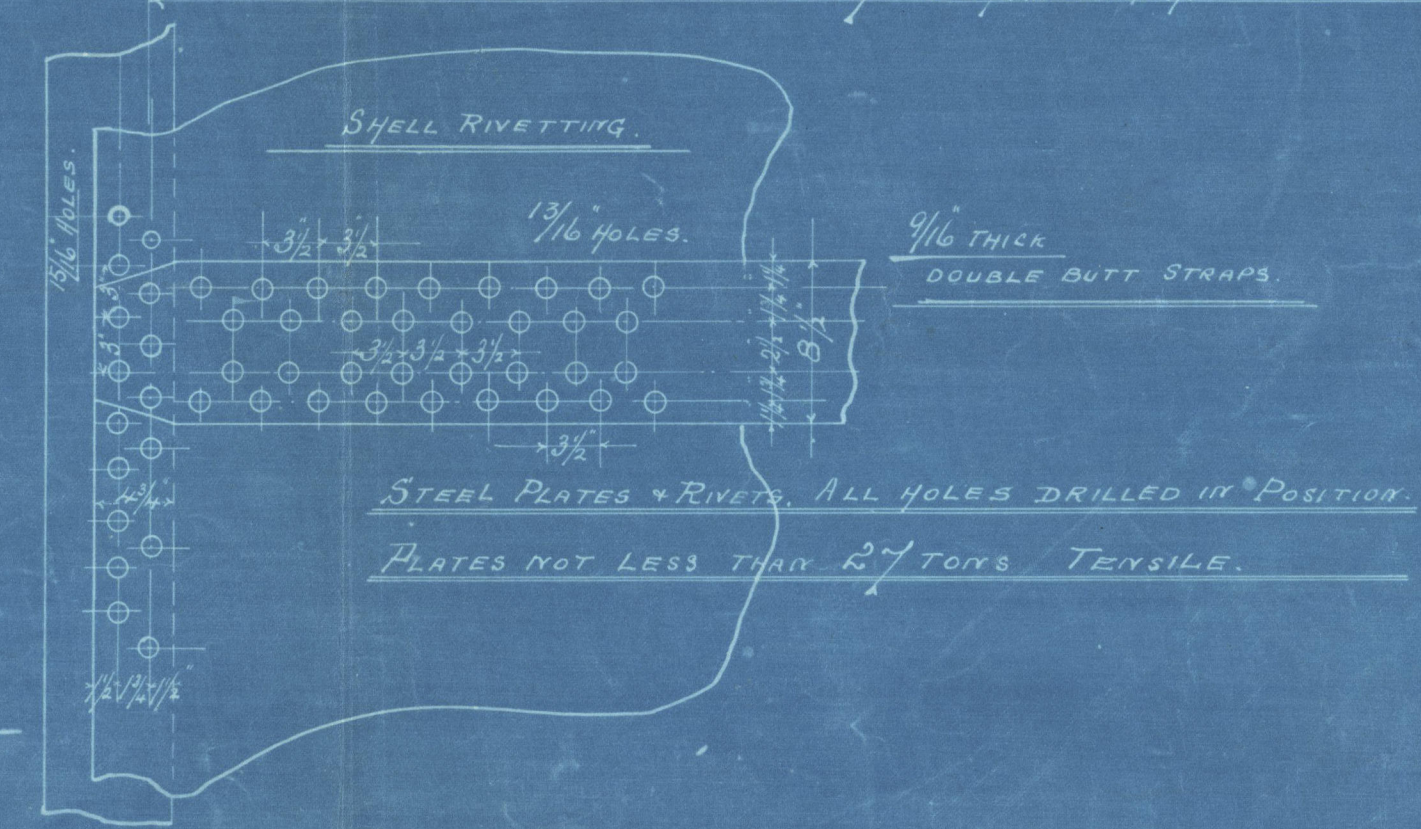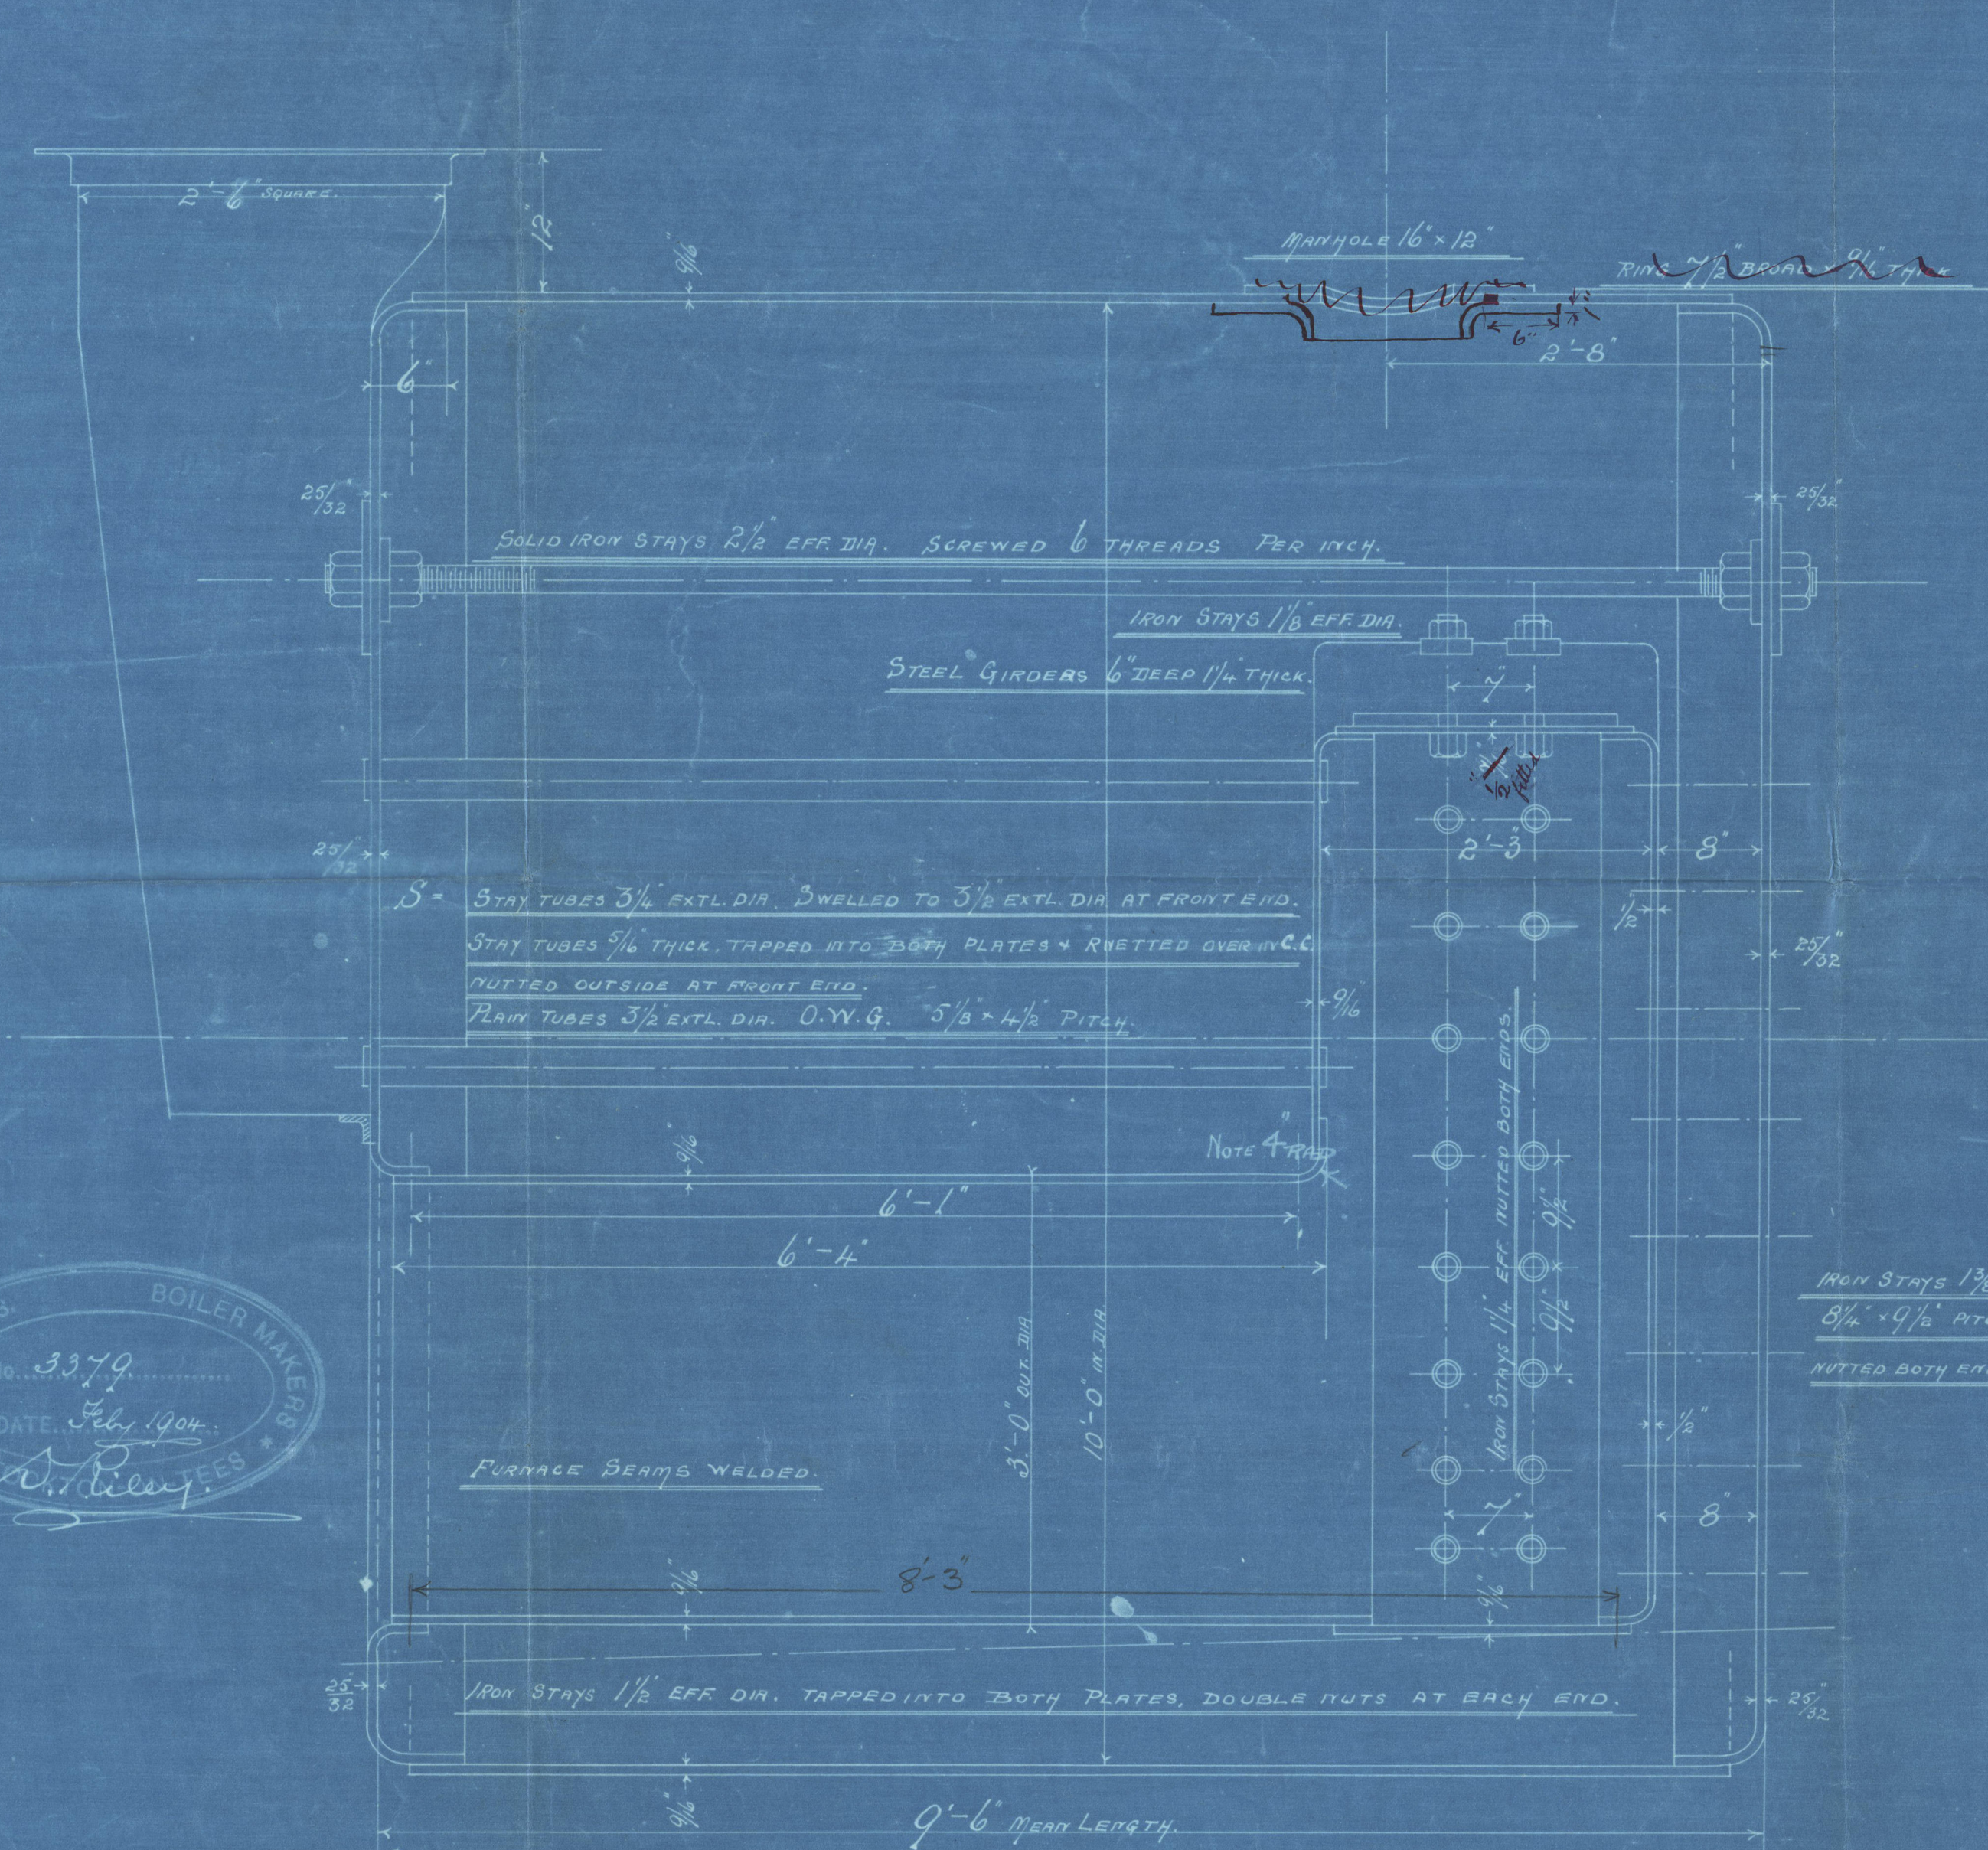

28th
24/1/05
R.D.O.
24.11.05

LLOYD'S REGISTER OF
ROYAL EXCHANGE
SHIPPING

R.D.O.
28-11-05

R

Lloyd's Register
Foundation

W 392-0149

RETAIN


Donkey Boiler
No 3670.

Riley Bros Ltd

Wvan Hunter &
Wigham-Richardson Ltd

S.S. No 757

Indb report W. 4412

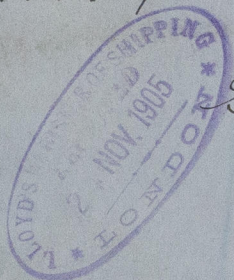

S/S Enosis

No. <u>3598</u>
LLOYD'S TEST.
<u>180</u> lbs.
<u>2, 2, 06</u>
<u>R.D.S.</u>

W892-0144



© 2020

Lloyd's Register
Foundation