


Lloyd's Register of British & Foreign Shipping,

342, Argyle Street, Glasgow.

ROCKING SHAFT BEARING

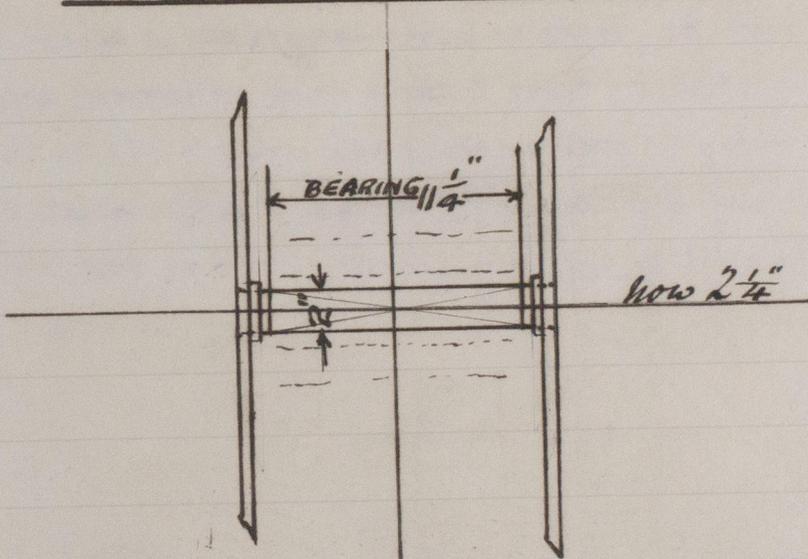

single bearing bush extending between the
levers.

Jur



© 2020

Lloyd's Register
Foundation

W892-0191