


Nos 378 S.I. "ENZIE"

To LLOYDS RULES FOR CLASS * 100-A1 STEEL (Fishing Purposes)

SCALE $\frac{1}{2}" = 1 \text{ FOOT.}$

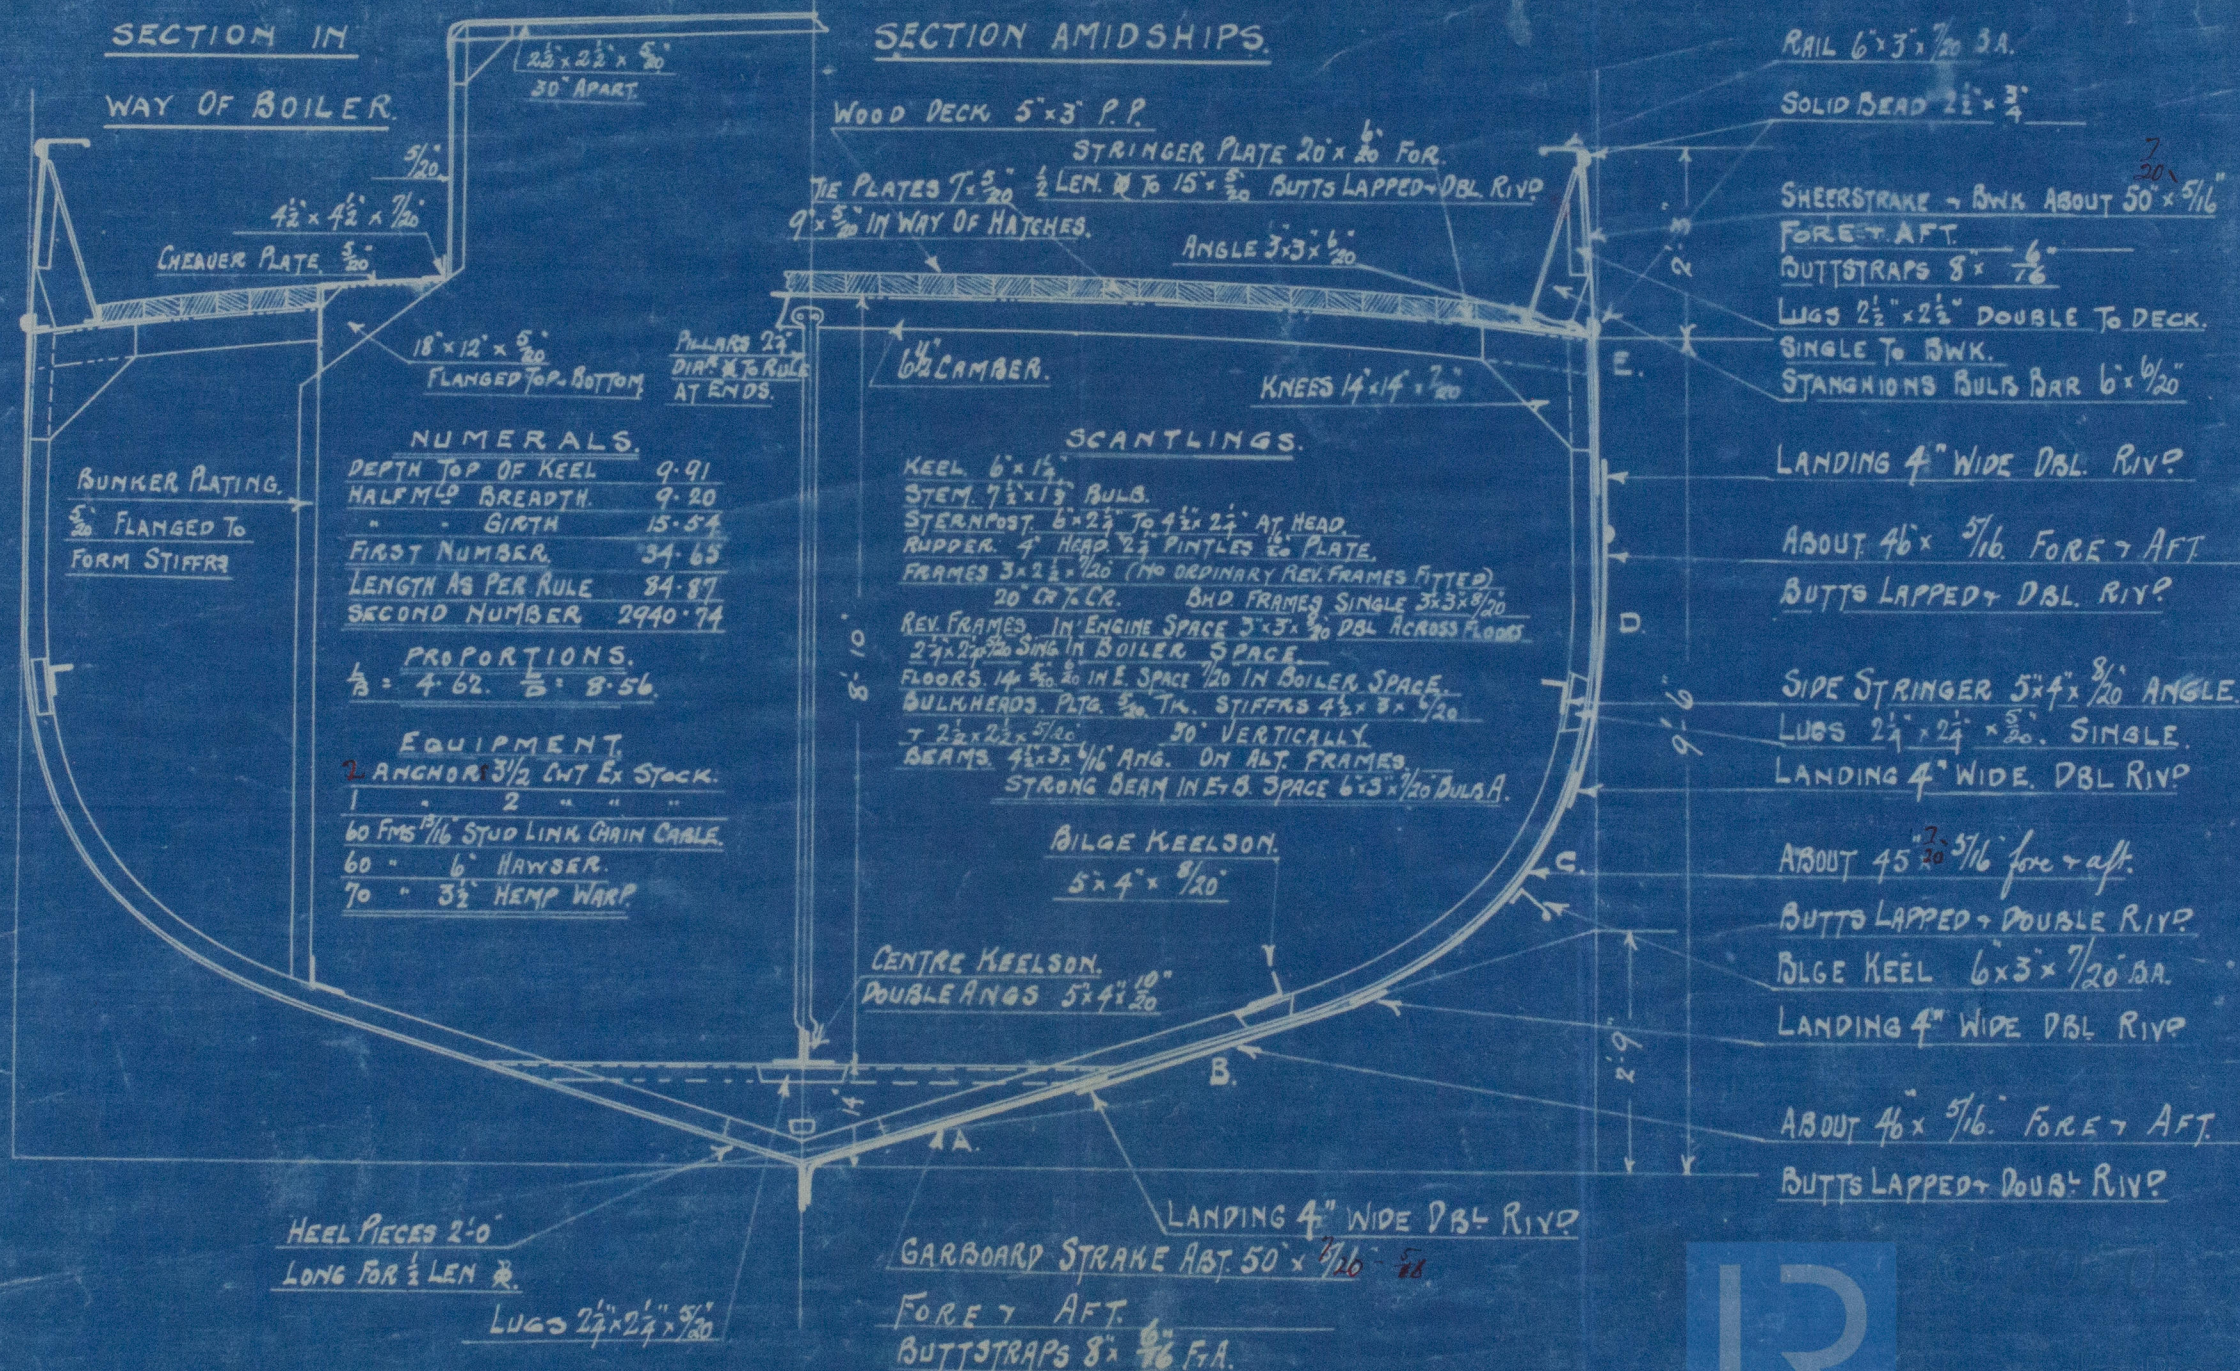

Midship Section
Mackie & Thomson Ltd. 378

S.S. "Enzie"
Glasgow Report. No. 26714

W892-0209



© 2020

Lloyd's Register
Foundation