



$\frac{1}{12}$
SCALE 1 in = 1 Foot.

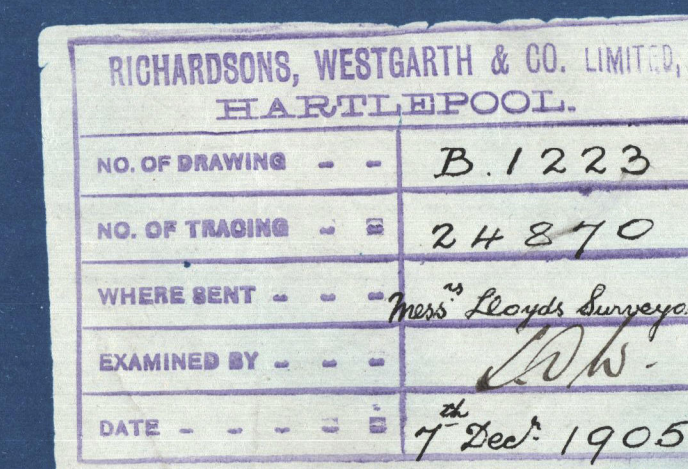

Maine Boilers
Messrs Richardsons Westgarth & Co
No 1223
For Messrs. Furness Withy & Co
SS No 295
Working Pressure 180 lbs

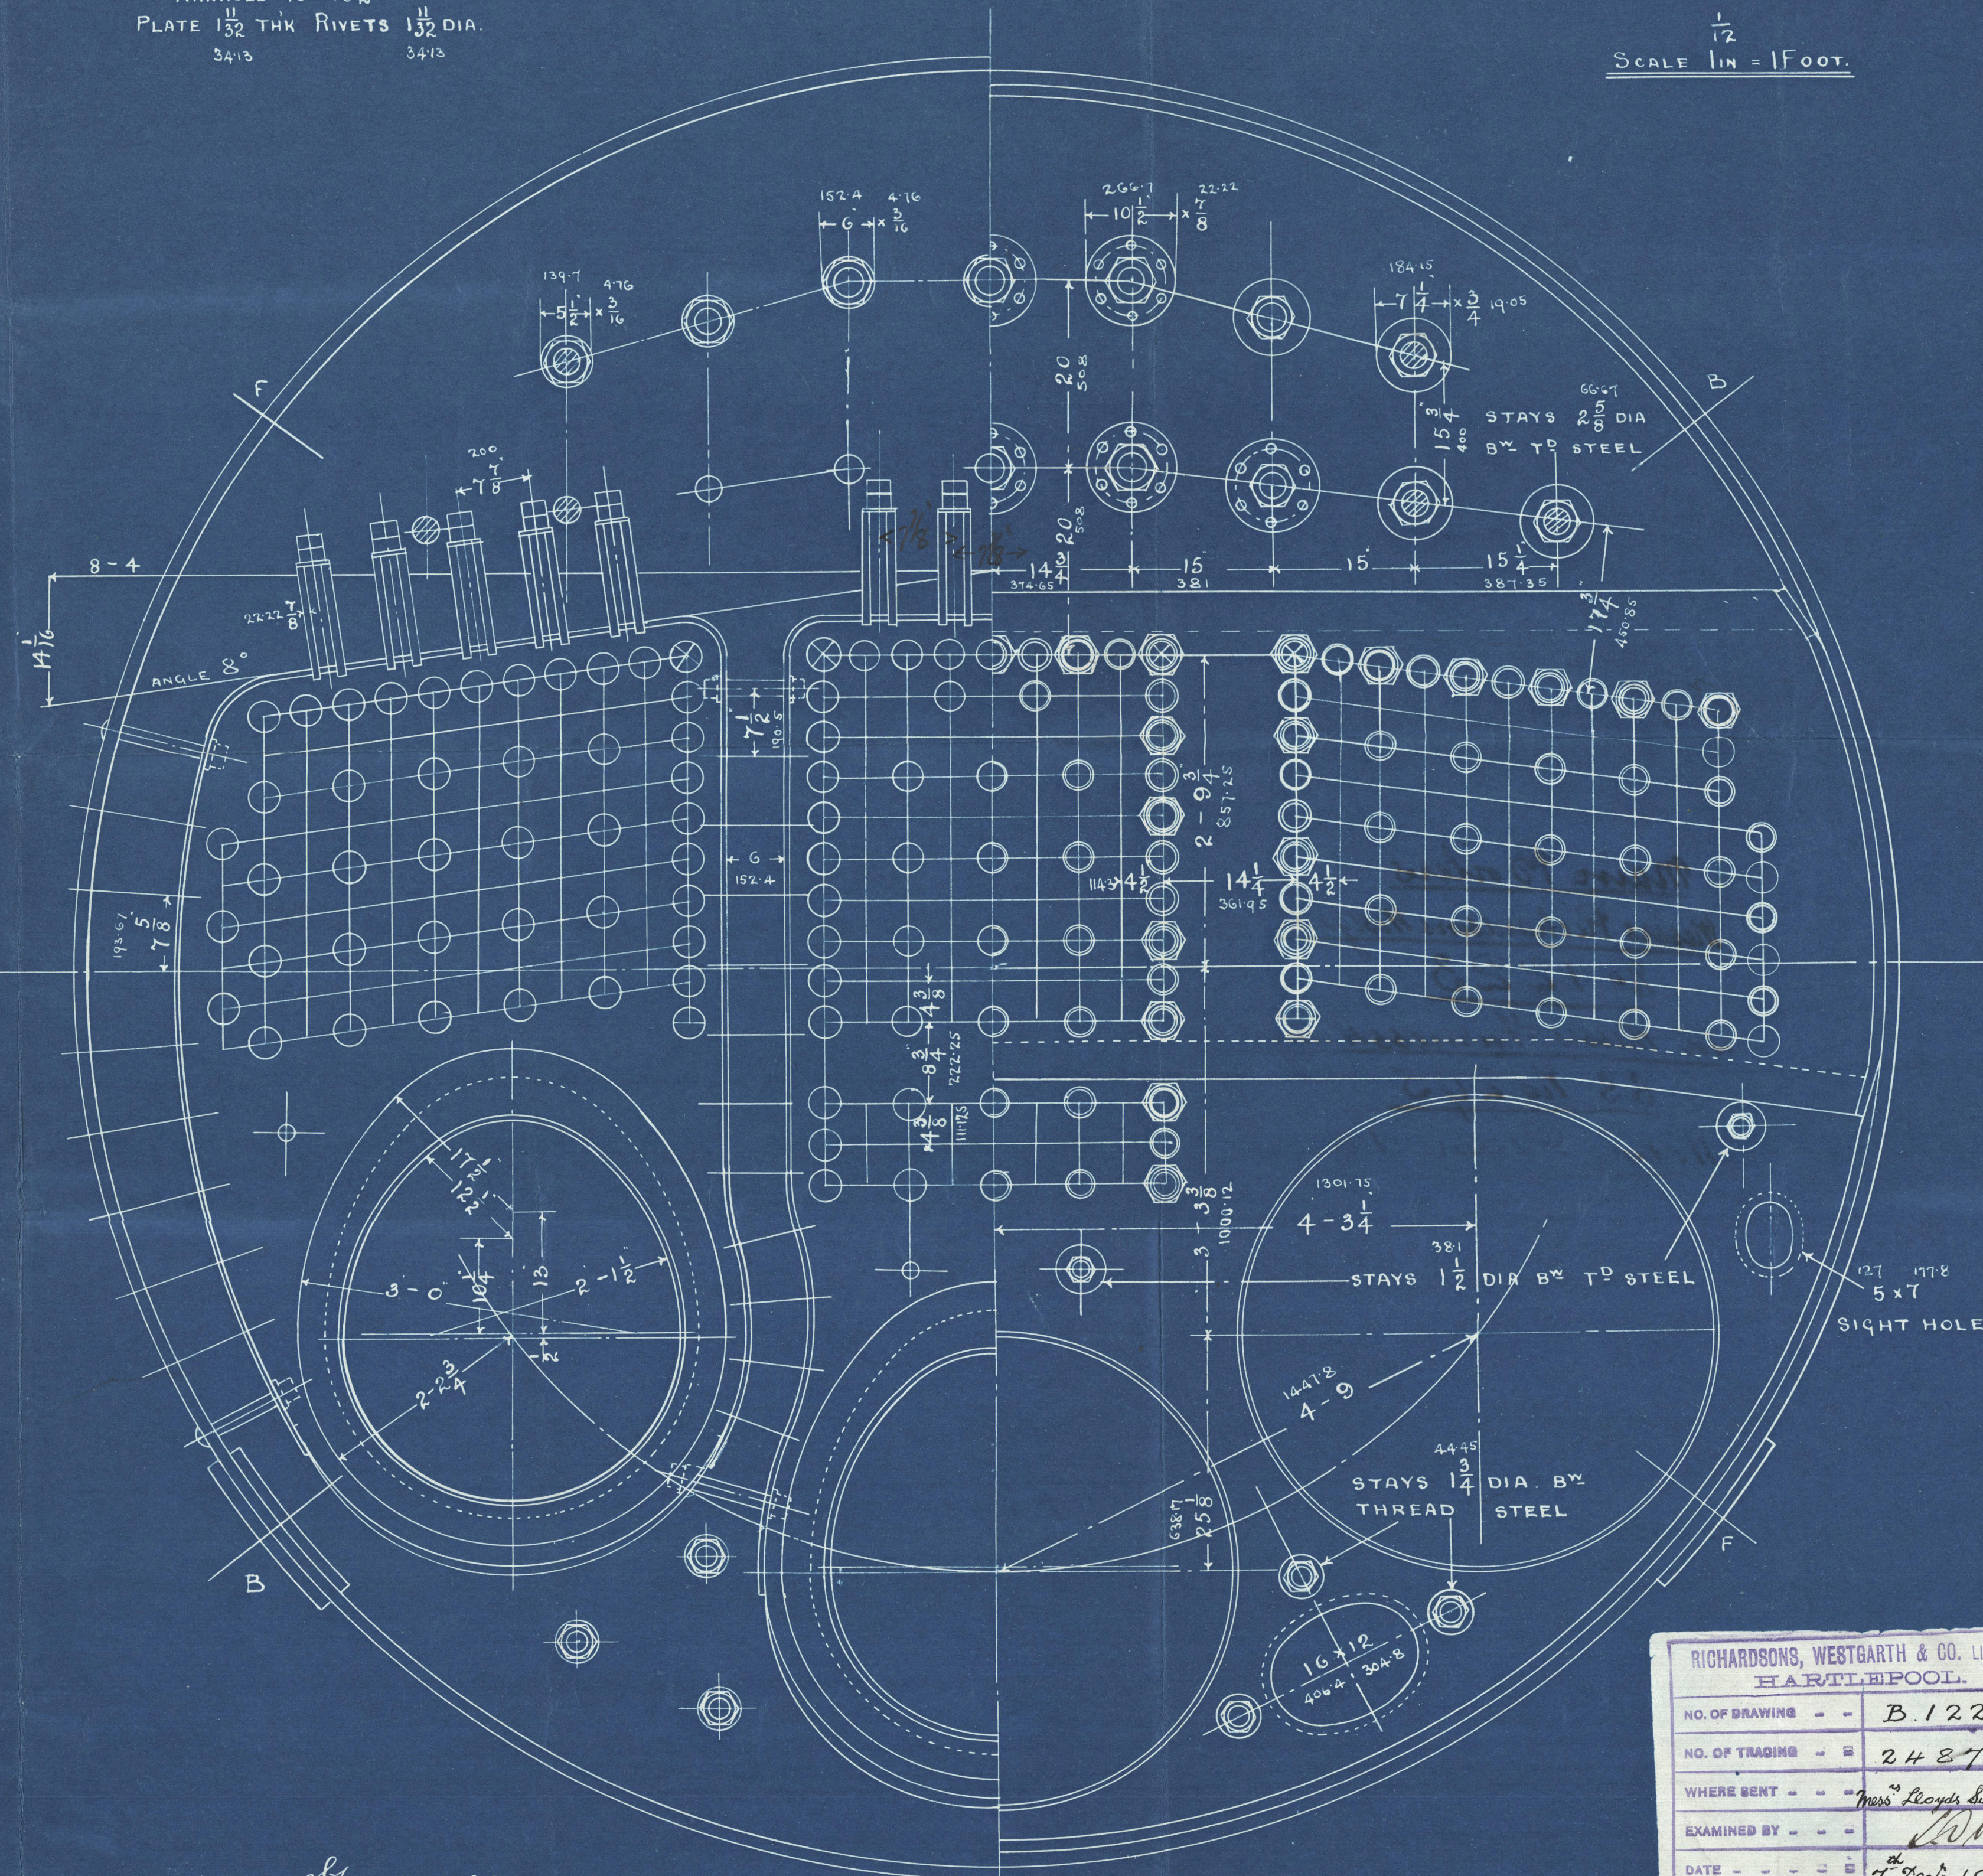

S.S. "Harpenden".
Hpl. Report No. 13065.

RETAIN



© 2020

Lloyd's Register
Foundation

W893-0103