

MIDSHIP SECTION.

LENGTH B.P. 347'-0" BEAM MOULDED 47'-3" D.M. 27'-10 1/2"

SCALE 1/2" = 1 FOOT.

30-1-05

13-9-08

27-9-05

6-10-05

POOP DECK.


BEAMS 6" x 3 1/2" ANGLES ON EVERY FRAME
STRINGER PLATE 36" x 1/2"
STRINGER ANGLE 3 1/2" x 3 1/2" x 1/2"
DECK 9/16"

BRIDGE DECK.

BEAMS 6" x 3 1/2" B.A. ON EVERY FRAME, CLEAR OF OPENINGS.
HALF BEAMS 6" x 3 1/2" ANGLES ON EVERY FRAME IN WAY OF OPENINGS.
THROUGH BEAMS IN ENGINE SPACE 9" x 3 1/2" BULB ANGLES
STRINGER PLATE 48" x 1/2"
STRINGER ANGLE 3 1/2" x 3 1/2" x 1/2"
DECK 9/16"

FORECASTLE DECK.

BEAMS 6" x 3 1/2" B.A. ON EVERY FRAME.
BEAMS 8" x 5 1/2" BULB TEE UNDER WINDLASS.
STRINGER ANGLE 3 1/2" x 3 1/2" x 1/2"
DECK 9/16" WITH WOOD SHEATHING.

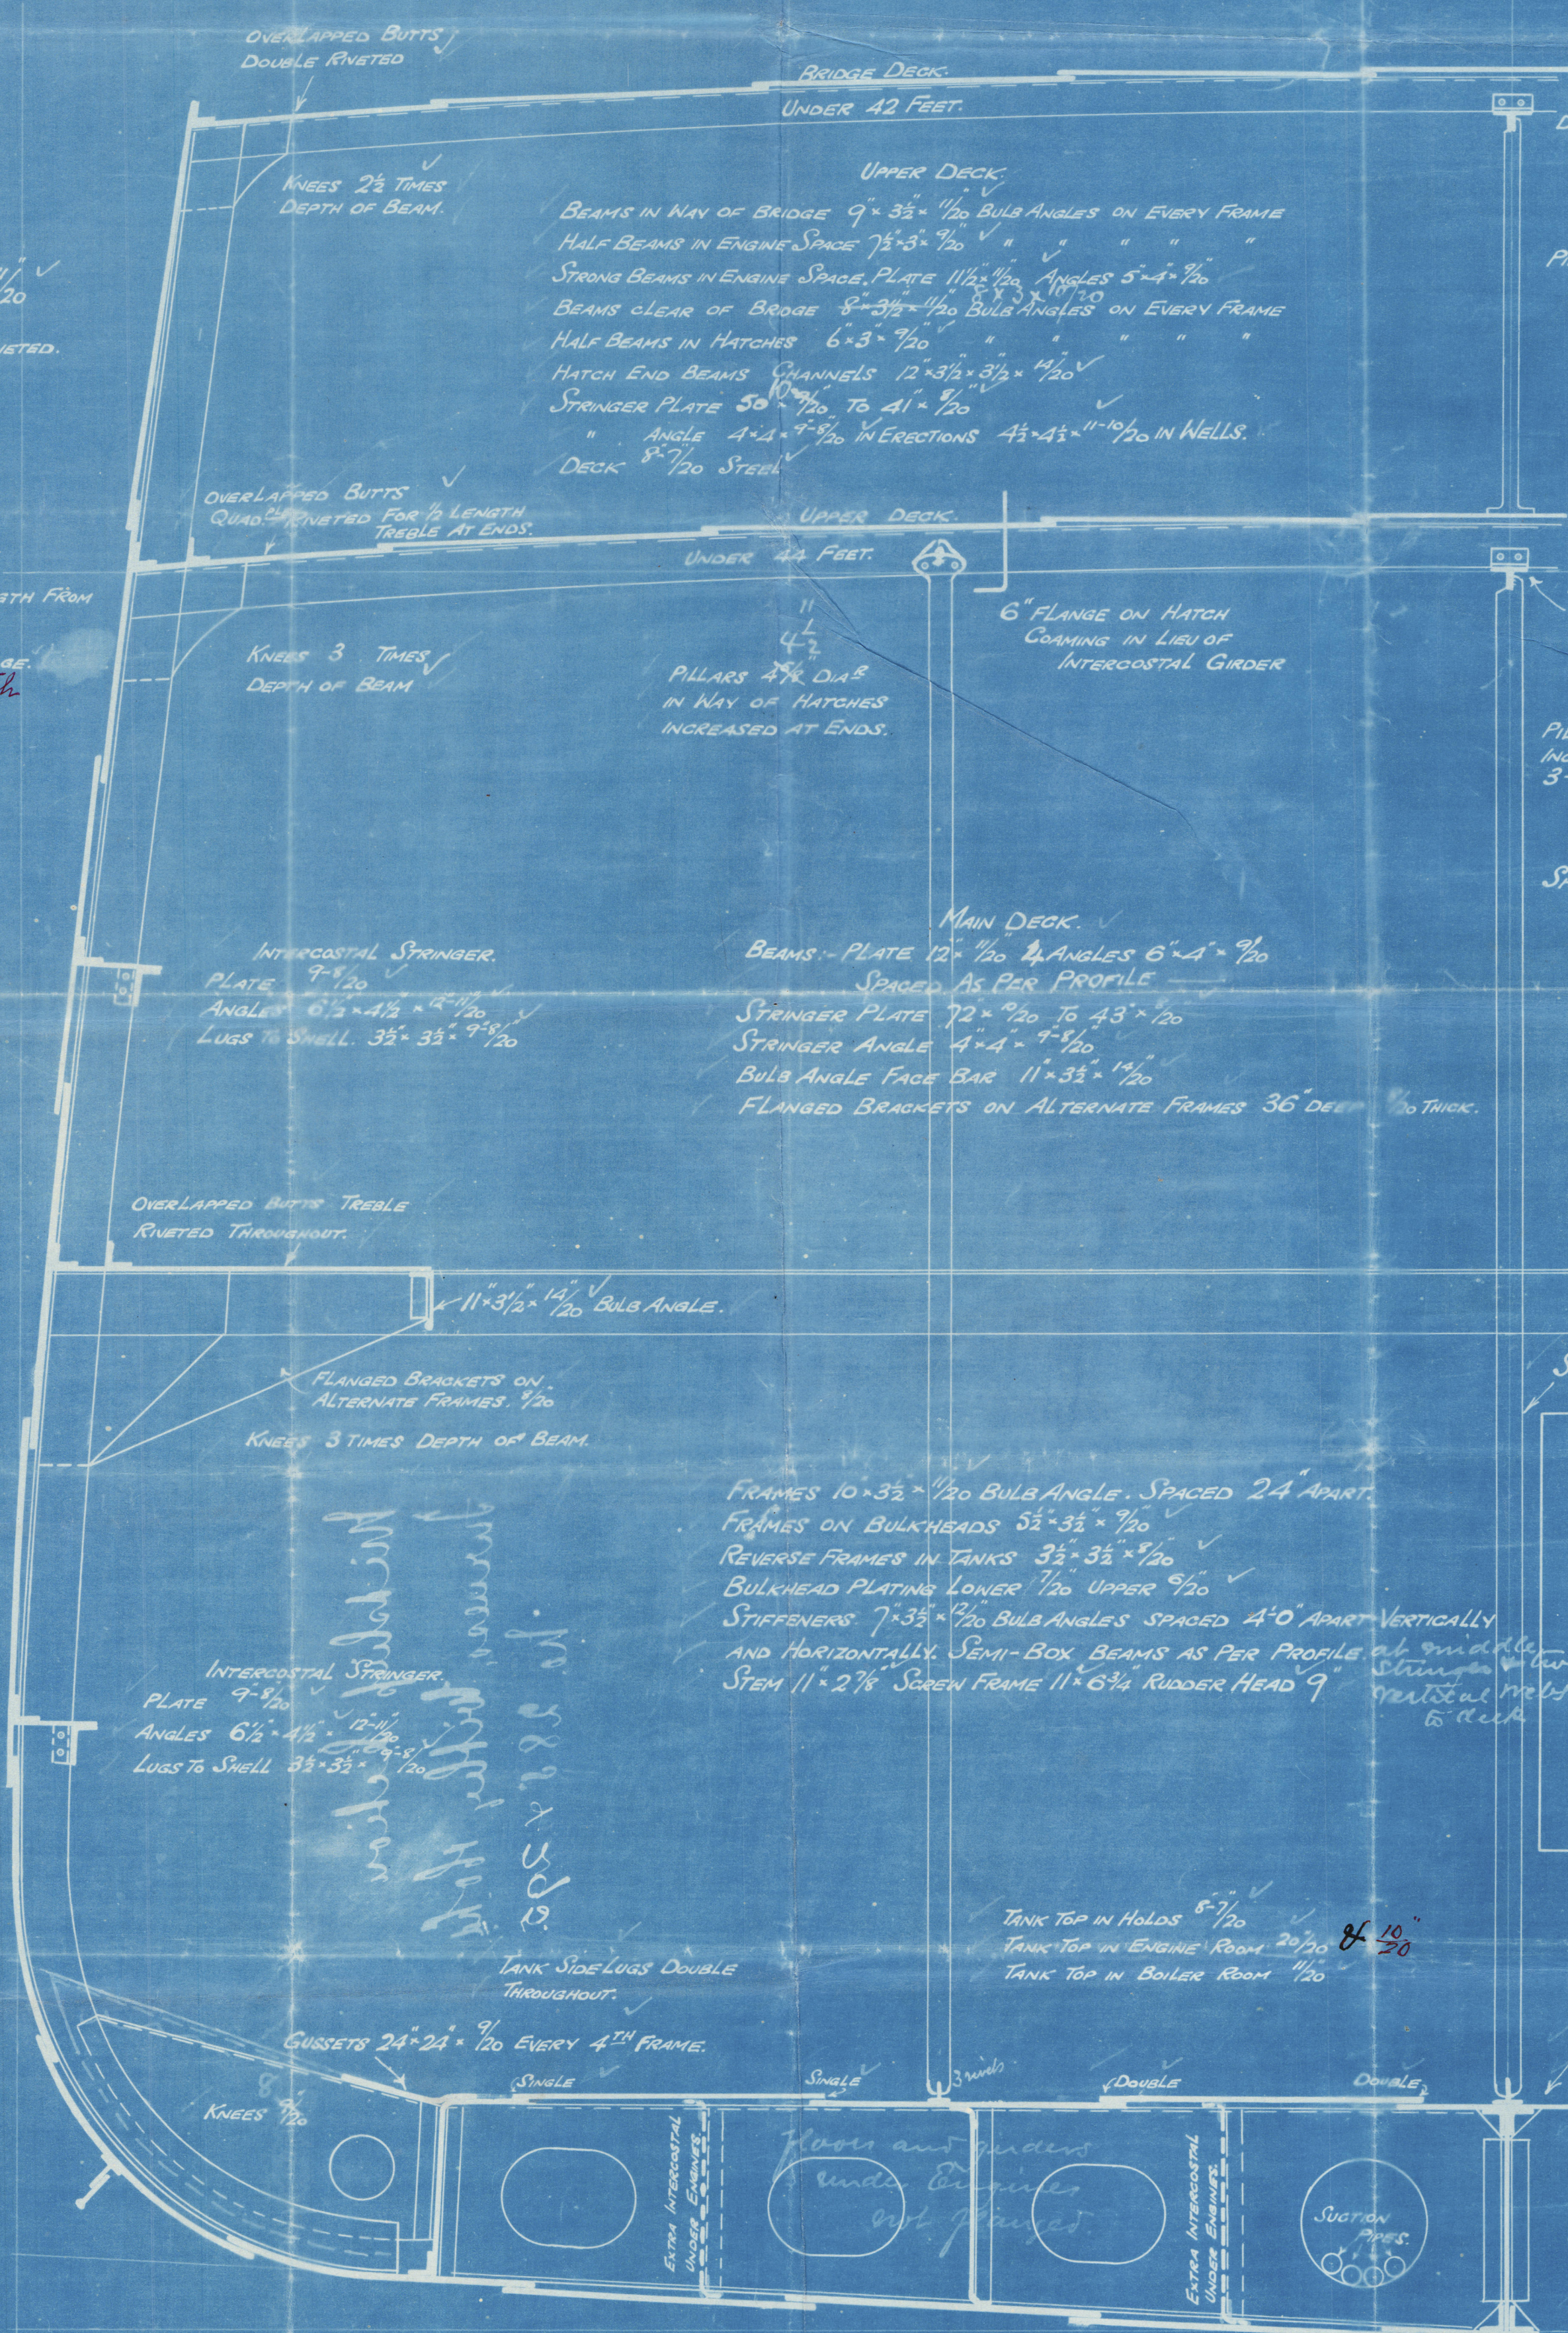

LLOYD'S NUMERALS	
HALF BEAM MOULDED	23-7 1/2"
DEPTH OF HOLD & FLOORS	28-9 1/2"
HALF GIRTH	48-4"
FRAME NUMBER	93-9"
LENGTH PER RULE	345-2"
PLATING NUMBER	32358
EQUIPMENT NUMBER	36715
DEPTHS IN LENGTH	11-99
CLASS 100 A.1 THREE D.K.	

SHELL BUTTS QUADRUPLE RIVETTED FOR 1/2 LENGTH WHERE OVER RULE WIDTH.

TANK SIDE 34" x 1/2" ANGLE 4" x 4" x 1/2" BUTTS DOUBLE RIVETTED THROUGHOUT.

FLOORS FLANGED TOP & BOTTOM 9/16"
" UNDER ENGINES FLANGED AT BOTTOM.
" BOILERS FLANGED " 10/16"
TANK INTERCOSTALS FLANGED TOP & BOTTOM 9/16" UNDER BOILERS 10/16"
VERTICAL LUGS ON FLOORS 3 1/2" x 3 1/2" x 1/2"
ALL PARTS OF DOUBLE BOTTOM INCREASED IN BOILER SPACE AS PER TABLE S.7.

48 1/2"
TANK TOP CENTRE 42" x 10 1/2"
BUTTS DOUBLE RIVETTED THROUGHOUT.
DOUBLE ANGLES 4" x 4" x 1/2"
CENTRE KEELSON 42" x 10 1/2"
BUTTS TREBLE RIVETTED THROUGHOUT.
DOUBLE ANGLES 4 1/2" x 4 1/2" x 12-11/16"

NO 285

30/10/05
6-10-05

FURNERS, WILKIN & CO. LIMITED

WEST HARTLEPOOL

Jan 19th 1905

Lloyd's Register Foundation

W893-0104

"Malvern Range"

Hpl. Report No 12947



Midship section
(Copy)

RETAIN



© 2020

Lloyd's Register
Foundation

W893-0104