

No. 272.

Midship Section.

Length B.S. 267-0

Breadth moulded 37-9

Depth moulded 19-10 1/2

Quarter Deck above Main Deck 4-6

Scale 1/2" = 1 Foot.



29.8.13.

9.9.13.

Raised Quarter Deck 30 steel

Bridge Deck 26 sheathed with 3 pine in way of accommodation
Forecastle 25 " " "

Stringer plate 41 x 34
" angle 3 x 3 x 34

Stringer plate 72 x 48 for 1/2 length
to 26 x 38 at after end
Stringer increased at hatches
as per profile

Hatch Side Coamings 50
" end 40
" webs 40

Bridge Deck Beams 5 1/2 x 3 x 34 built angles on every frame, knees 14 x 34
Forecastle " " 8 x 3 x 42 " " on alternate frames " 19 x 40

Main Deck 34 to 30

Bulwarks 25
Butts single riveted

3 lap, 1 1/2" at after end of bridge

Sheer strakes 54 x 54 for 1/2 length
to 40 at after end, increased 20
at after end of bridge
Butts double riveted

Pillars 4 dia: under 22-0
increased according to length

Brackets 35 at Hatch Sides in lieu of Pillars

Quarter Deck through beams 7 x 3 x 40 built angles on every frame, knees 21 x 40
Half beams in way of hatches 5 1/2 x 3 x 34 " " " " " " " "

Frames in way of Quarter Deck 9 x 3 x 52 built angles, spaced 23 1/2 apart.

50 to 40 + .04 = 54 to 44
40 in after peak
Butts double riveted

50 to 40 + .04 = 54 to 44
40 in peaks

50 to 40 + .04 = 54 to 44
40 in peaks

50 to 40 + .04 = 54 to 44
40 in peaks

50 to 40 + .04 = 54 to 44
40 in peaks

Numerals.

Length 266.75 feet
Breadth 37.75 "
Depth 19.87 "
B + D = 57.62 Transverse W
L(B + D) = 15370 Longitudinal W
L to Main Deck = 13.40
L to Quarter Deck = 10.90
d to Main Deck 16.96, to Quarter Deck 21.46

Equipment No. 16308

2 Bowers 33 cwt stockless
1 Bower 28 " "
1 Stream 8 1/2 " ex stock
1 Kedge 4 1/2 " " "
240 fathoms 1 1/16 stud chain
75 " 1 1/16 stream "
90 " 3 1/2 steel wire
90 " 6 or 2 1/4 " } 2 of
90 " 5 or 2 " } each

more consent
steel wire

Margin plate 27 x 36
Butt laps double riveted throughout
Brackets 40 flanged
10 rivets 3/4 dia: through frame
5 " " " lugs

Centre girder 35 x 44 to 36
50 dia: 1/16 iron in boiler space
Butts double riveted for 3/4 aft

Pillars 5 1/2 dia: under 18-0
increased according to length

Middle line strake 35 x 40 to 34 steel, or 1/16 iron.
in boiler space 48 steel or 9/16 iron
Butts double riveted

Line of Engine bed plate

Margin plate 26 x 36, 46 in Boiler space
Butt laps double riveted throughout
Brackets 40 flanged, 50 in Boiler space
10 rivets 3/4 dia: through frame
5 " " " lugs

Bridge & Forecastle sides 34
Butts double riveted

3 lap

34 Increased at fore end of bridge
Butts double riveted
Bulwarks 25, butts single riveted

3 lap, 1 1/2" at ends of bridge

Sheer strakes 43 x 76 for 1/2 lth to
40 at fore end, doubled as per profile
Butts quadruple riveted for 1/2 length
treble at ends

5 1/2 lap

43 x 58 for 1/2 lth to 40 at ends
+ .04 for no stringers = 62 to 44
40 in Brakes
Butts treble riveted

5 1/2 lap

50 to 40 + .04 for no stringers
= 54 to 44 40 in Brakes

5 1/2 lap

50 to 40 + .04 for no stringers
= 54 to 44 40 in Brakes

5 1/2 lap

50 to 40

4 x 4 x 36 angle
46 in Boiler space

5 1/2 lap

Jet bar 6 x 4 x 50
Bolt 8 x 40

5 1/2 lap

50 to 40

50 to Collision bulkhead






29.8.13.

Sunderland
Mess^r. Austin's 272


Midship Section.





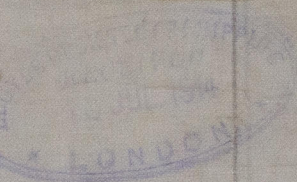
















RE

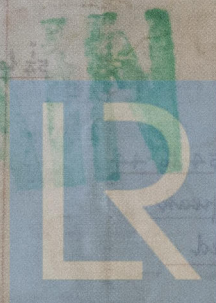

© 2021

Lloyd's Register
Foundation

W5914-0066