
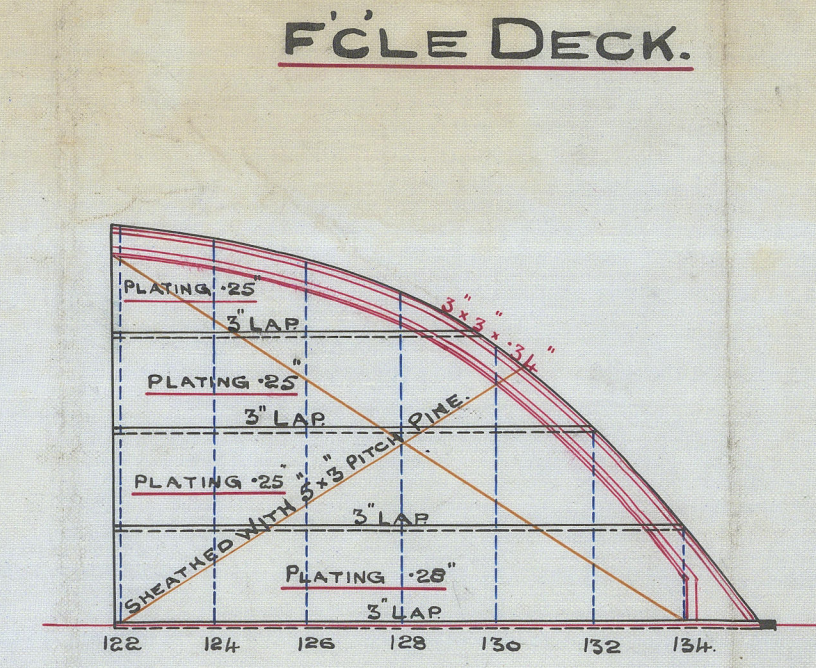



10. Report No. 2521

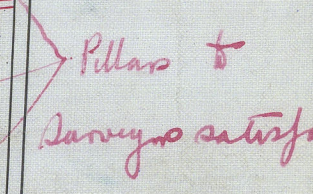

— SCALE $\frac{1}{8}'' = 1 \text{ FOOT.}$ —

J. P. AUSTIN & SON, LTD.
22/8/13
STEEL & IRON SHIPBUILDERS
AND
REPAIRERS
J.S.I.
SUNDERLAND


ju
29.8.13

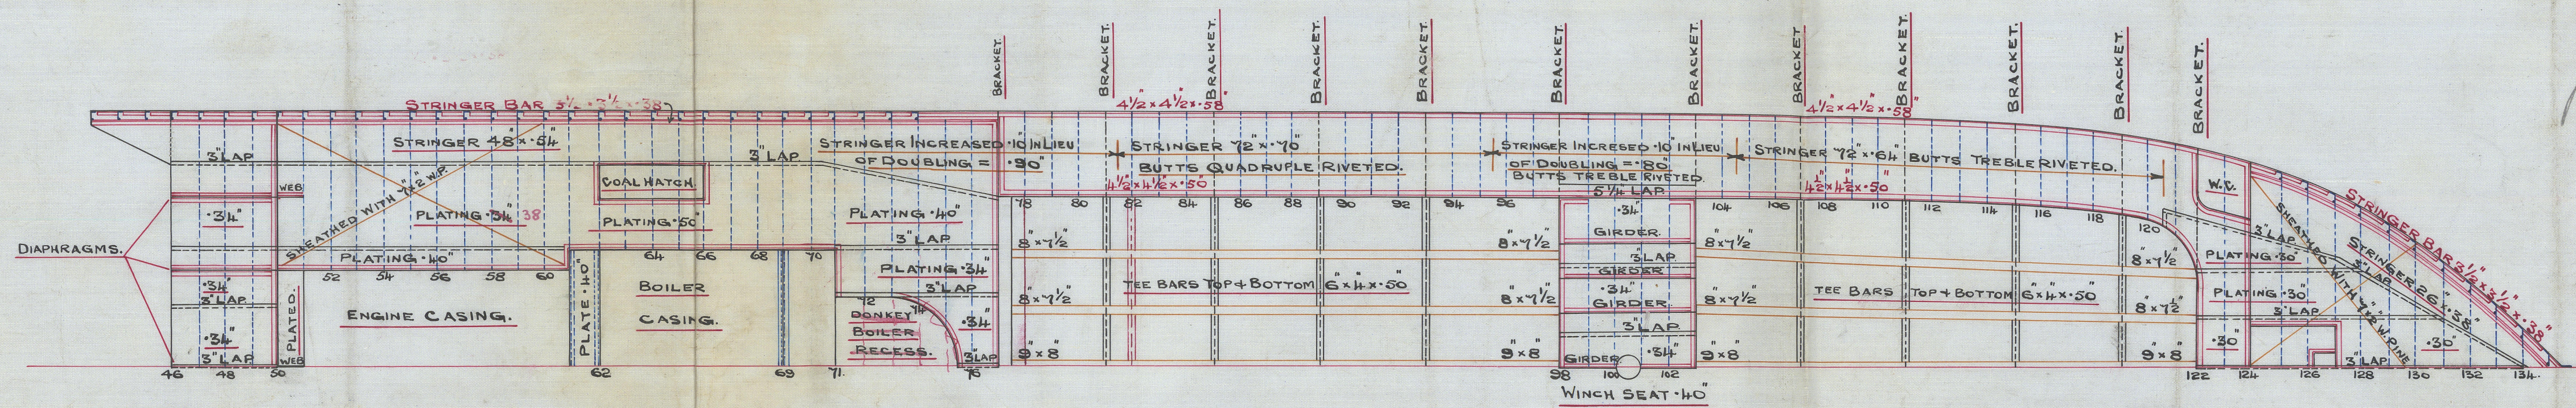

Sunderland
Messrs Austin's 272
Profile and Deck Plans.

R.S. DOUGLAND

No. Report No. 26221

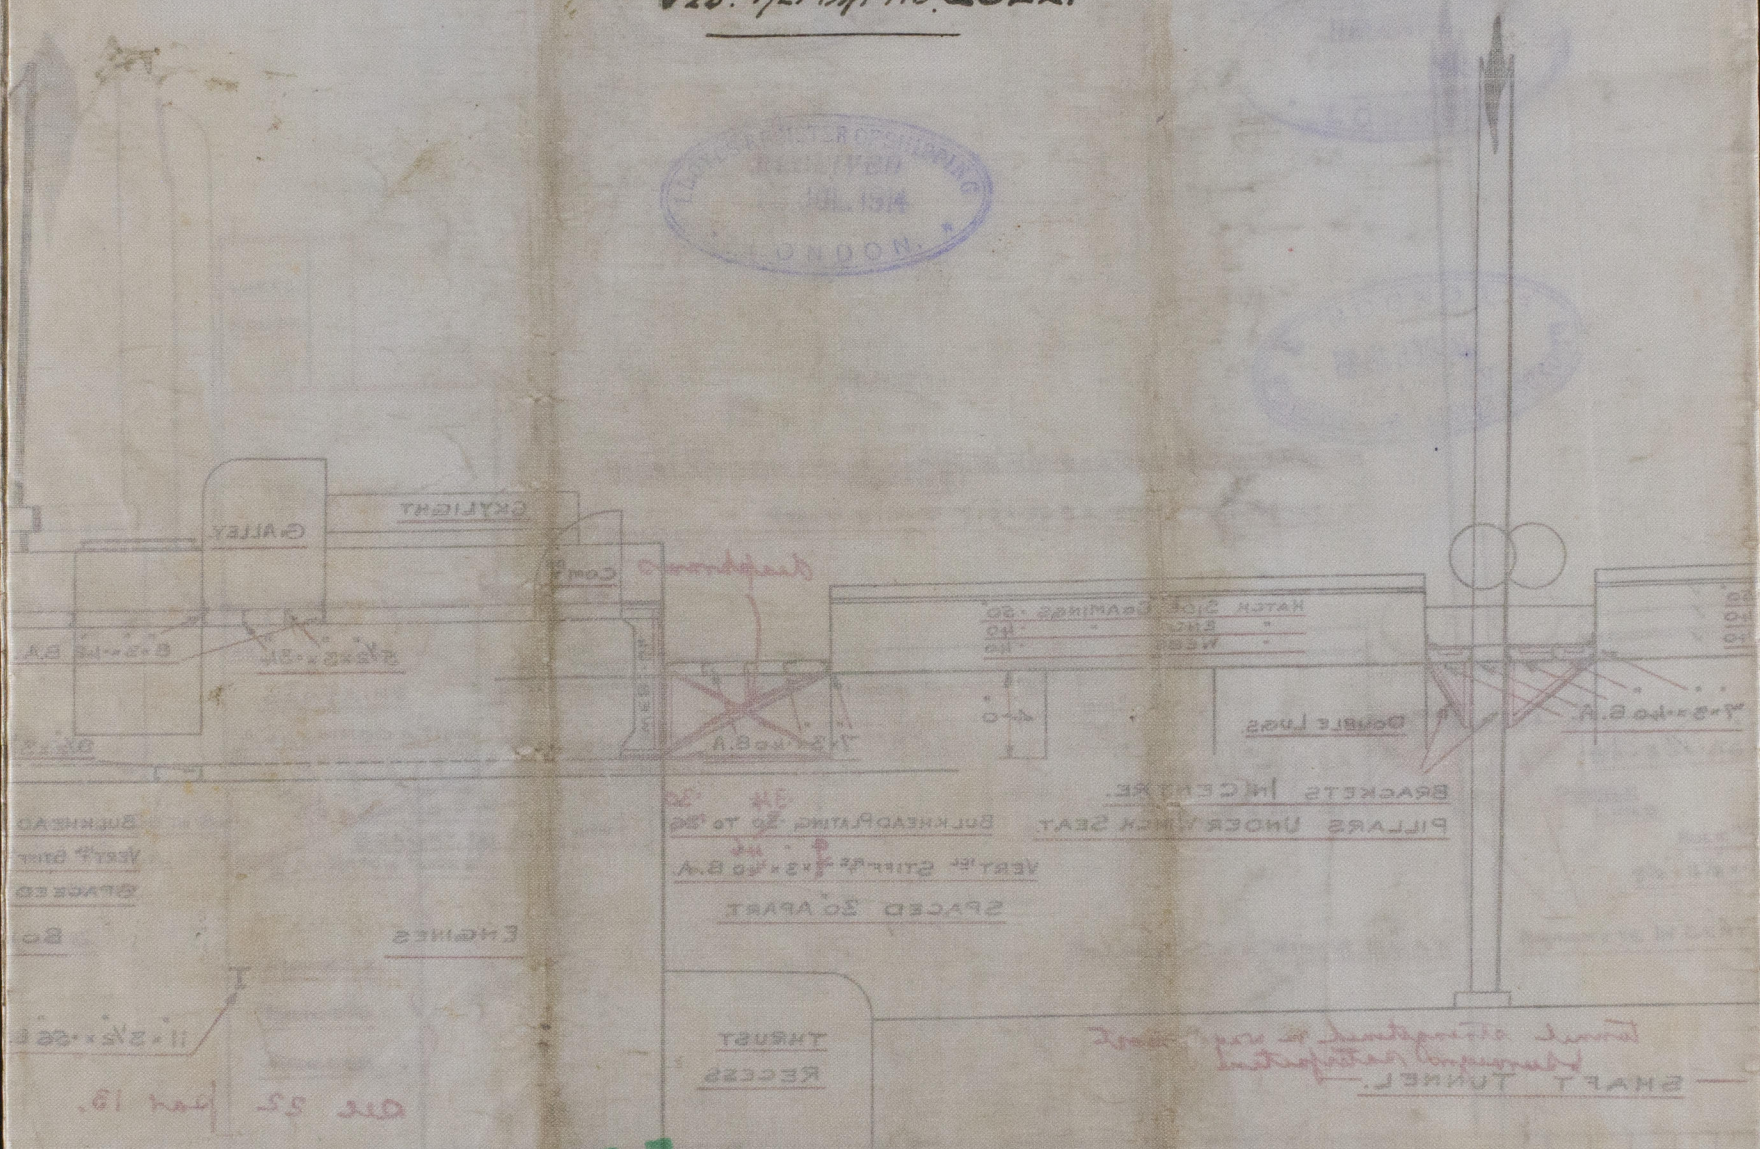

RETAIN



© 2021

Lloyd's Register
Foundation

W894-0067