



12.5.14.

S.S. N°13. LONGITUDINAL SECTION.


Dim: 153'-0" x 25'-0" x 11'-11" M.D.

TO CLASS 100 A1 LLOYDS.

Scale 1/8" = 1 FT.

SHIPBUILDING & REPAIRS
JARD. DE MERVEUE LTD
HARDINXVELD
6/5 HOLLAND.

*Cellaring throughout to
Surveyor's satisfaction*

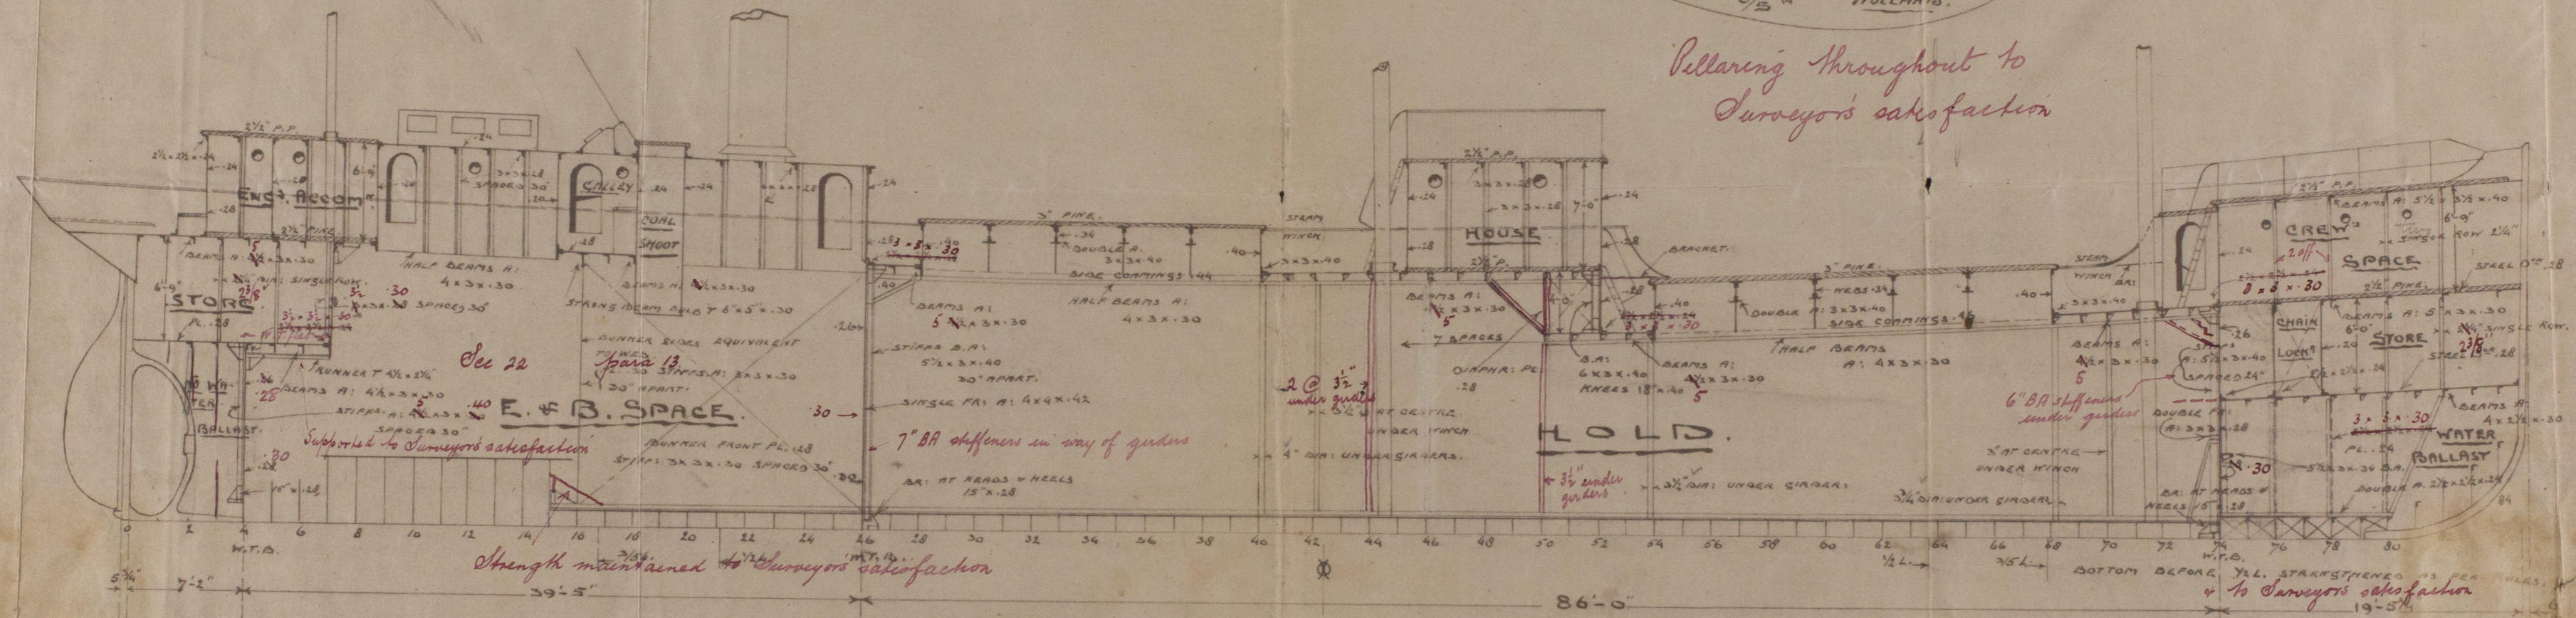

See 22

Para 13

Support to Surveyor's satisfaction

Strength maintained to Surveyor's satisfaction


7" BA stiffeners in way of girders


2 @ 3 1/2" under girders

3 1/2" under girders

6" BA stiffeners under girders

to Surveyor's satisfaction

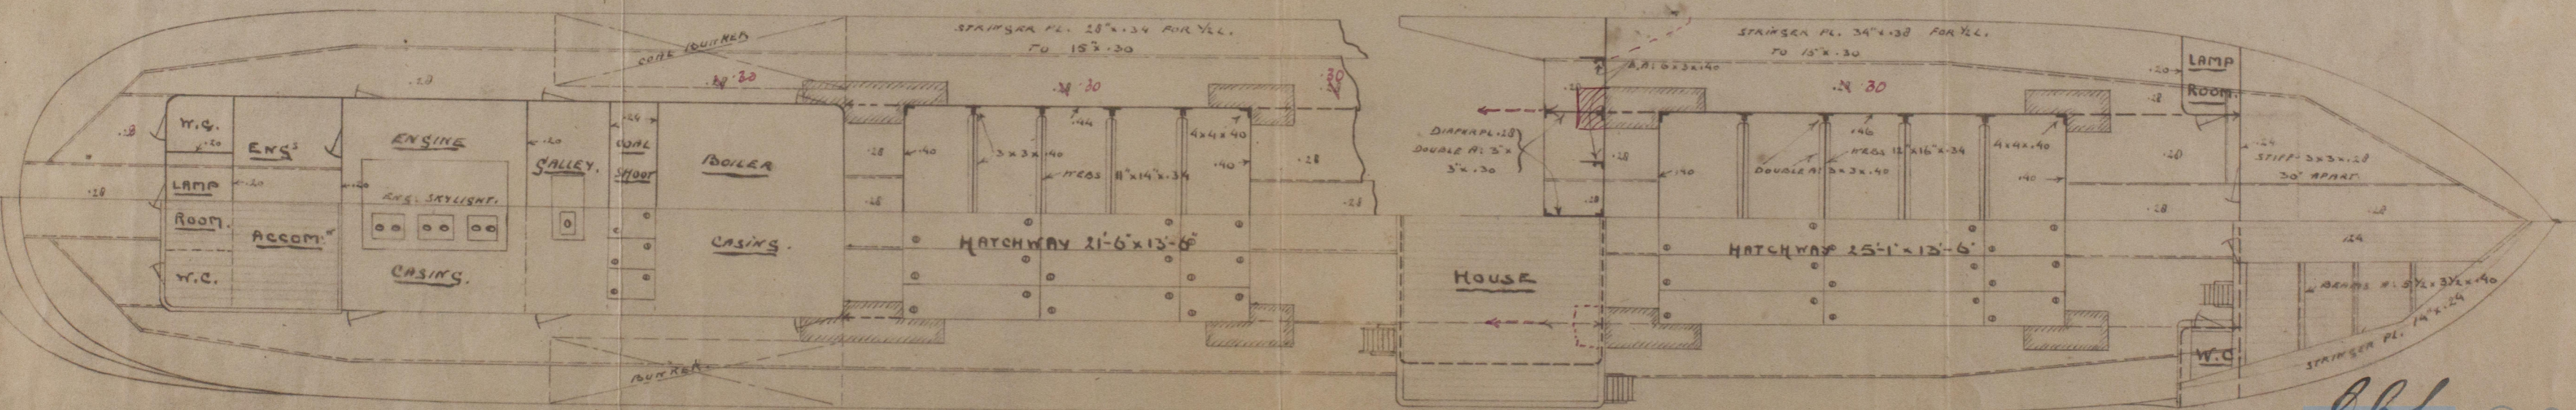

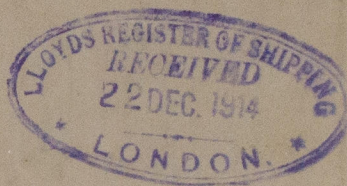

Lt. French
LLOYDS REGISTER OF SHIPPING
RECEIVED
LONDON.

S.S. "Nelly"
Longitudinal Section
and Plan of Deck

Rotterdam Report No 9533

RETAIN



© 2020

Lloyd's Register
Foundation

W 895-0067