



17.10.06

# — N<sup>o</sup> 135 — — MIDSHIP SECTION —

EQUIPMENT			
✓ 1 ANCHOR	6 1/4 CWT	EX STOOK	✓
✓ 1 "	5 3/4 "	" "	✓
✓ 1 "	3 1/4 "	" "	✓
✓ 120 FTMS	1 1/8 "	CABLE	✓
✓ 60 "	6 "	HAWSER	✓
✓ 60 "	5 "	WARP	✓

DIMENSIONS: 137' 6" BP x 22' 9" EX x 12' 6" HOLD


SCALE 1/2" = ONE FOOT

STEEL  
CLASS 100 A.1.

LLOYD'S NOS	
1/2 GIRTH	21.45 ✓
1/2 BREADTH	11.31 ✓
DEPTH	13.81 ✓
	46.57 - 1ST No. ✓
LLOYD'S LENGTH	136.42 ✓
	6353.07 - 2ND No. ✓
L/B = 6.03	L/D = 9.8 ✓

RAISED Q<sup>B</sup> DECK 71' 8" LONG x 12" HIGH  
SCANTLINGS SAME AS MAIN DECK

E & B CASING AS PREVIOUSLY  
APPROVED

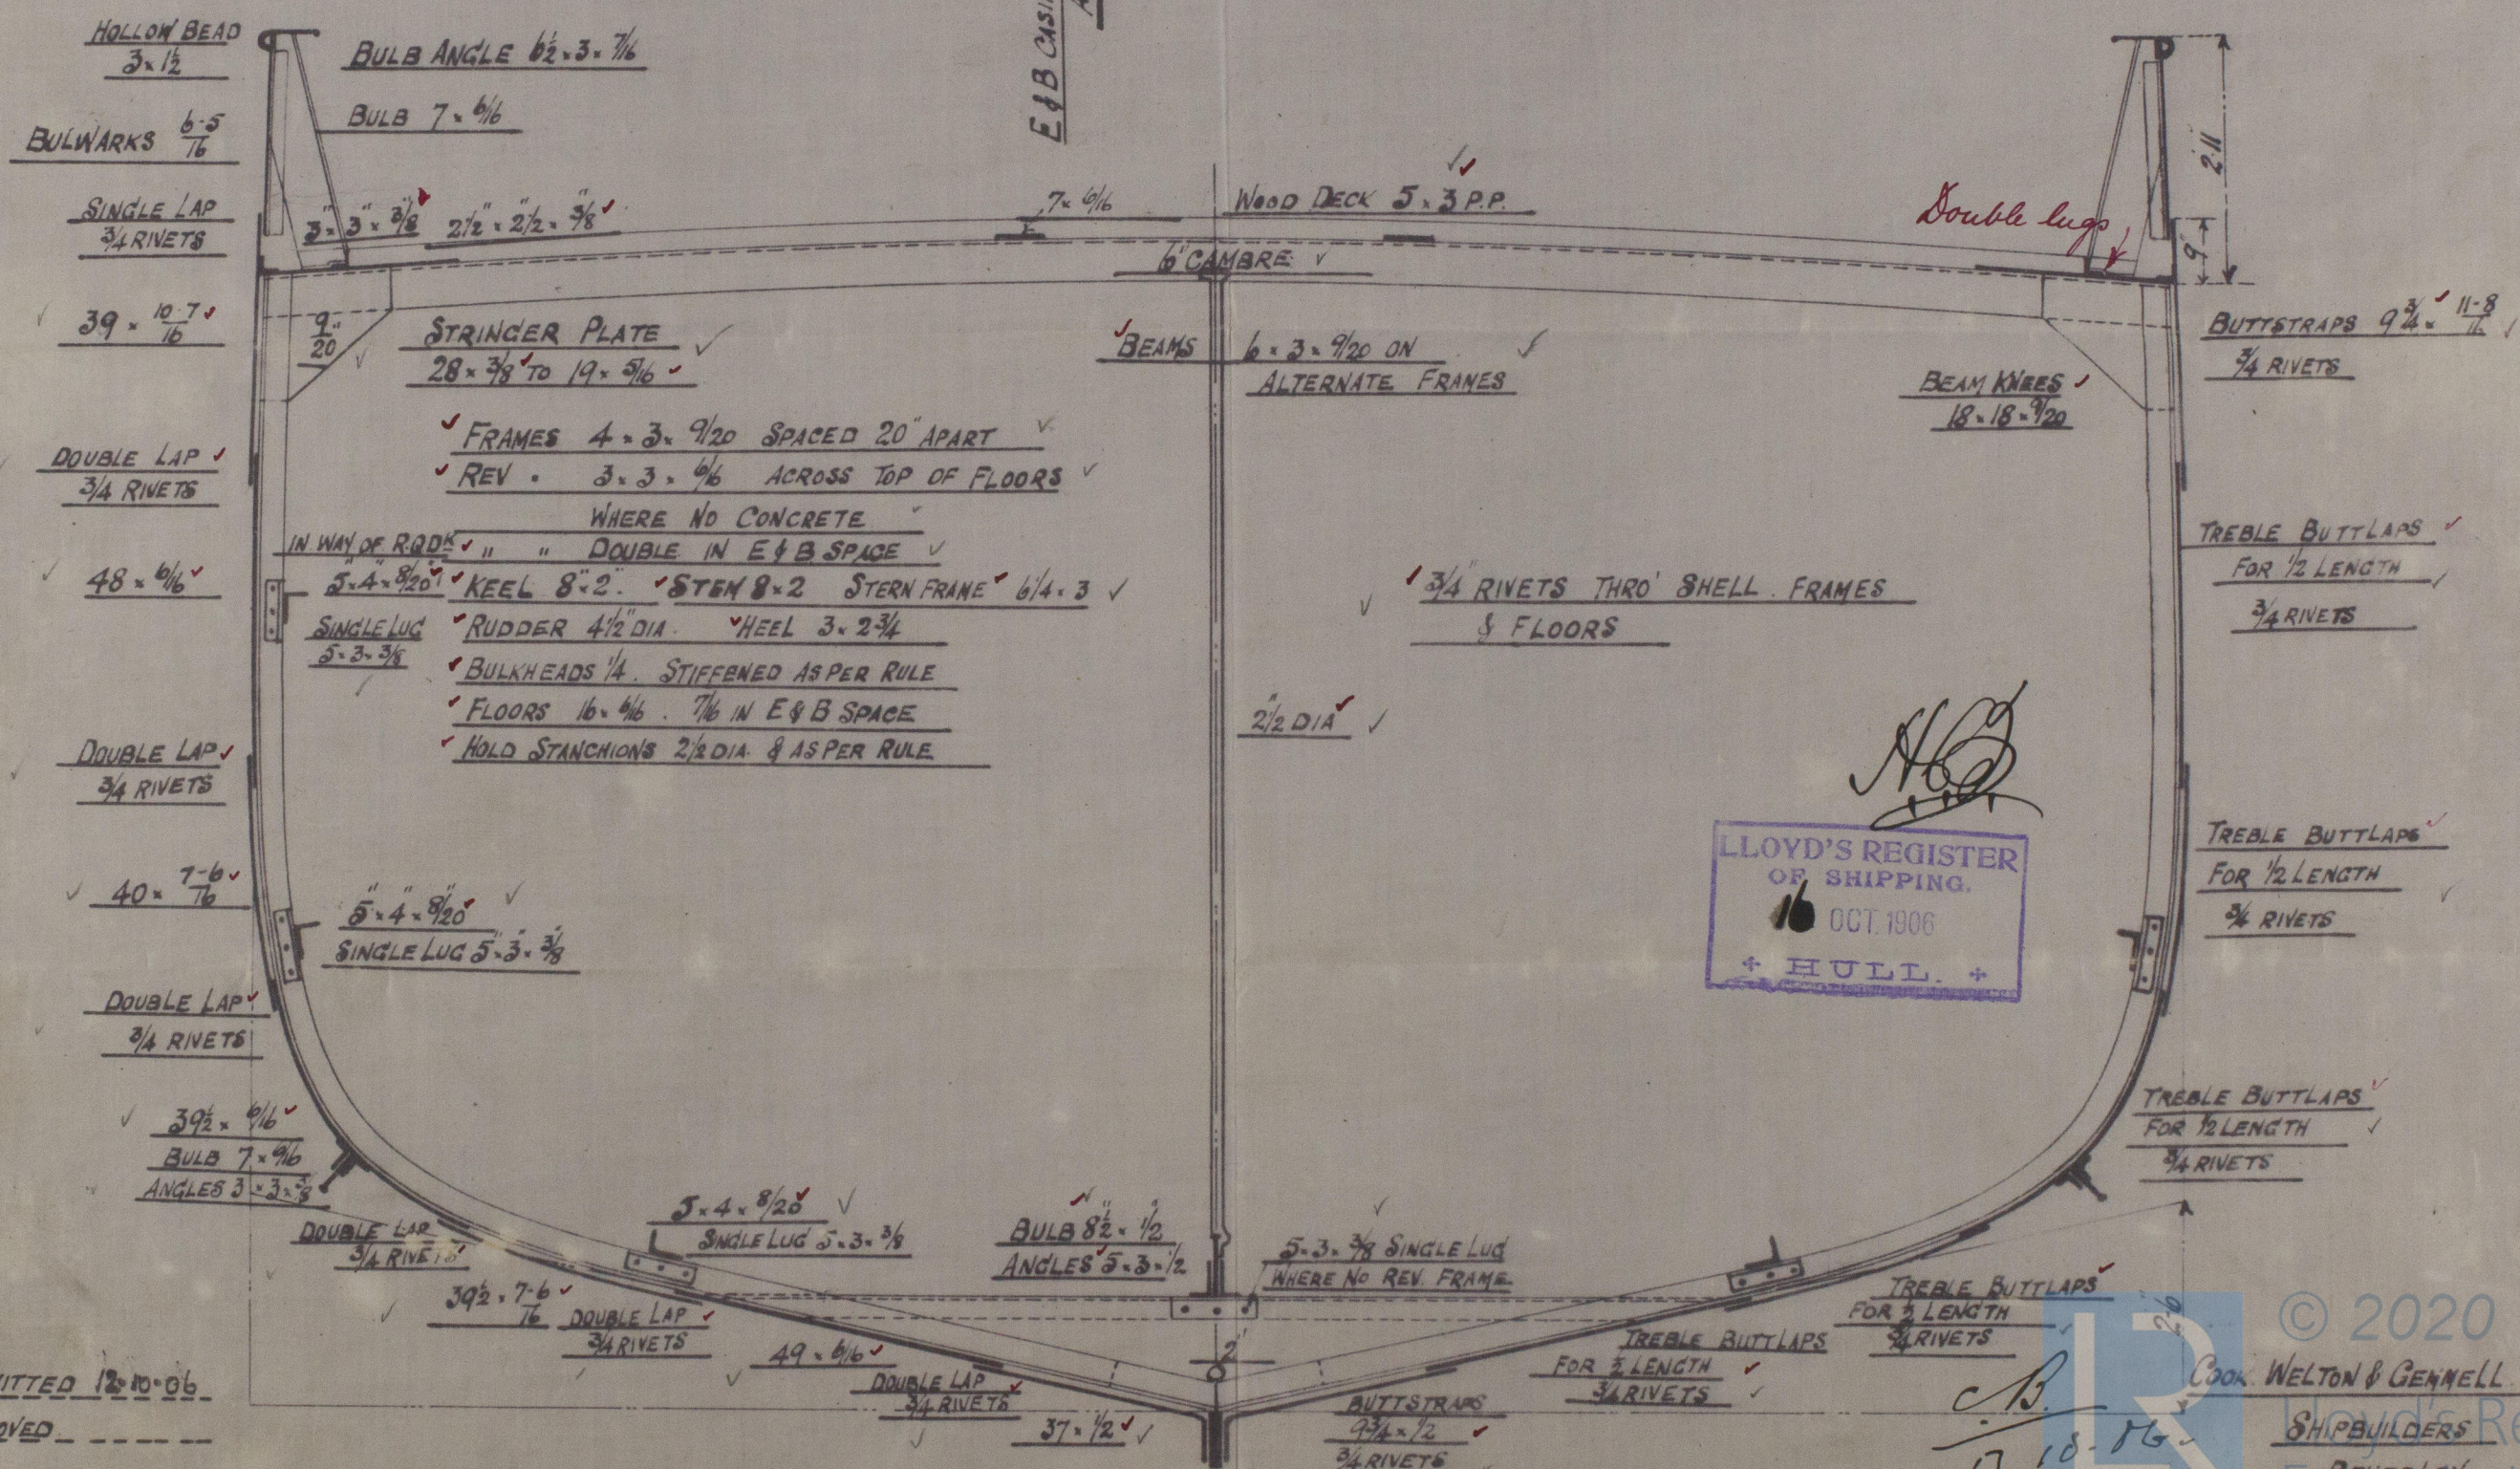

DATE SUBMITTED 12.10.06

APPROVED

LLOYD'S REGISTER  
OF SHIPPING.  
16 OCT. 1906  
+ HULL. +

© 2020  
Cook, WELTON & GENNELL LTD

Shipbuilders Register  
Foundation

W895-0164



Midship Section  
Cook Welton & Gemmell's  
No 135



s/s "Fraser"  
Hull Report No

RETAIN

W895-0164



© 2020

Lloyd's Register  
Foundation