

FAIRFIELD ENGINE WORKS.			
GOVAN, GLASGOW.			
CHECKED	<i>26/8/10</i>		
BY	<i>L.F.</i>		
DEPARTMENT	PRINT ORDERED	PRINT ISSUED	PRINT RETURNED
<i>Boyside</i>	<i>27/8/10</i>		
<i>Board of Trade</i>	<i>do</i>		
<i>Dept. of Civils</i>	<i>do</i>		
<i>" " "</i>	<i>28/8/10</i>		
<i>Department of Works</i>	<i>29/8/10</i>		
<i>of Glasgow &amp; District</i>	<i>29/8/10</i>		
<i>W.C.A.</i>	<i>29/8/10</i>		

NOTE: EVERY PRINT ISSUED MUST  
BE RETURNED TO DRAWING OFFICE  
WHEN WORK IS FINISHED.

## SAFETY VALVES - NATURAL DRAUGHT

2 VALVES - 3  $\frac{11}{16}$  DIA<sup>R</sup>


D.E. BOILER Nº 419.

SCALE 1" = ONE FOOT

WORKING PRESSURE 220 LBS. PER SQ. INCH.




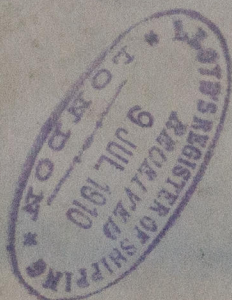

W896-0031



© 2020

Lloyd's Register  
Foundation



W896-0031



© 2020

Lloyd's Register  
Foundation