


28.6.16
21.8.16
8.12.16
1.1.17.
2/9/17 (No 5)

NUMERALS
BREADTH 41.66
DEPTH 20.73
B+D = 62.45
LENGTH 280
Lx(B+D) = 17486

d = 17.96 TO UPPER DECK
L = 13.46 TO UPPER DECK

S.S. No 2
MIDSHIP SECTION
SHOWING MAXIMUM SCANTLINGS.
DIMENSIONS 280'0" x 4'8" x 20'9 1/2" MOULDED


SCALE 1/2" = 1 FOOT
TO CLASS 100 A.I. AT LLOYDS.

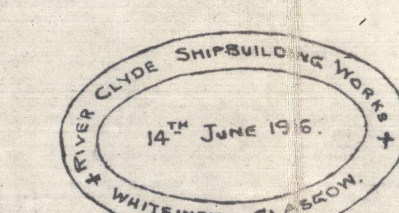


If desired the chumtack might be .18 with stringer increased to .64

EQUIPMENT NUMBER.
HULL = 17486
POOP BRIDGE & FORECASTLE 117 x 7 x .75 = 614
CASING & DECKHOUSES 65 x 7 x .5 = 220
EQUIPMENT No = 18320


EQUIPMENT	
2 BOWER ANCHORS	35% GWTs STOCKLESS.
1 " "	30 " " "
1 STREAM ANCHOR	9 1/4 GWTs EX STOCK.
1 KEDGE ANCHOR	47 1/2 " " "
240 PATIONS 1 1/2" STUD CHAIN GABLE.	
75 " 1 1/2" STREAM " " OR 4" STEEL WIRE.	
90 " 11" HEMP OR 3 1/2" STEEL WIRE.	
2-90 " 6" HAWSER OR 2 1/4" " "	} covers amount to steel wire.
2-90 " 5" WARP. OR 2" " "	

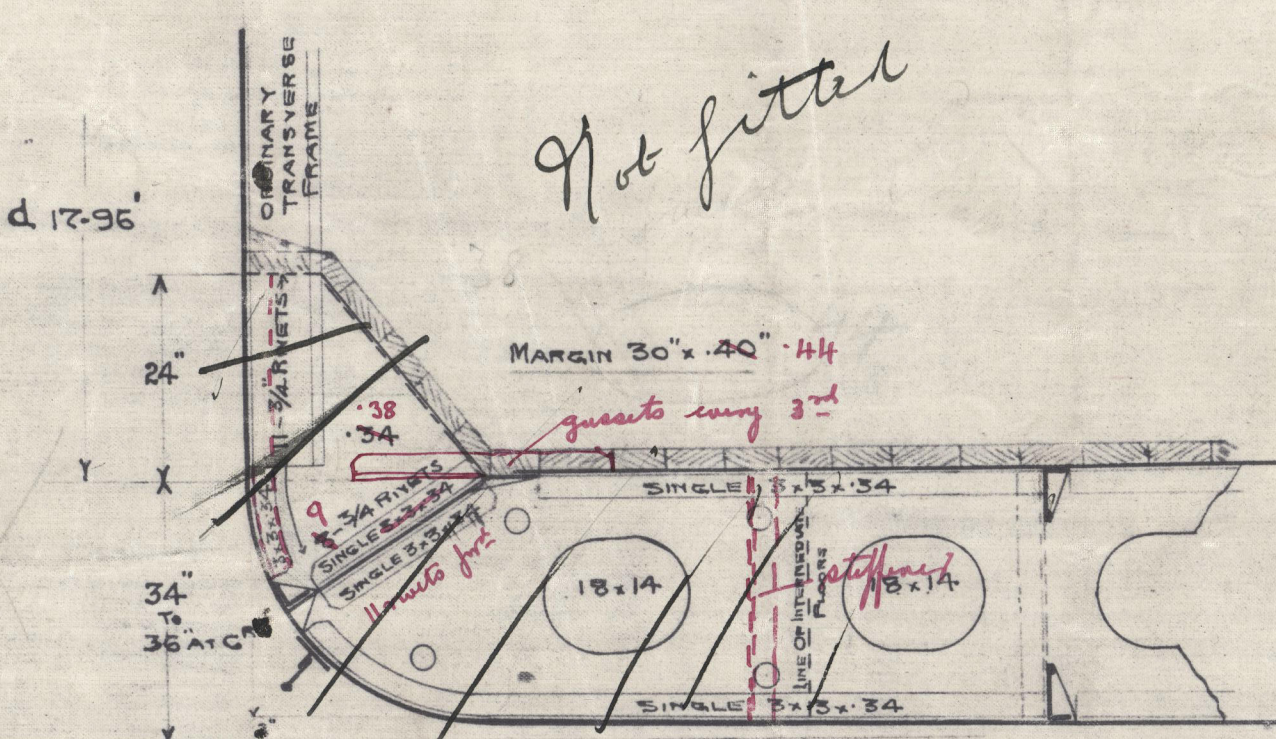


ALTERNATIVE BILGE ARRANGEMENT.

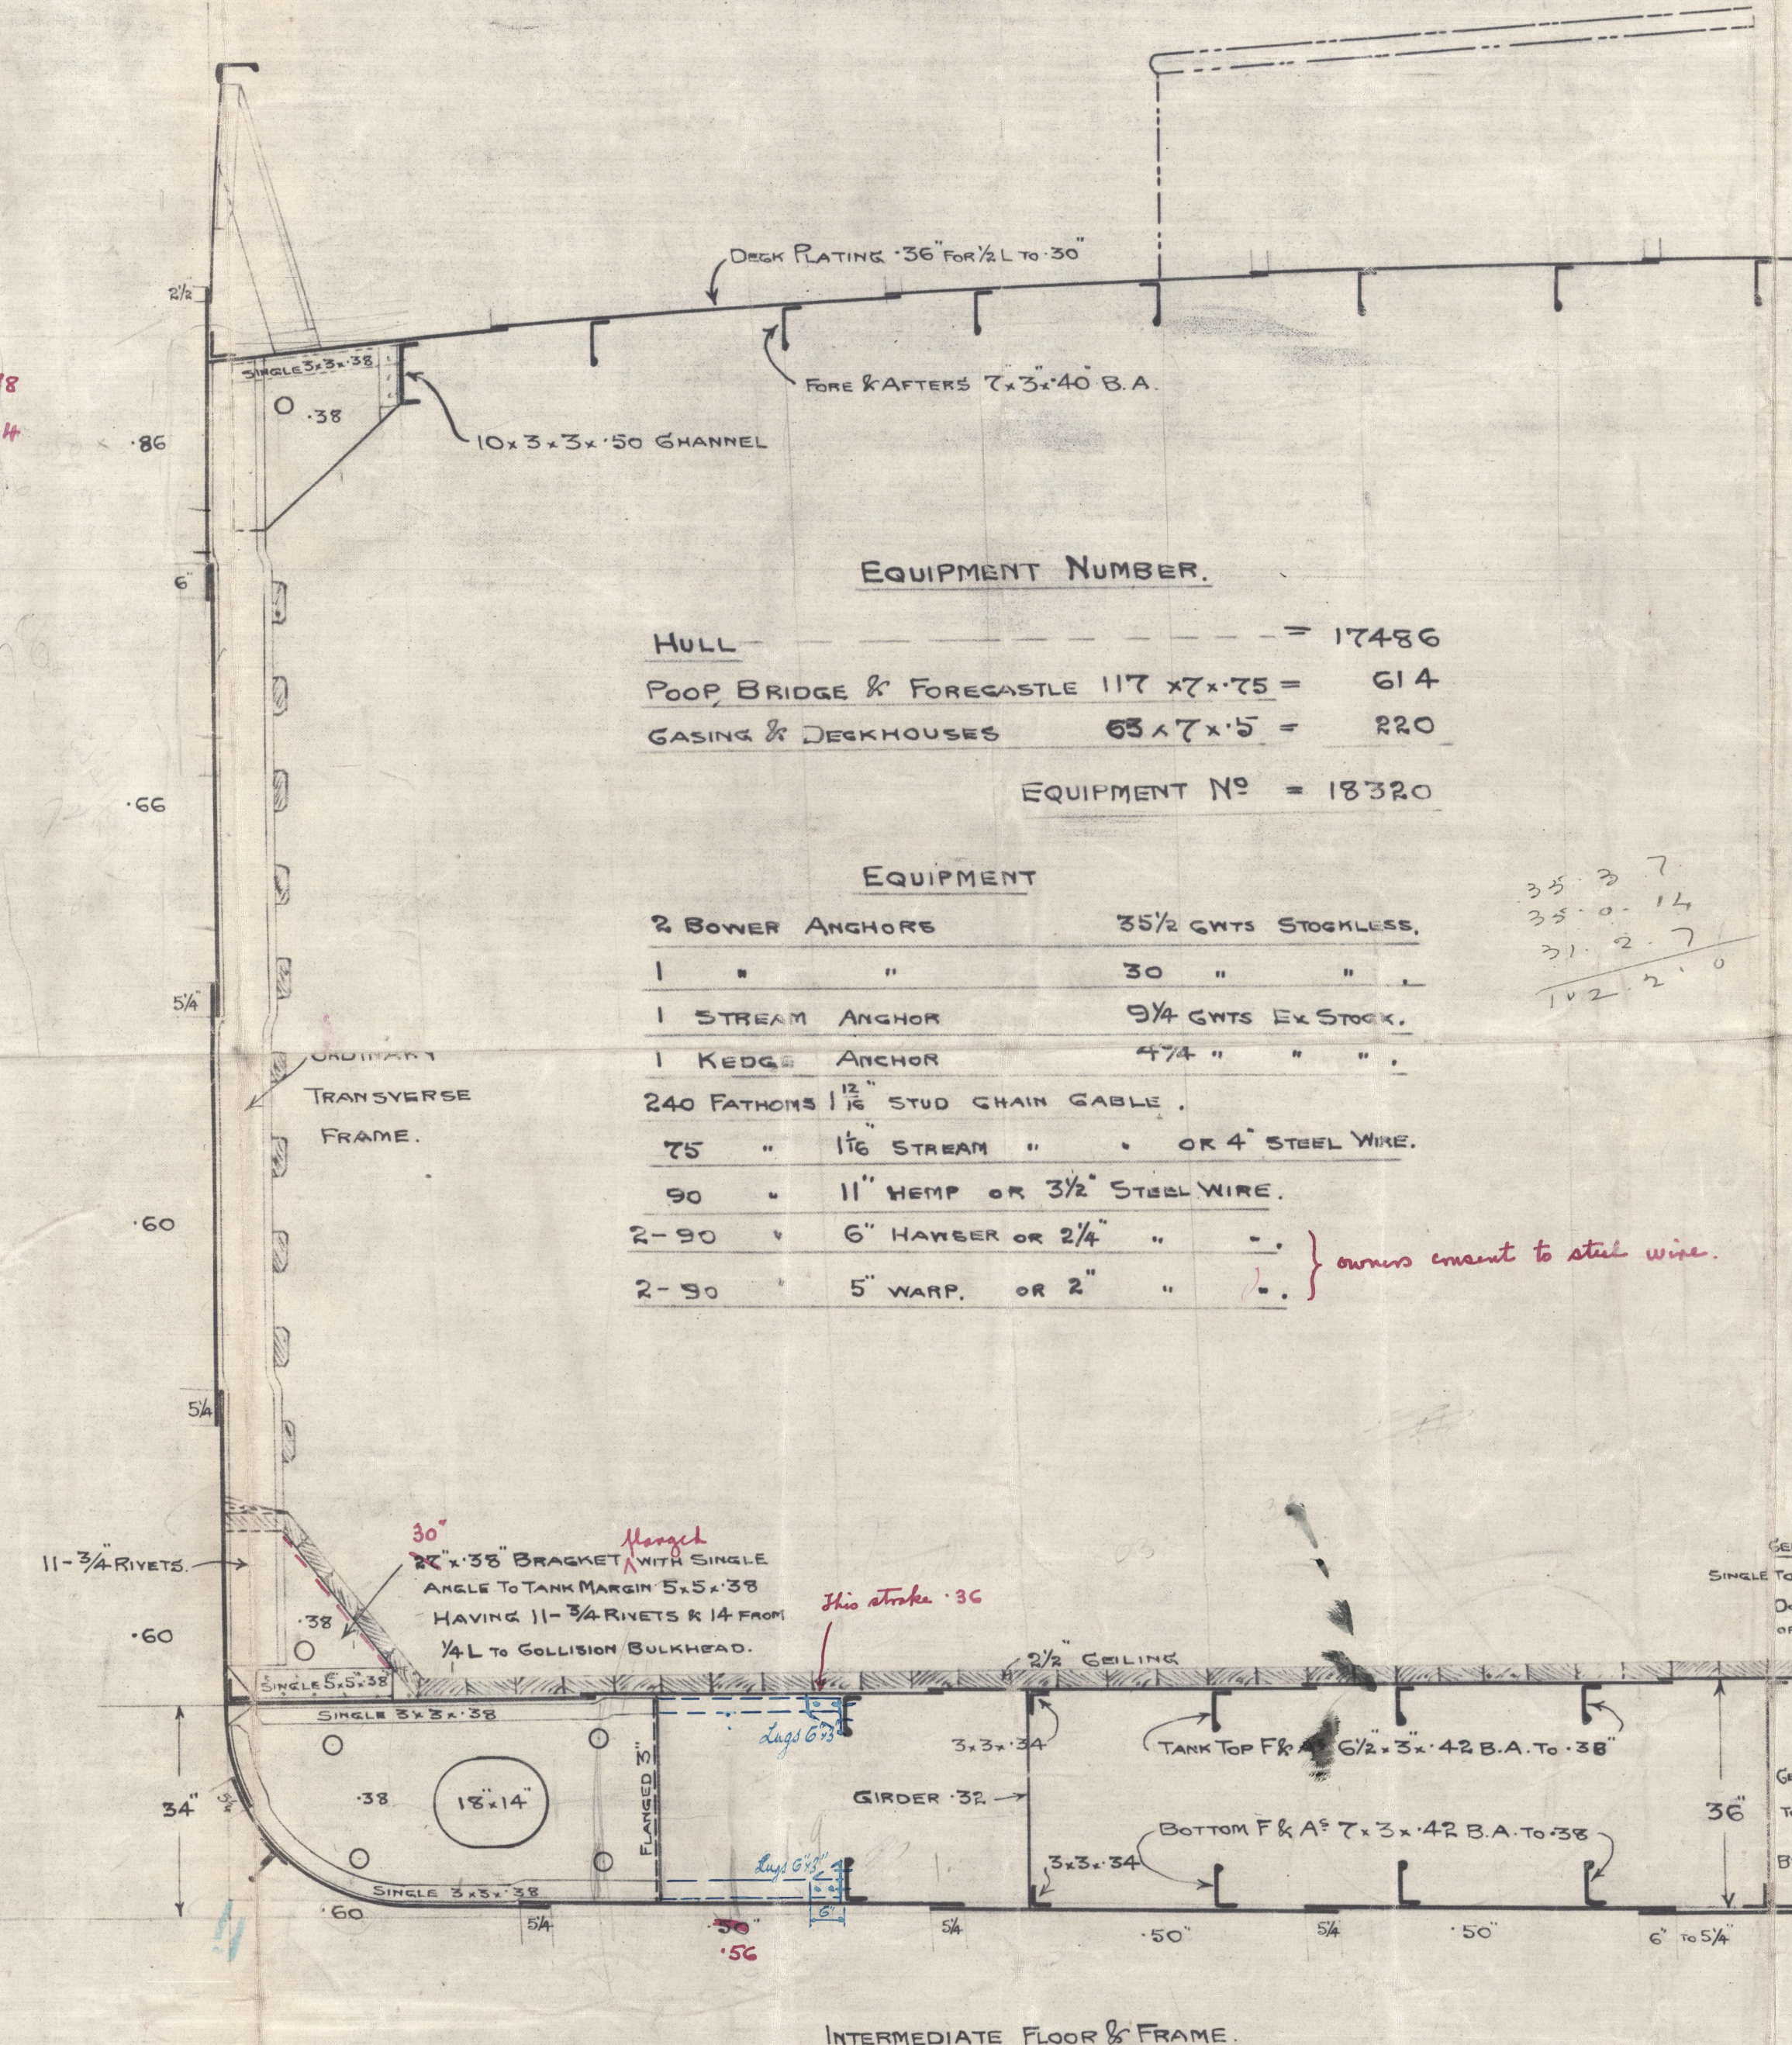

INTERMEDIATE FLOOR & FRAME.

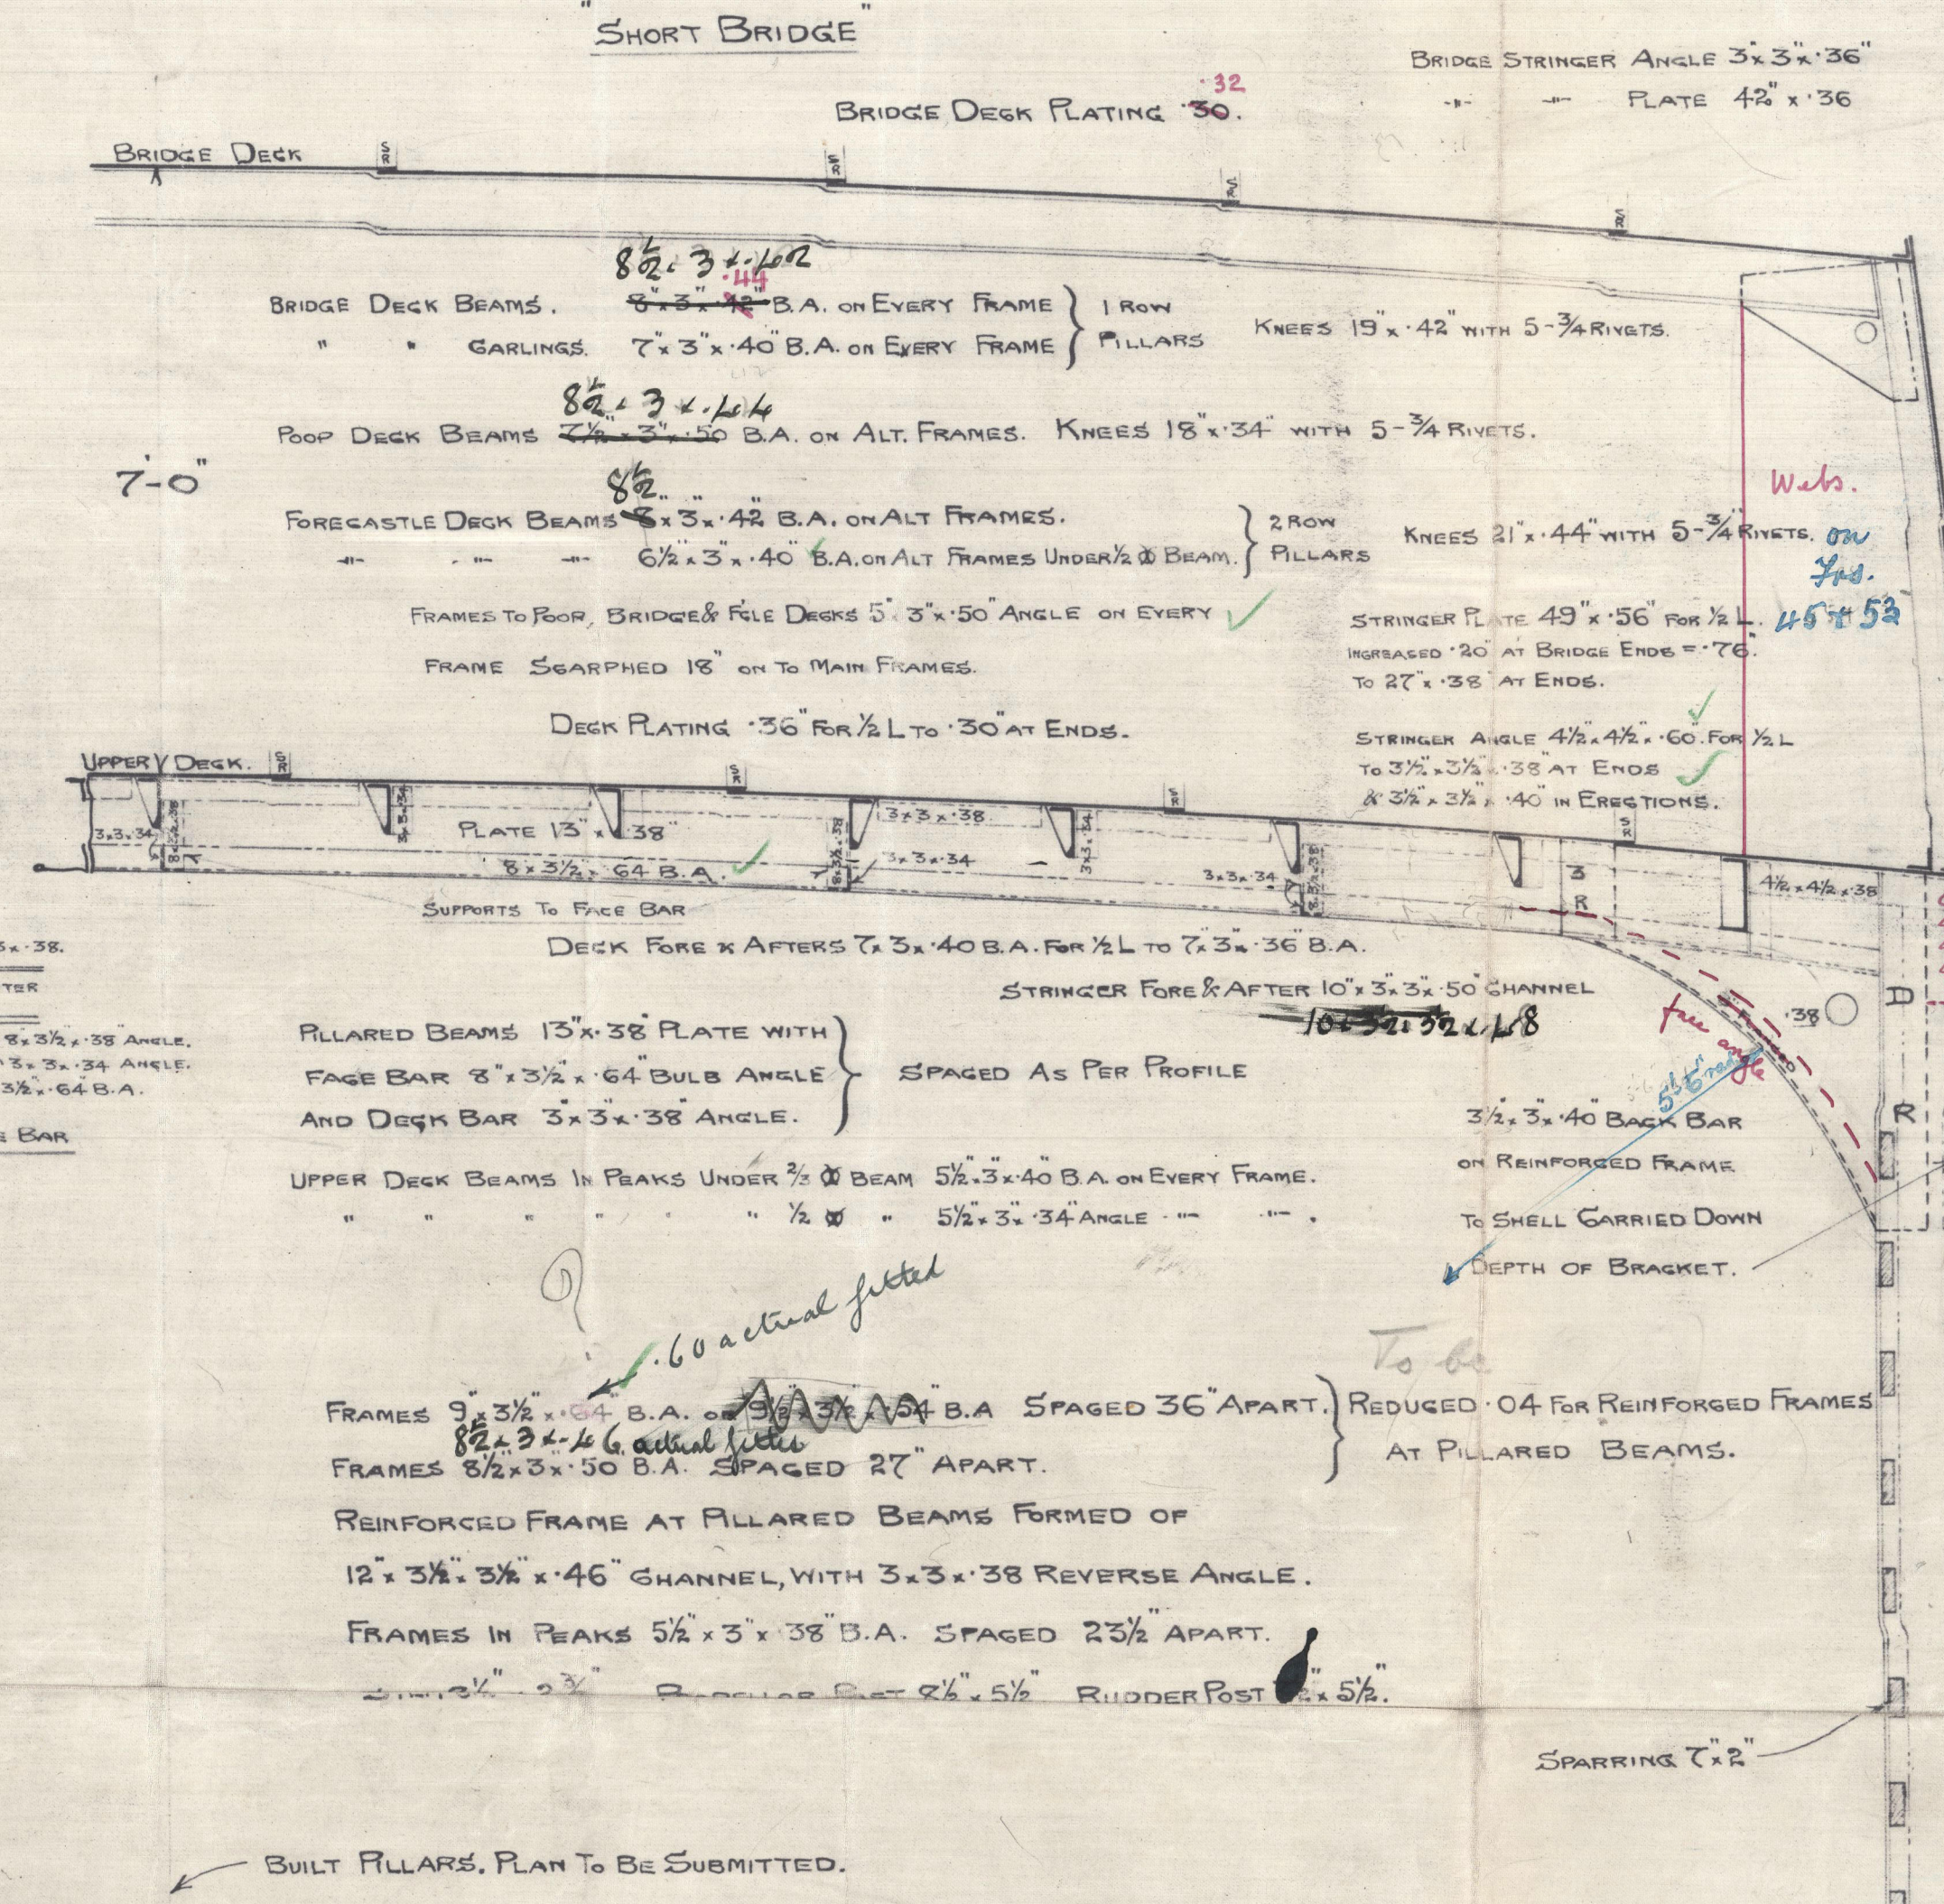


POOP FLE
STRINGER PLATE 27' x 32' 27' x 32'
" ANGLE 3 1/2" x 3 1/2" 3 1/2" x 3 1/2"
DECK PLATING 36' x 36' 36' x 36'
SIDE PLATING 32' x 32' 32' x 32'
This plates ✓ 5 x 3 PP
Hood Pl ✓
K. BRIDGE SIDE PLATING 36' x 42'

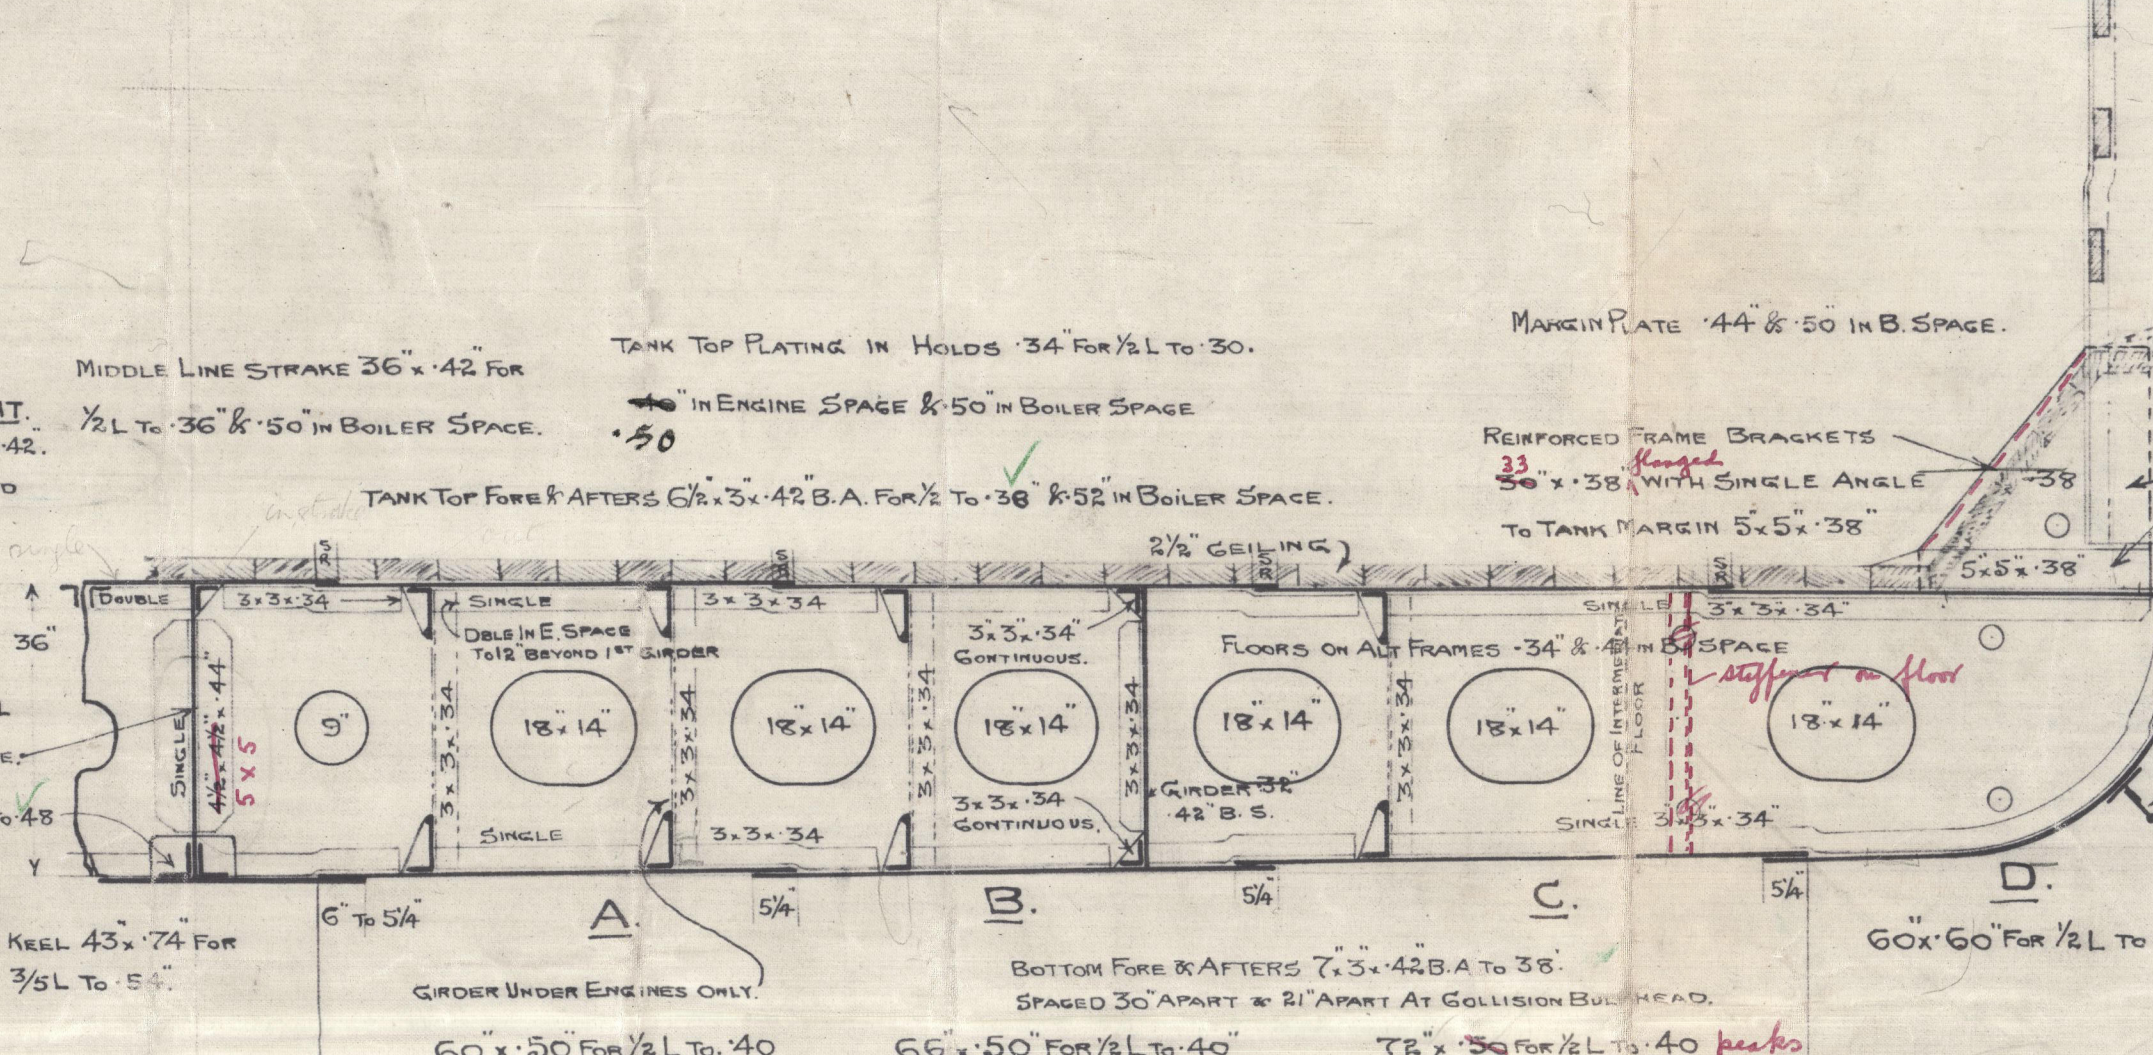

SOLID FLOOR IN WAY OF BOILER SPACE.

ALL ANGLES EXCEPT SHELL ANGLES IN BOILER SPACE INCREASED AS PER RULES.

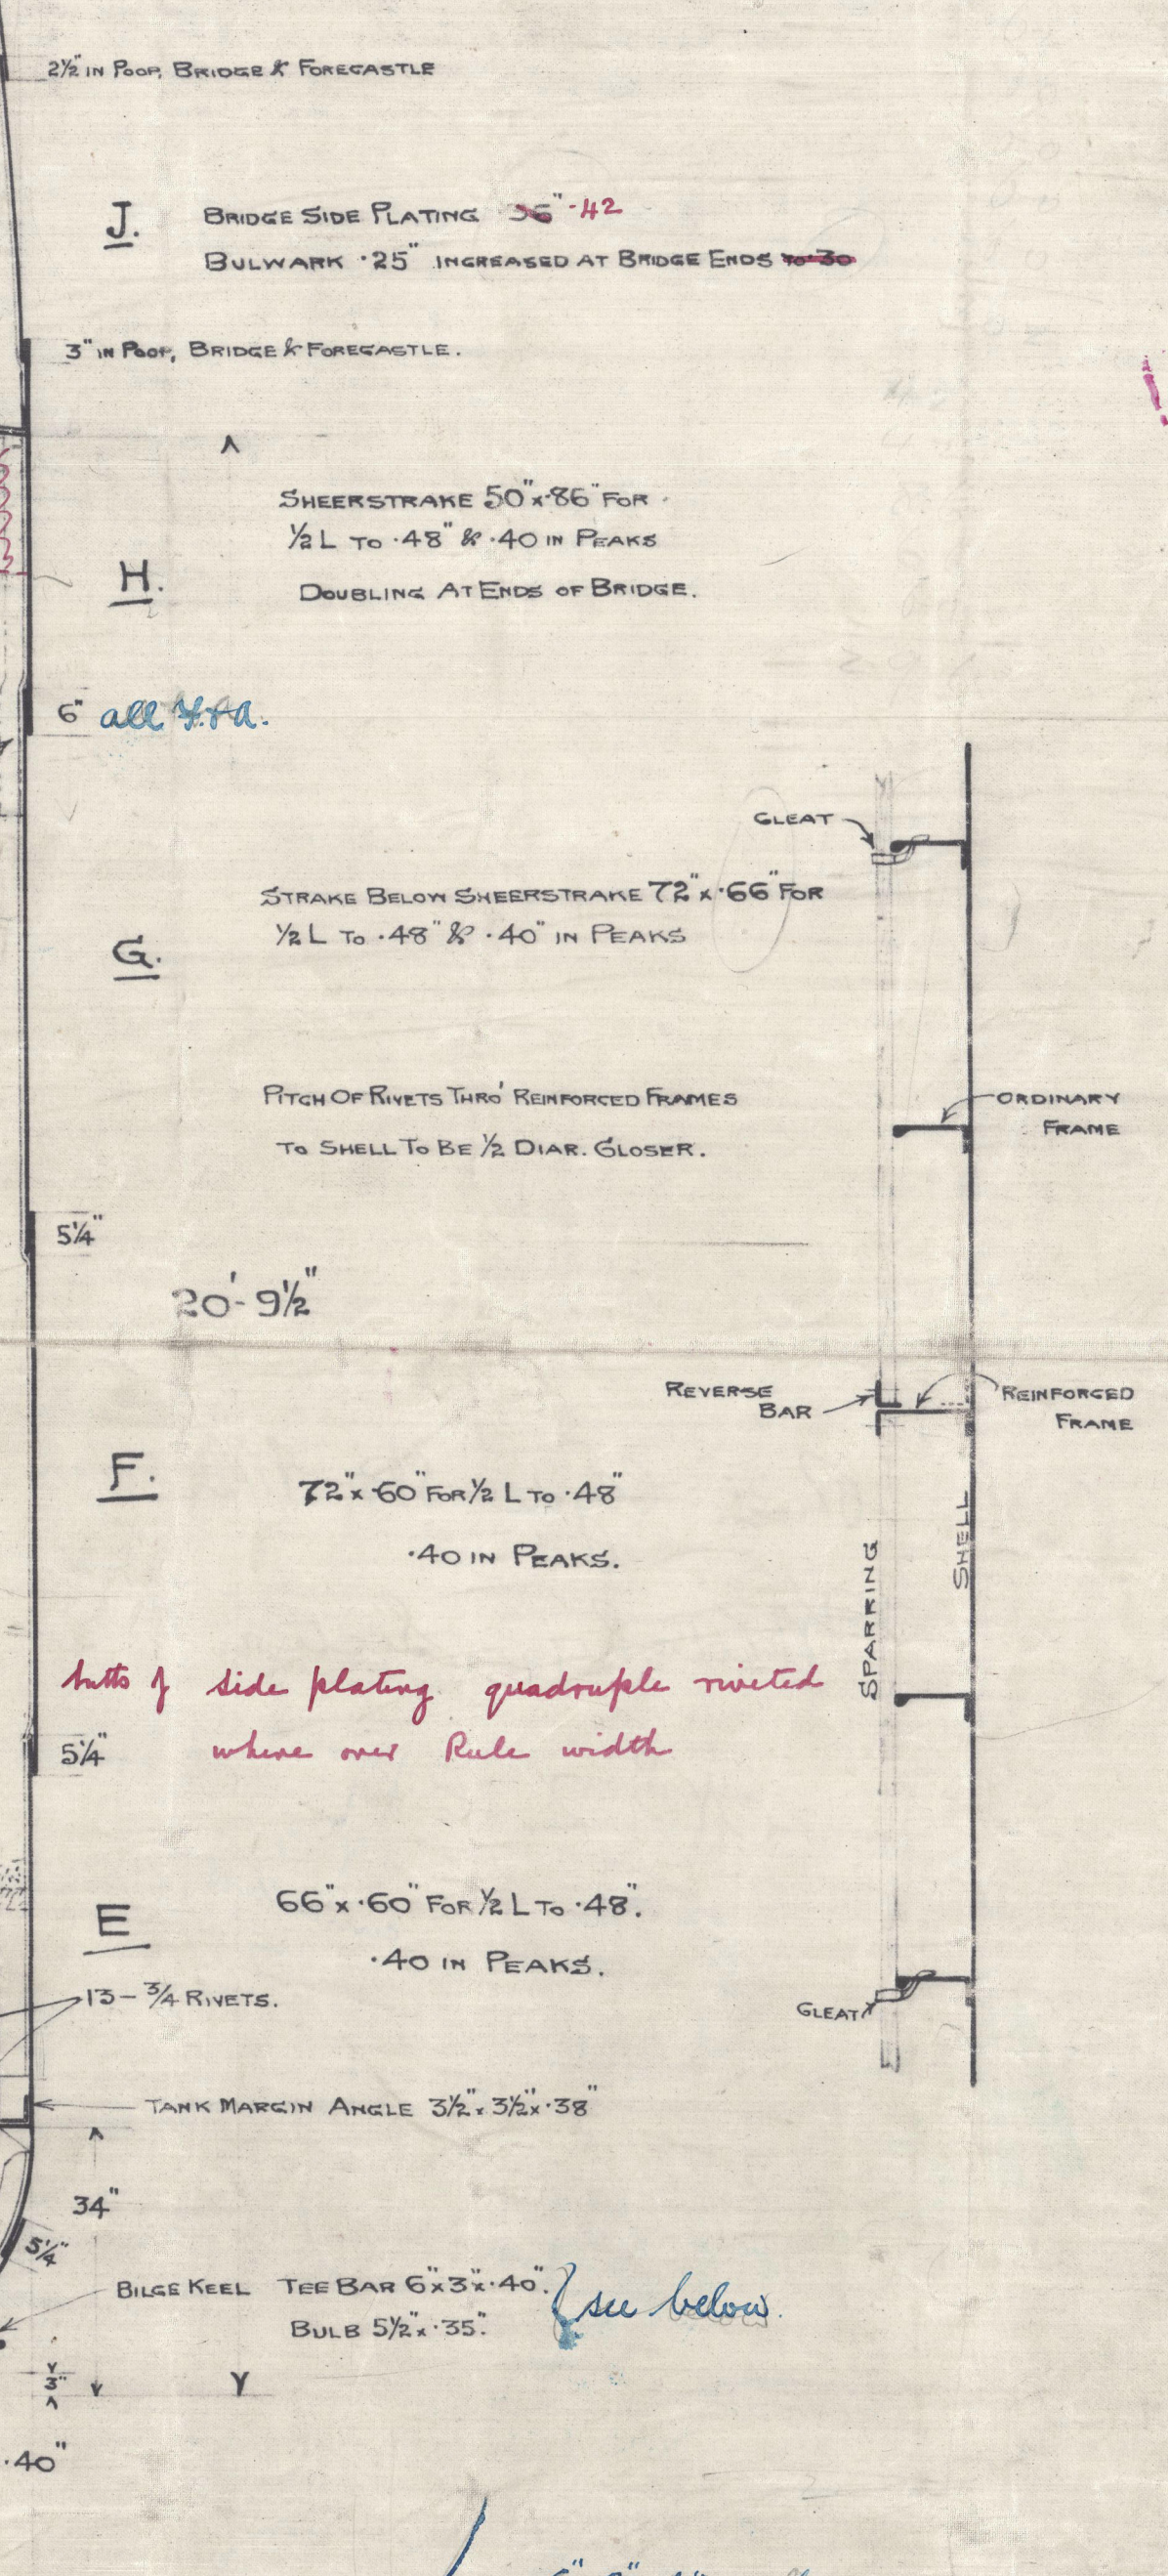

Note of side plating quadruple riveted where over Rule width




6'3" x 4'0" angle
6" Plate
3 x 3/4 solid deep sound.

C.F.
28.6.16

Oliver Glyde SB Wh
Midships Section

No 2

Nº 2. & 5
Nº 5
cancelled

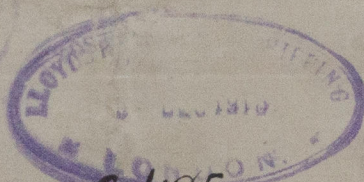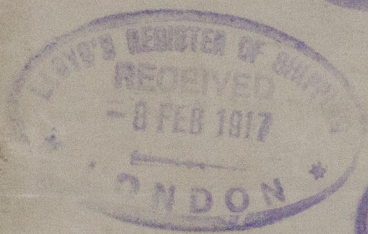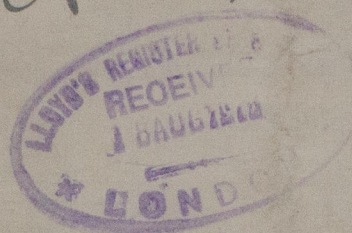

GLASGOW REPORT NO 37185
vs Bartholomew

