


24.4.03
11.6.03

Scale 1/2" = 1 Foot

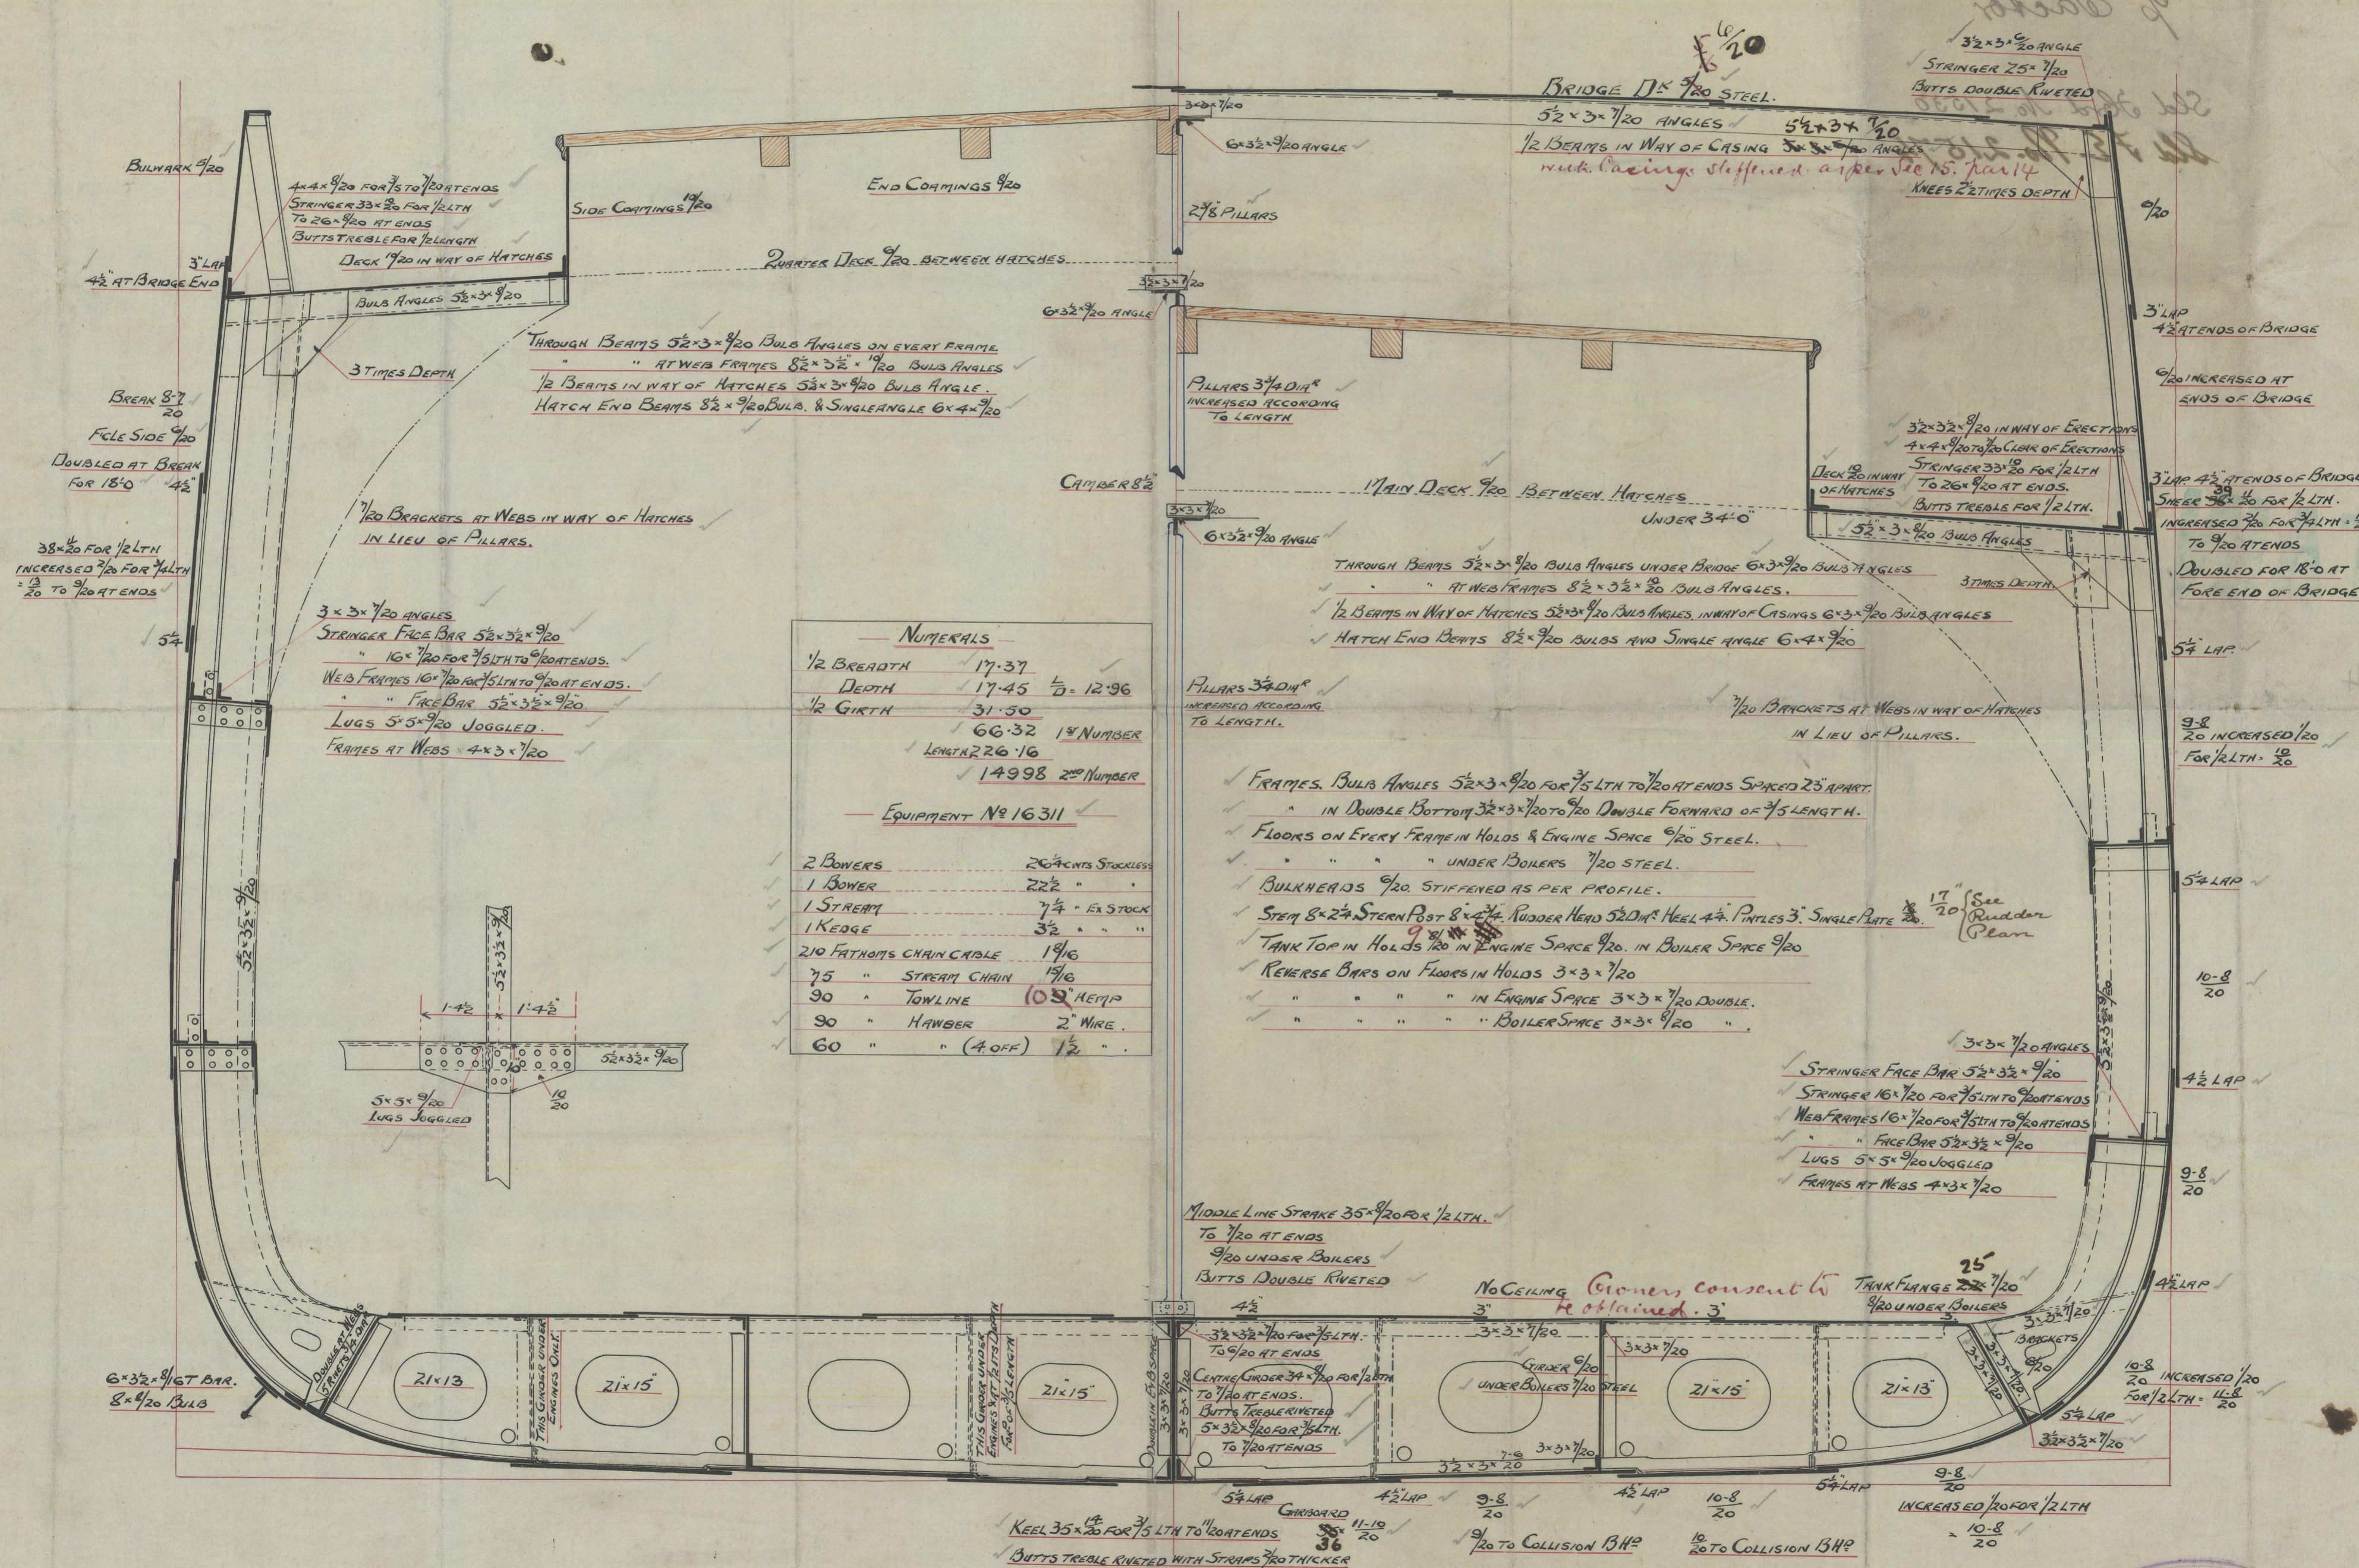

ALL PARTS OF DOUBLE BOTTOM INCREASED $\frac{1}{2}$ IN BOILER SPACE

S. P. AUSTIN & SON, LTD.
18/4/03
STEEL & IRON SHIPBUILDERS
AND
REPAIRERS
551
SUNDERLAND

JSS
22-4-03

C.B.
24.4.83

SC Austin & Son

No 224

SS Factor

Mud ship

Section


Sec Letter

44-03

% Factor

Sld Hrd No. 21530

Sld F E No. 21574

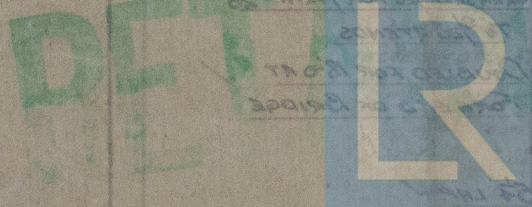

W898-0054

© 2020
Lloyd's Register
Foundation