



1-5-11
10-5-11
11-5-11
12-6-11
10-7-11
21-5-11
8-9-11
553) 11-4-12

FREEBOARD PARTICULARS	
LENGTH ON LOAD LINE	428'-6"
MOULDED DEPTH TO UPPER D ^e	32'-1 1/2"
UNDER DECK TONNAGE	2419 TONS
LENGTH OF ERRECTIONS	
FORE	19'-9"
BRIDGE	148'-4"
AFT	82'-3"
MEAN SHEER OVER TOTAL LENGTH	81'
SHEER FORWARD	11'-2"
D ^e AFT	50'
D ^e 1/8 LENGTH FROM STEM	6 1/2'
D ^e D ^e D ^e D ^e STERN	2 7/8'
MEAN SHEER AT 1/8 LENGTH	4 1/2'

PROFILE N^{os} 345 & 6 S.S. 1353
TO CLASS 100 A1 AT LLOYD'S TWO DECK
SCALE 1/8 INCH = ONE FOOT.

 

Actual Sketches of Deck Plans to be submitted.

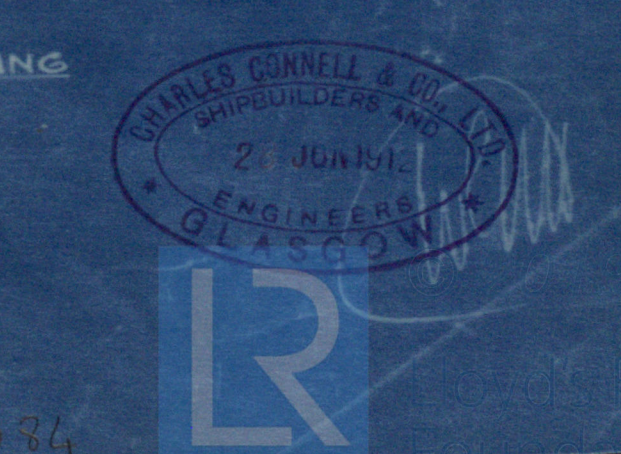


C. Coumell & Co.
Profile
N^o 346


S/S "INDRAKUALA"

now "Botavon"

GLASGOW REPORT No: 31657.

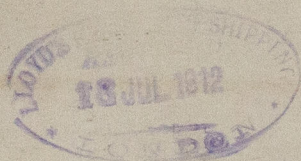

w9-0084

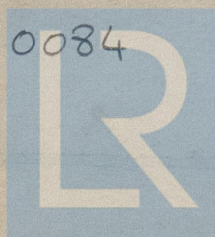

© 2019

Lloyd's Register
Foundation