

2.2.12
12.2.12
22.7.12


PRINCIPAL DIMENSIONS:- LENGTH B.P. 305' BREADTH M^{LD} 42'0" DEPTH M^{LD} 21'6"

PROPOSED LONGITUDINAL ELEVATION

OF STEEL SCREW STEAMER TO CLASS 100.A.1. AT LLOYD'S.

SCALE 1/8" = 1 FOOT

WOOD, SKINNER & CO. LD.
SHIPBUILDERS
NEWCASTLE ON TYNE.

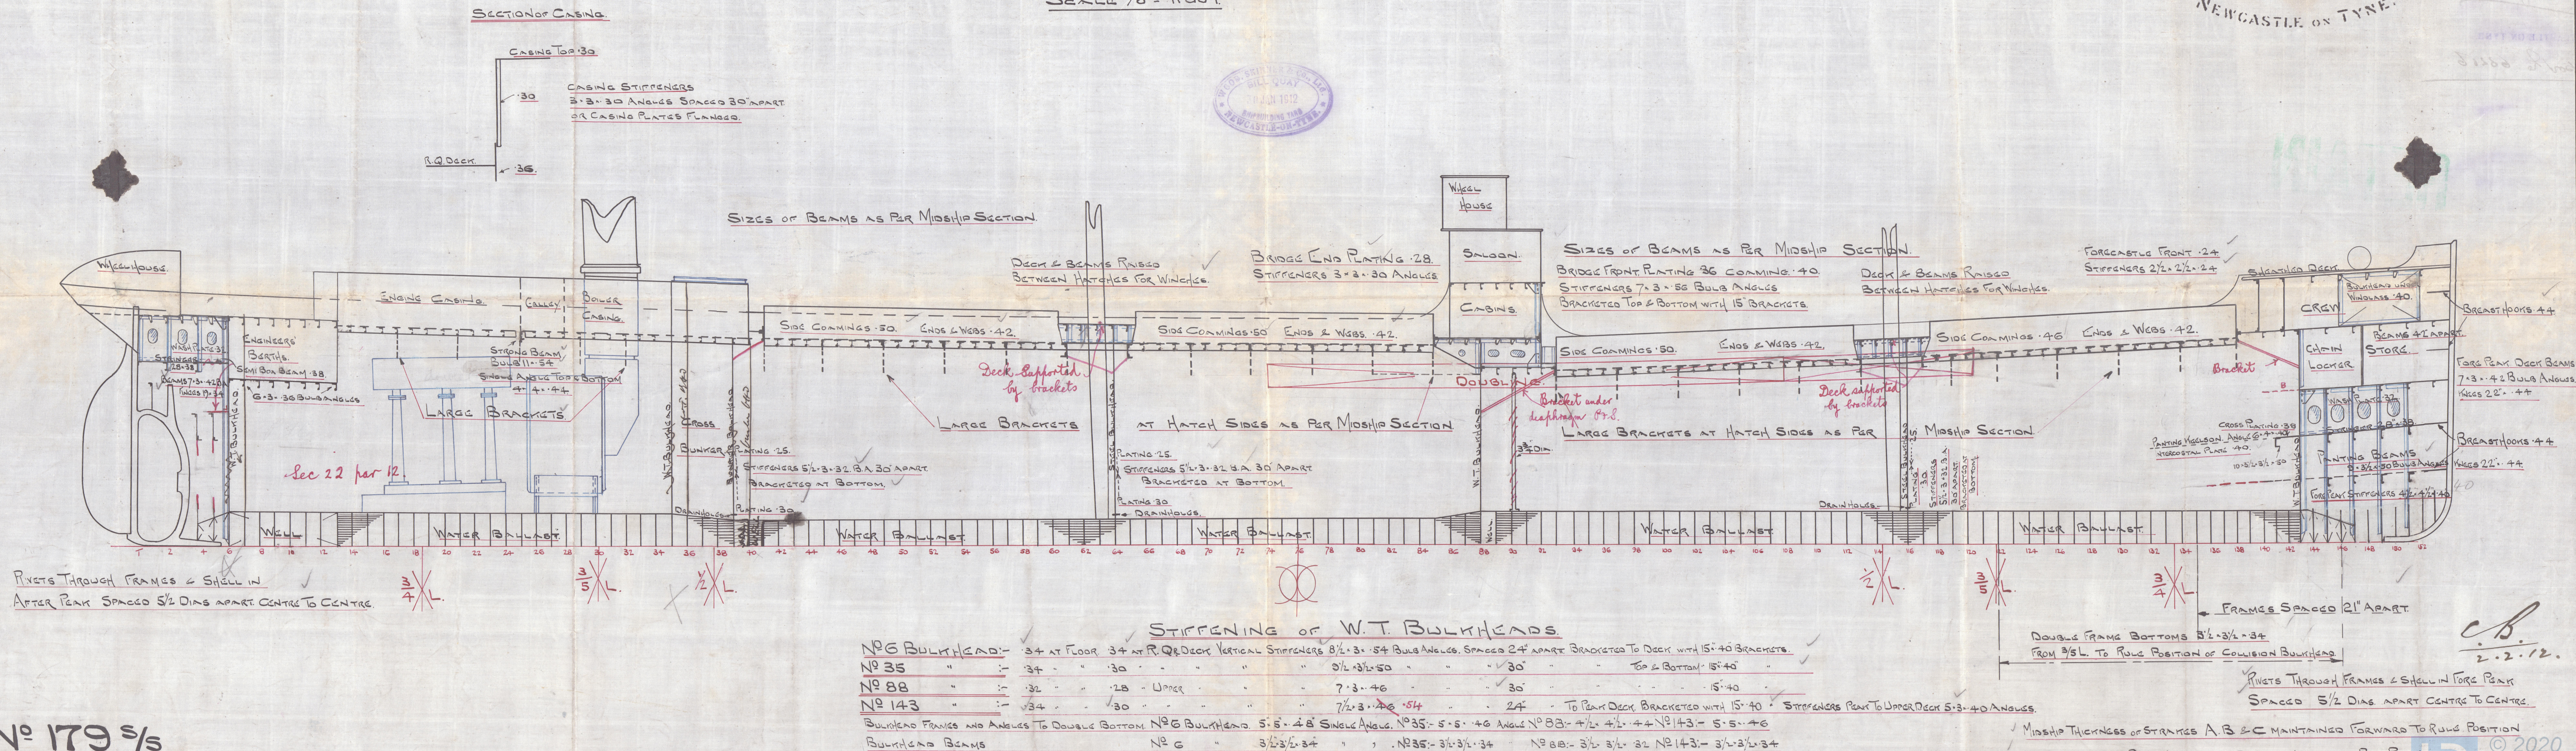

Nº 179 s/s

STIFFENING OF W.T. BULKHEADS.									
Nº 6 BULKHEAD:-	34	at Floor	34	at R.Q. Deck	Vertical Stiffeners	8 1/2 x 3 x 54	Bulb Angles	Spaced 24" apart	Bracketed to Deck with 15" x 40 Brackets.
Nº 35	"	:-	34	"	30	"	"	5 1/2 x 3 1/2 x 50	"
Nº 88	"	:-	32	"	Upper	28	"	7 x 3 x 46	30
Nº 143	"	:-	34	"	30	"	"	7 1/2 x 3 x 54	24
BULKHEAD FRAMES AND ANGLES TO DOUBLE BOTTOM. Nº 6 BULKHEAD. 5' 5" x 4' 8" Single Angle. Nº 35:- 5' 5" x 4' 6" Angle Nº 88:- 4' 1/2" x 4' 1/2" x 44" Nº 143:- 5' 5" x 4' 6" Angle									
BULKHEAD BEAMS	Nº 6	"	3 1/2 x 3 1/2 x 34	"	"	Nº 35:-	3 1/2 x 3 1/2 x 34	Nº 88:-	3 1/2 x 3 1/2 x 32
						Nº 143:-	3 1/2 x 3 1/2 x 34		

Wood Skinner 179

Prople.

L. L. Fulger

NEWCASTLE ON TYNE

Report to 68266.

RETAIN



© 2020

Lloyd's Register
Foundation