



SINGLE DECK CARGO STEAMER

DIMENSIONS.

DEPTH INCLUDING CROPTO UPPER DECK 18'-10"

1:100


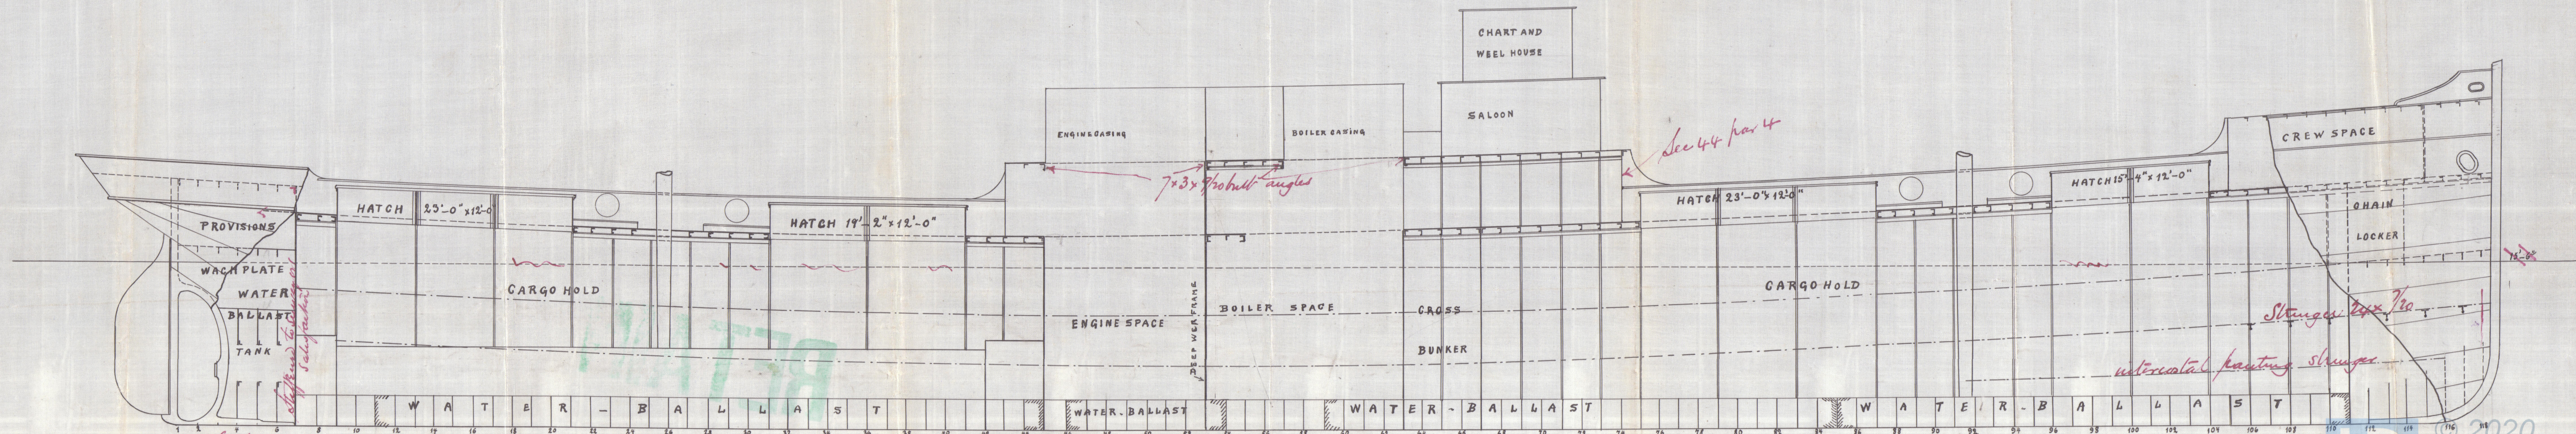


Rivets thru frames
splitting in tank.
6 dia's apart

Bottom forward strengthened
as per rule.

Östergötland
Ham. Rep N: 7867
Longitudinal. Plan
Hemaldhuseke's
N: 4404
Ham lung letter
9/5/03

See 44 page 4

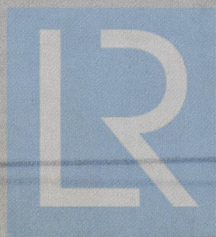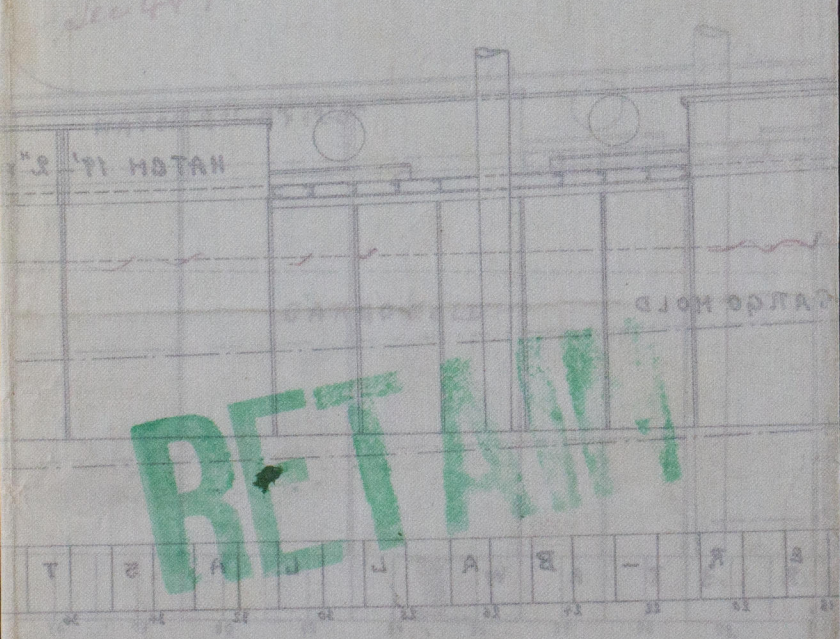

© 2020

Lloyd's Register
Foundation