

No 66 & 67 PROFILE & DECK PLAN.


ARCH PRINCIPLE OF CONSTRUCTION (PATENT)

PROPRIETORS, MESSRS. SWAN, HUNTER & WIGHAM RICHARDSON LTD. & MAXWELL BALLARD.

MOULDED DIMNS 287'-0" x 40'-6" x 19'-1" WITH 6'-0" ARCH

TO CLASS 100AL LLOYDS

SCALE 1/8" = 1 FOOT

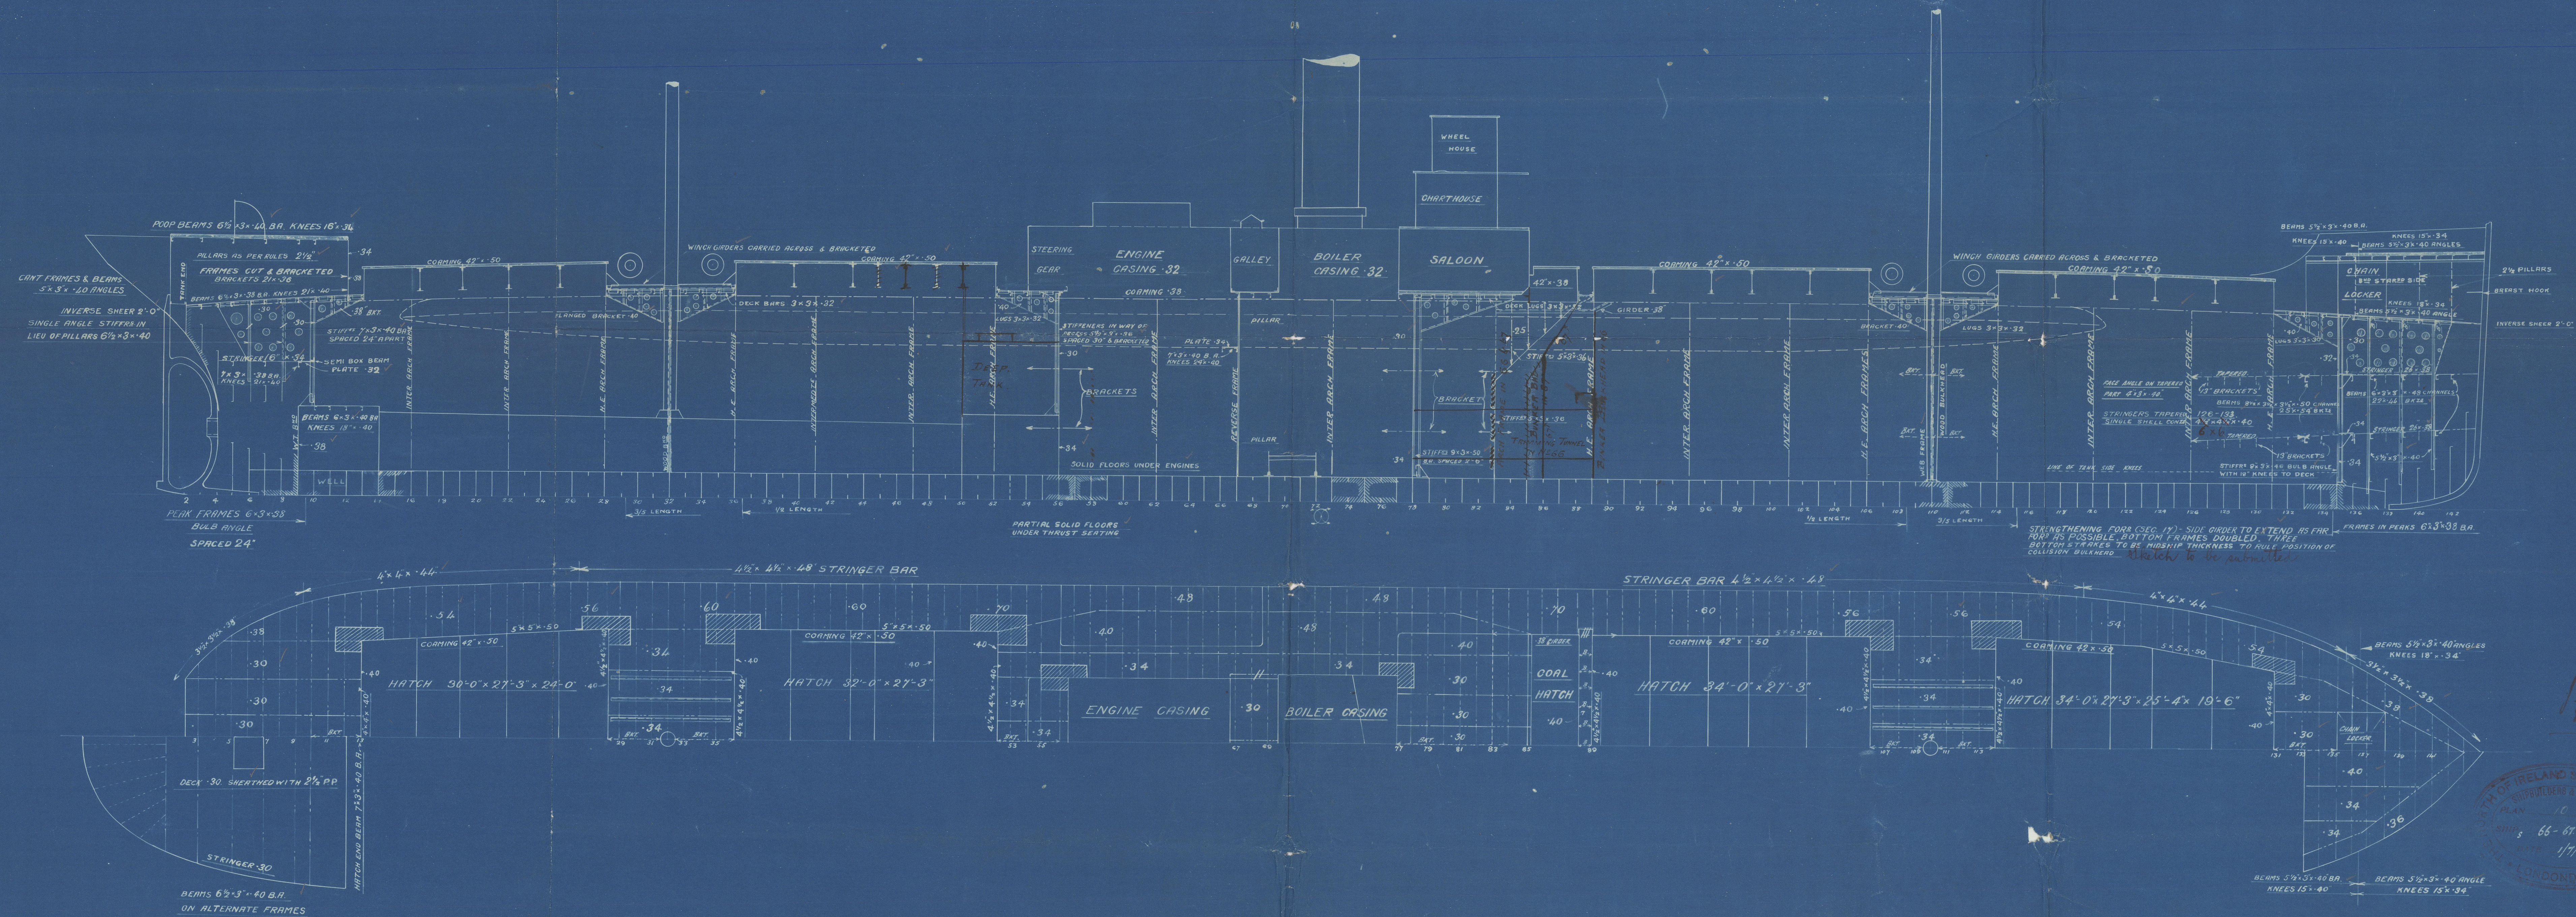

1/11
 8.7.15




The North of Ireland Sd Co.
nos 66 & 67

Profile & books

§s. "Estimere" - Rel 7678

§s. Saint Paul - - - 7769

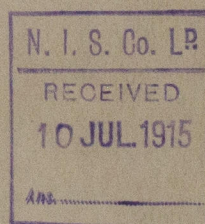

RETAIN



© 2020

Lloyd's Register
Foundation

W904-0016