


Profile To Class 100 A.I. of Lloyds Length B.P. 268'0". Breadth Mld 37'8". Depth Mld 19'5"

— Scale 1/8" = 1 Foot —

S.S. "ETALMANOR"

Nº 158.

Nº 158-9-160.

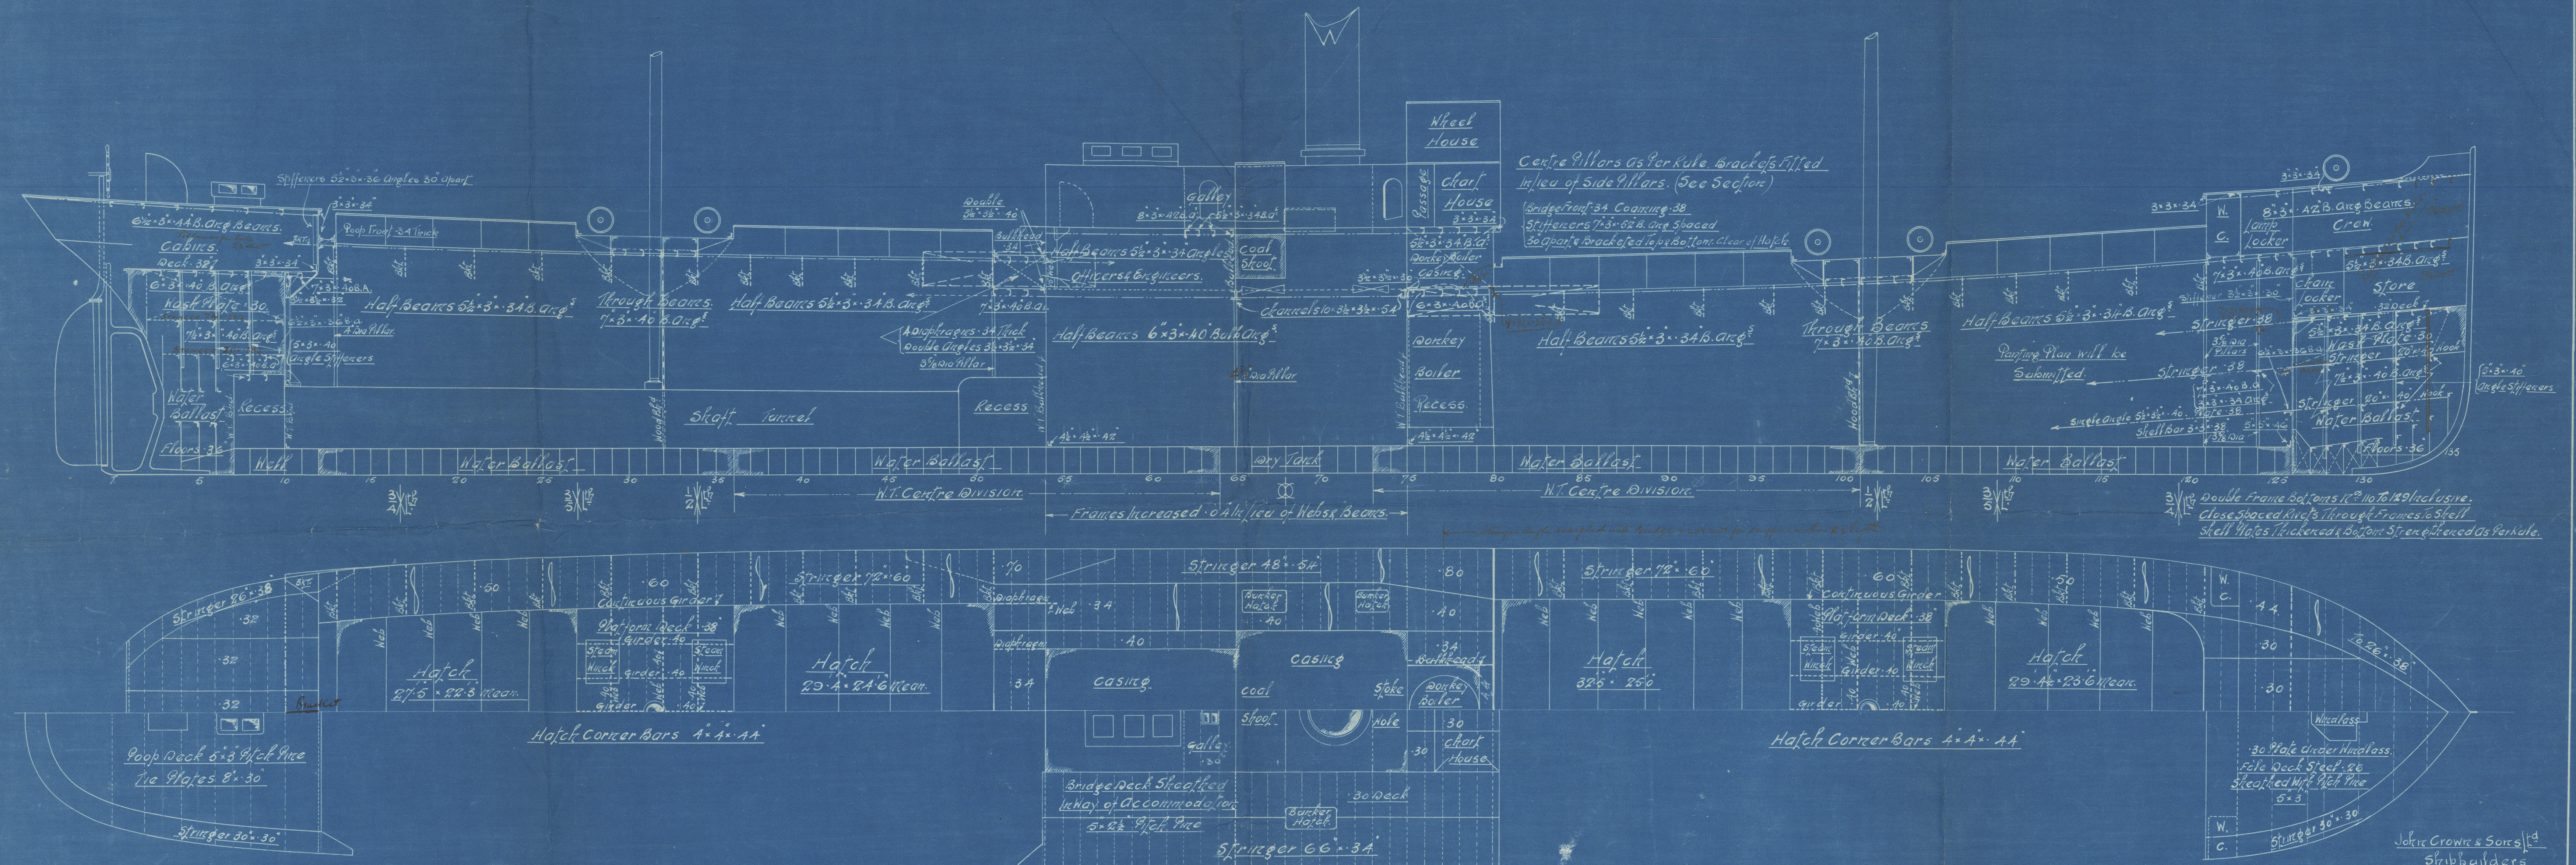

John Crowe & Sons Ltd
Shipbuilders
Sunderland
11th 1915.

Profile
S S Etal Manor
(as buies)
J Croout Sons
No 158

BUNDERLAND RPT. NO. 26754

RETAIN
© 2020



Lloyd's Register
Foundation

W904-0204