

BREADTH MOULDED	52.79	
DEPTH	27.50	
	80.25	TRANS No
	385	
d = 24.0	309.11	LONG ¹ No
DEPTHS IN LENGTH UPPER DECK.	14.00	
" " " BRIDGE DECK	10.84	

DIMENSIONS 385-0" x 53-0" x 27-6" MOULDED.

TO CLASS 100.A.1. AT LLOYDS

SCALE $\frac{1}{2}$ " = ONE FOOT

	<u>EQUIPMENT</u>	<u>CHTS</u>	<u>QTS</u>	<u>LOS</u>
2 STOCKLESS BOWERS		60	-	0 - 0
1		30	-	0 - 0 ✓
1 STREAM ANCHOR (EX STOCK)		16	-	1 - 0
1 KEDGE		7	-	0 - 0
370 FATHOMS OF 3/4" STUD CHAIN CABLE 2 3/4" ✓				
90	4 3/4" STEEL WIRE ✓			
120	4 3/4" ✓			
IMO 90	8 HANSER OR 2 3/4" STEEL WIRE			
90	7 WARP 2 1/2			

*burners Cores
Steel wire*

BRIDGE DECK 38 STEEL ✓
BRIDGE DECK 42' FOR $\frac{1}{2}$ LENGTH TO ~~ST~~ AT ENDS IRON WHERE EXPOSED
BUTTS DOUBLE RIVETED FOR $\frac{1}{2}$ LENGTH SINGLE AT ENDS. ✓


BEAMS 7" x 3" x 42 B.A. ONE EVERY FRAME. 2 ROWS OF PILLARS DIA. KNEES 2" x 42. FIVE 3/4" RIVETS.
STRINGER 34" x 34" ANGLE 3/8" x 3/8" x 34" SIDE PLATING 40" DECK PLATING 26" SHEATHED WITH 5 x 2 1/2" PITCH PINE (STEEL)

BEAMS 7" x 40 B.A. ON EVERY FRAME 1 ROW OF PILLARS DIA. KNEES 18" x 40 FIVE 3/4" RIVETS.
STRINGER 34" x 34" ANGLE 3 1/2" x 5/8" x 34" SIDE PLATING 3/8" DECK PLATING 30" (IRON)

	EQUIPMENT NUMBER			
POOP	25	x	75	x 75 ✓ = 157
BRIDGE	227.57	x	80	x 75 ✓ = 1364
FORECASTLE	55	x	75	x 75 ✓ = 197
DECKHOUSE	255	x	775	x 5 ✓ = 99
CASING	595	x	70	x 5 ✓ = 208

$$\begin{array}{r} \cancel{2025} \\ 30911 \\ \hline 32930 = y \end{array}$$

STEM. $10 \times 2\frac{3}{4}$ ✓
STERN FRAME. $10 \text{ AND } 9 \times 7\frac{1}{2}$ ✓

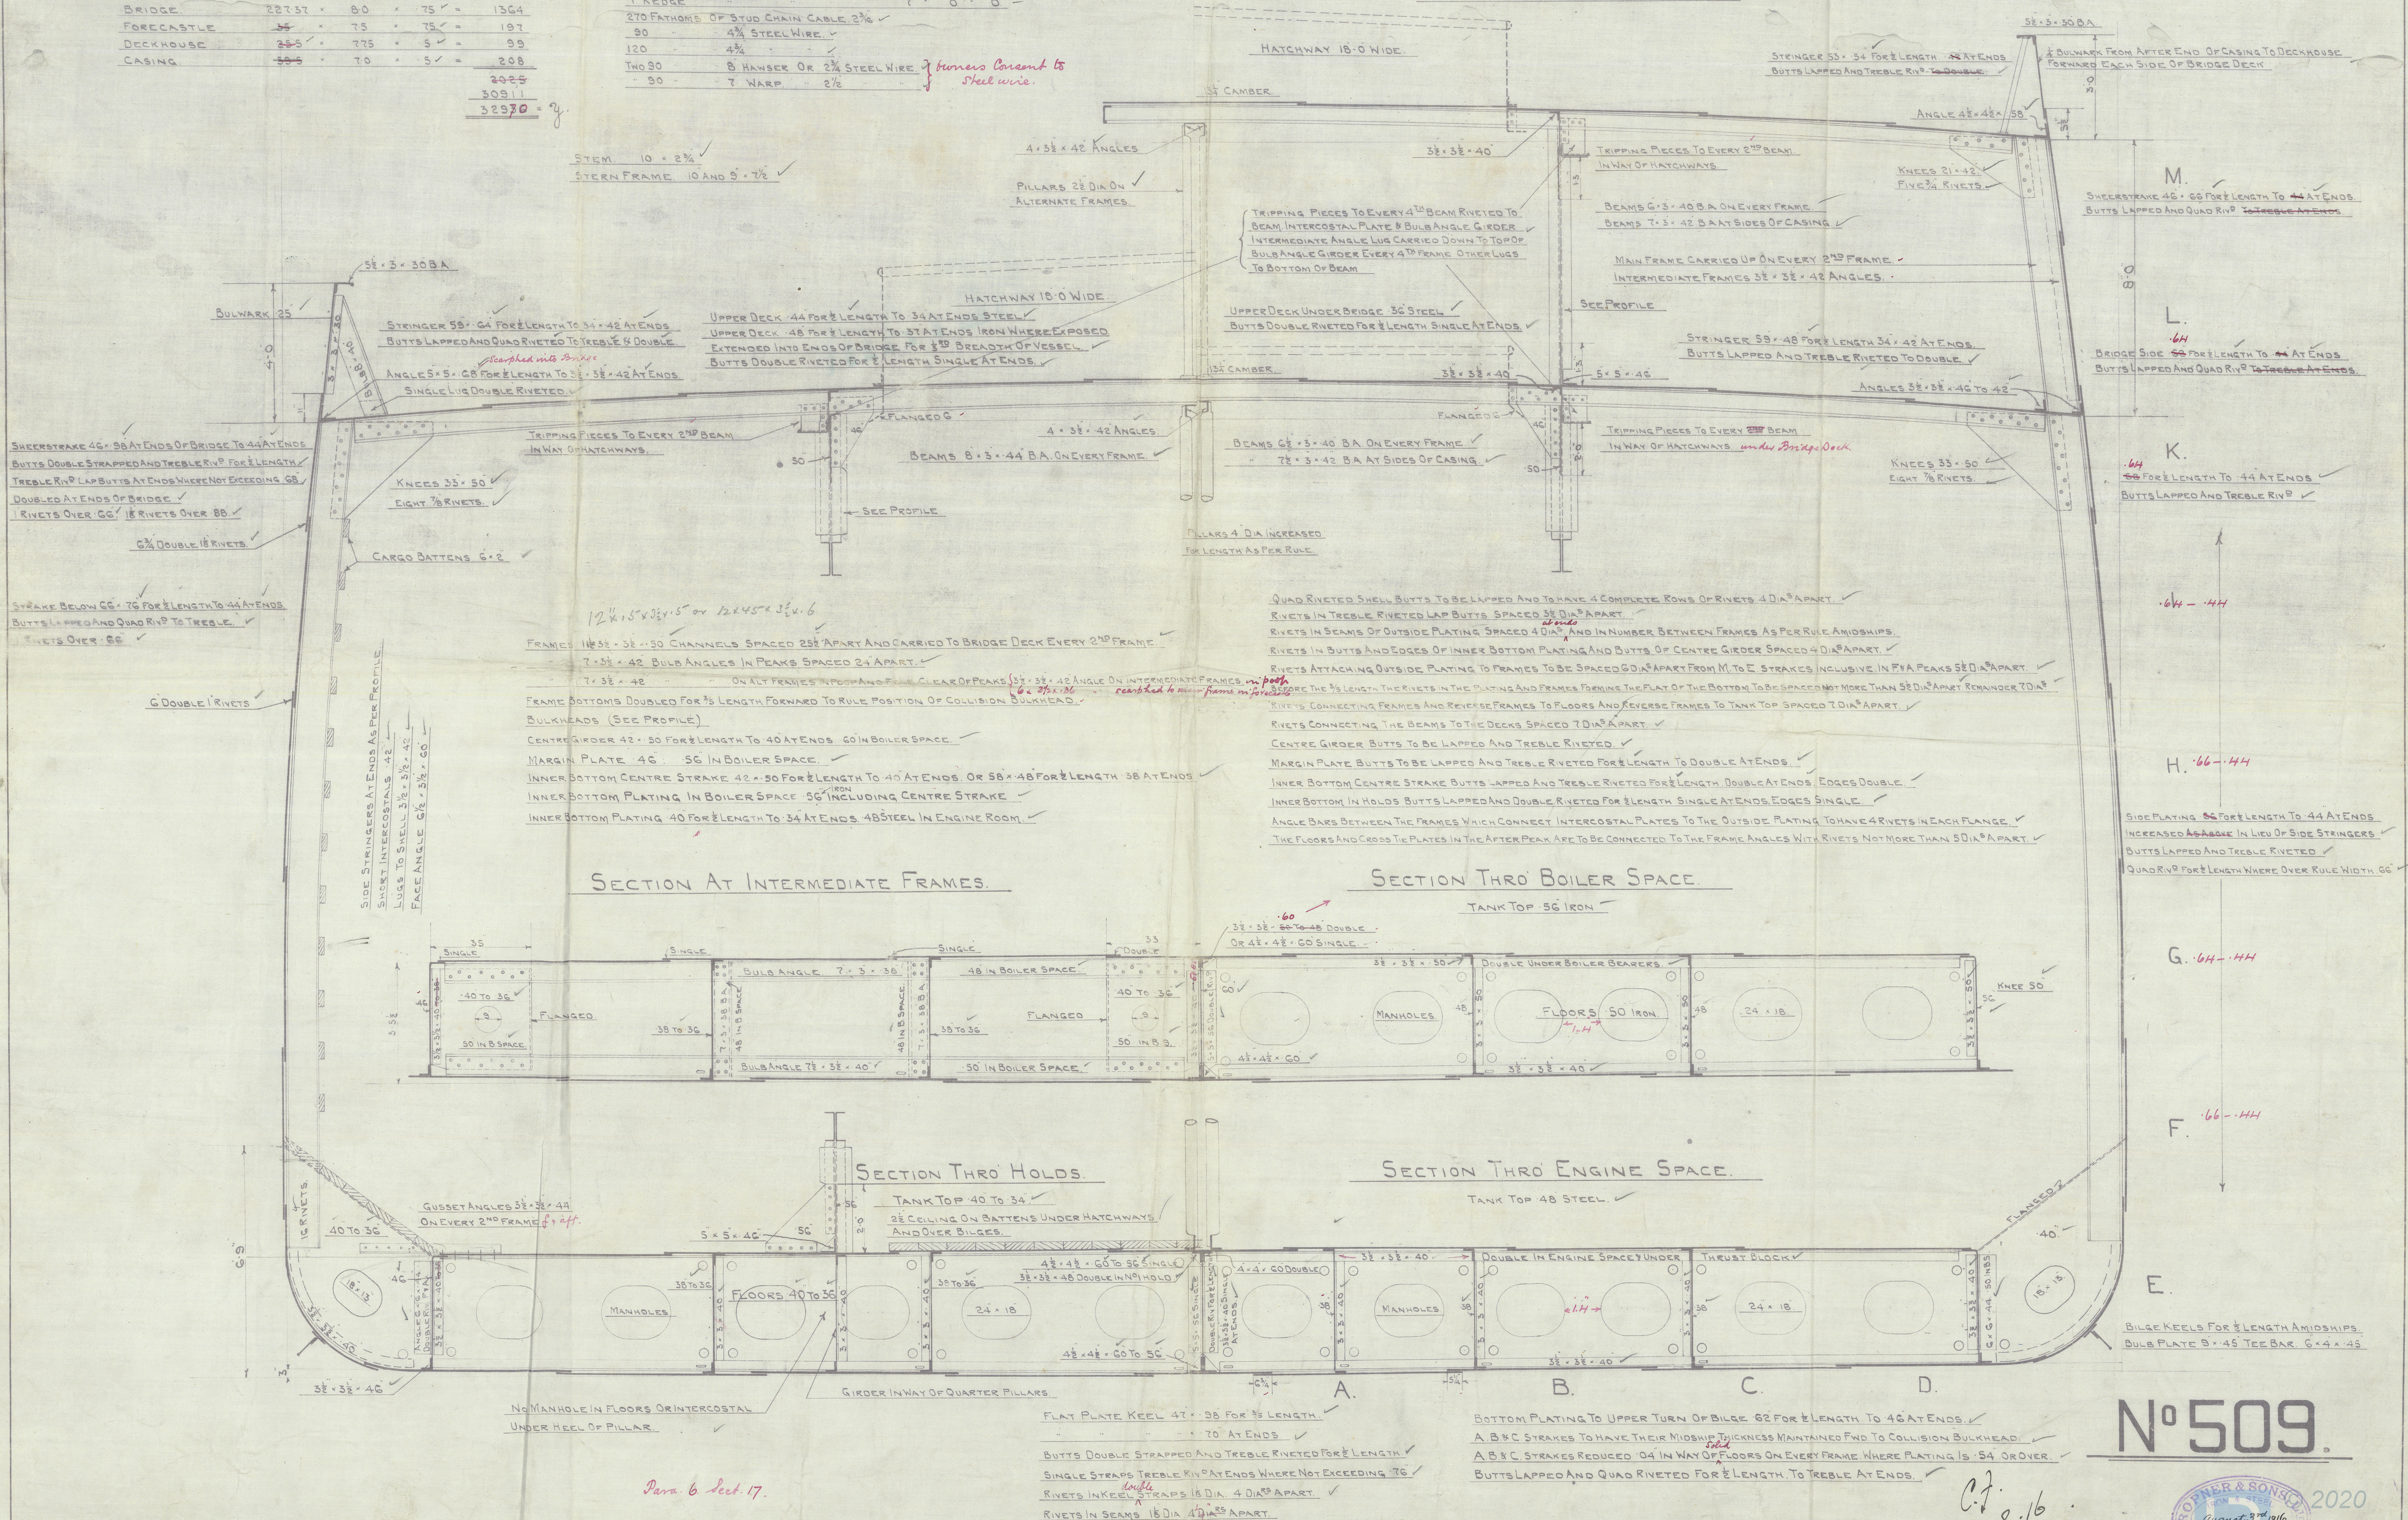

Para. 6. Sect. 17

Nº 509

Mid: Lie:

20 SEP. 1916



LLOYDS REGISTER OF SHIPPING
RECEIVED
SECTION
LONDON



RECEIVED
-8 JAN 1917
LONDON

A circular purple ink stamp. The outer ring contains the text "LLOYD'S REGISTER OF SHIPPING" at the top and "LONDON" at the bottom, separated by two small stars. The center of the stamp contains the date "15 AUG 1917".



Lloyd's Register
Foundation

W905-0065