



6/12/07

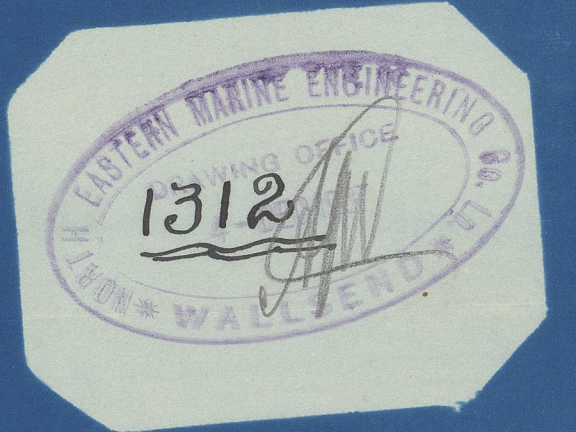

J. H. J.
4/12/07.

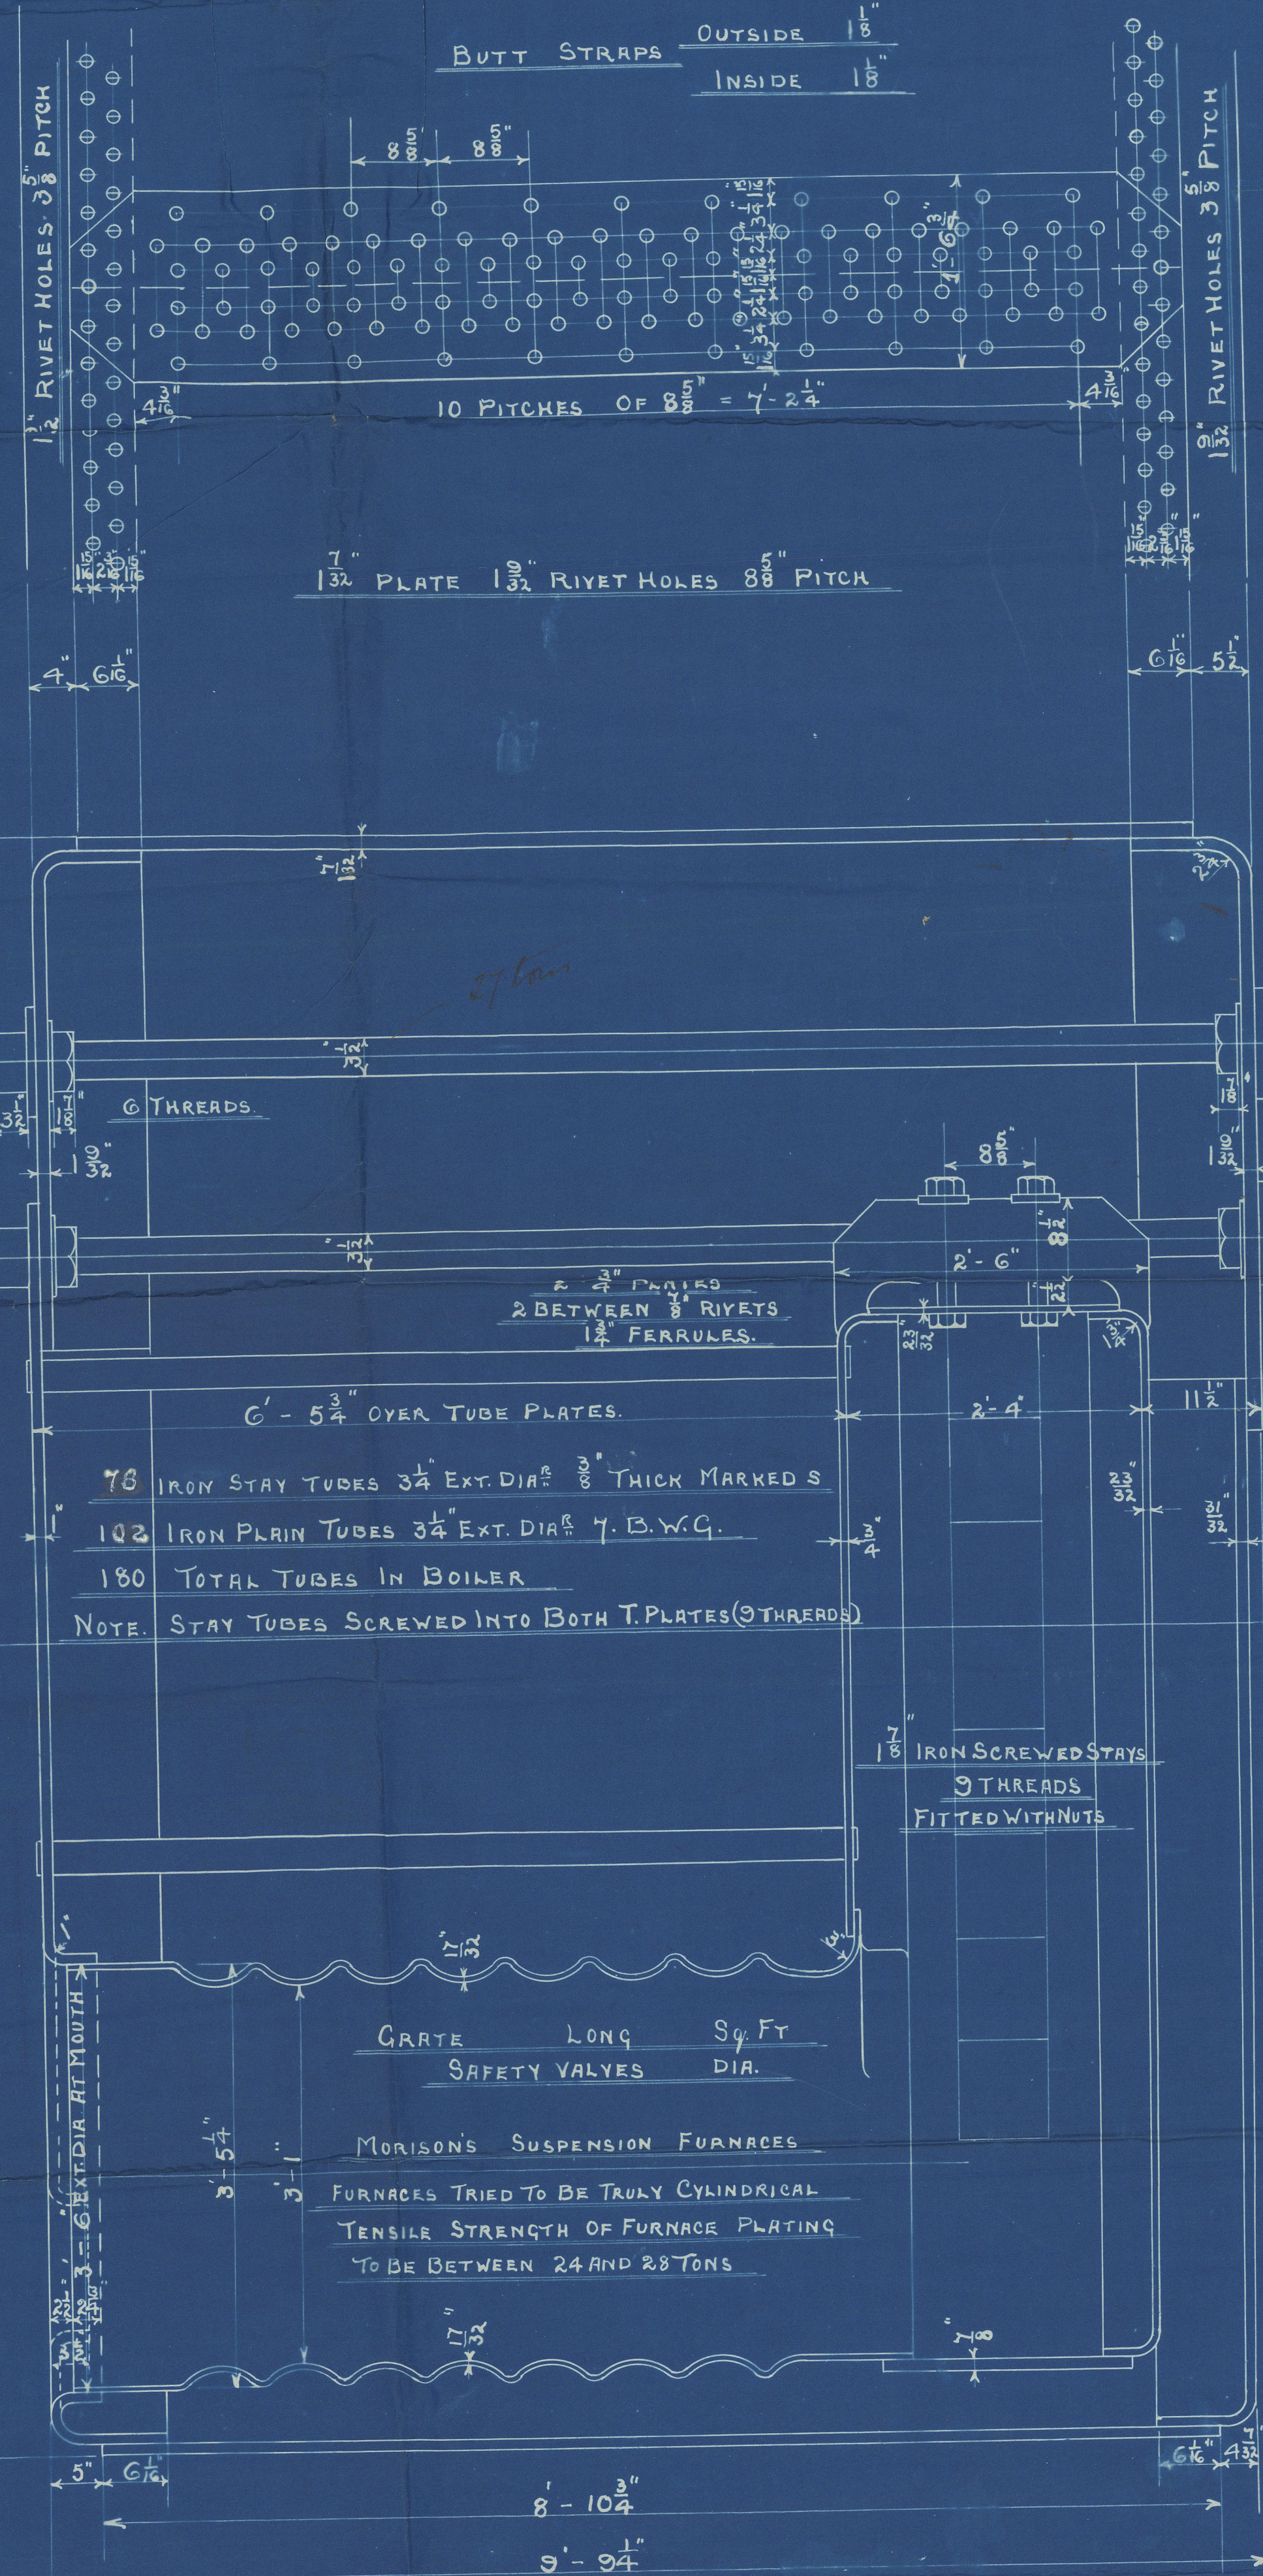


WORKING PRESSURE = 190 LBS.

TEST PRESSURE = 380 LBS.

NOTE. ALL PLATES STAYS &c TO BE OF STEEL EXCEPT WHERE OTHERWISE SHEWN.

TENSILE STRENGTH OF SHELL PLATING TO BE NOT LESS THAN 28 1/2 TONS PER SQ. IN.

ALL HOLES DRILLED IN PLACE AFTER PLATES ARE BENT.

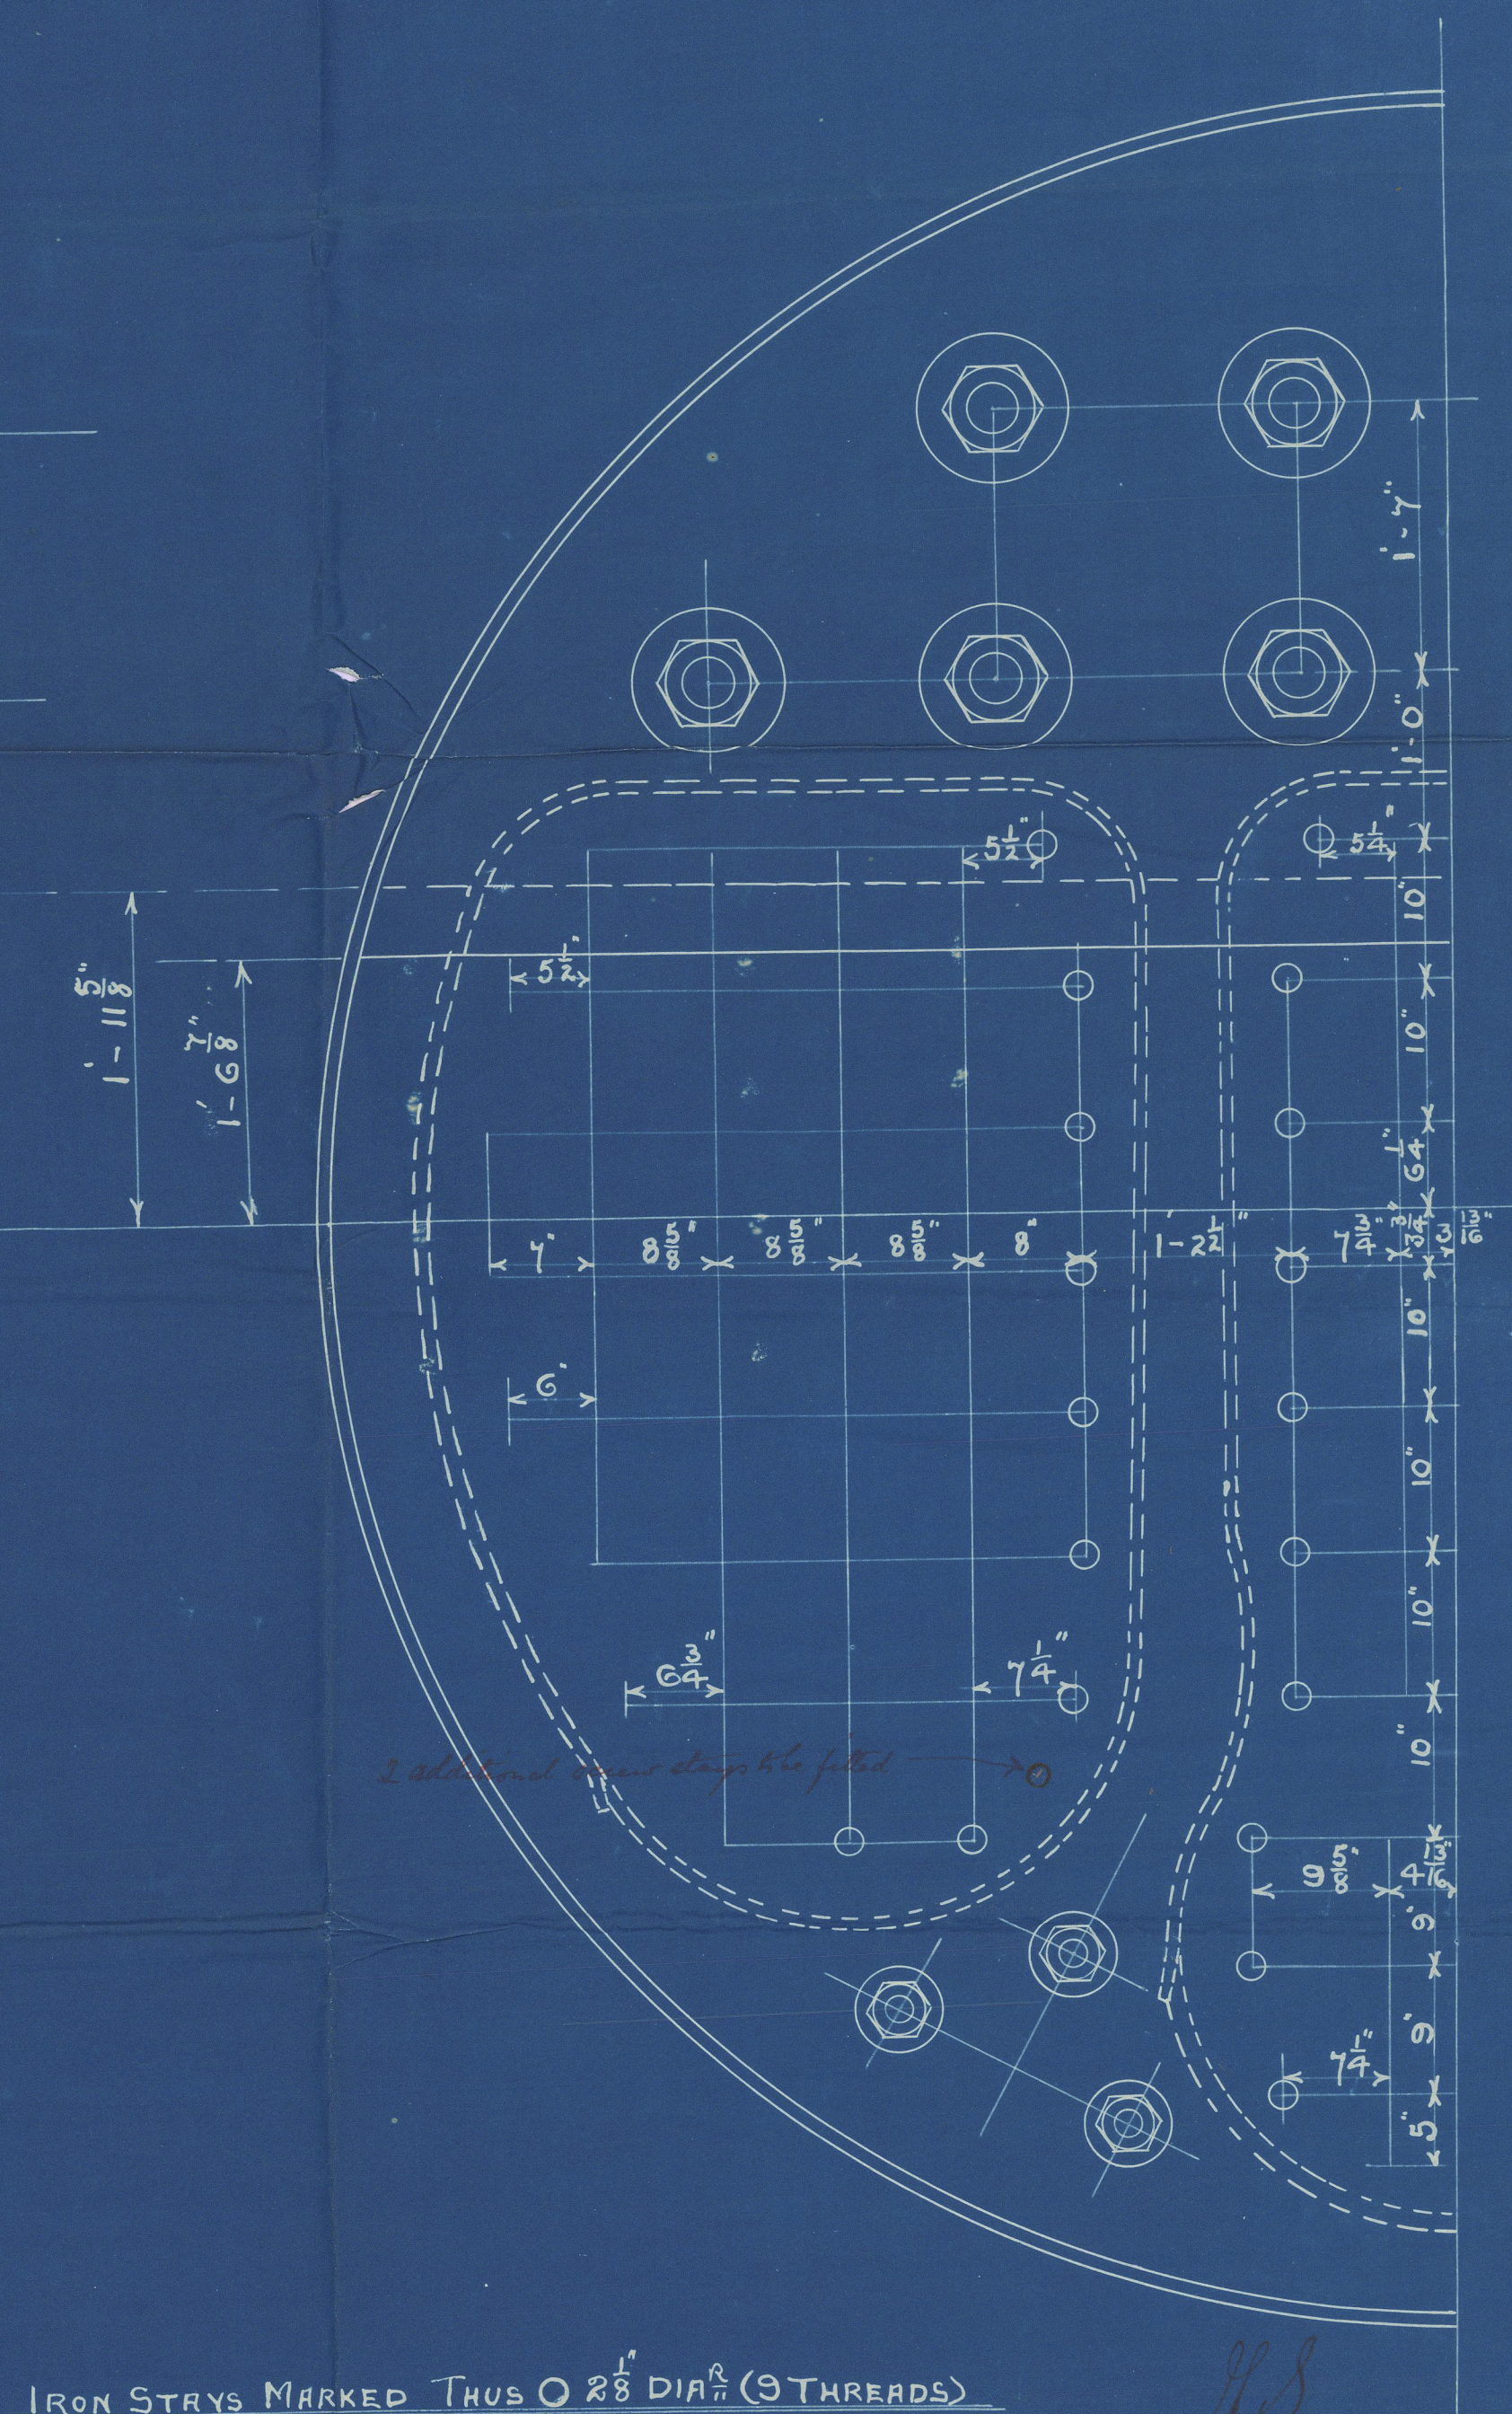

Auxiliary
Boiler

Swan Hunter & Co.
804.

H. & M. Engle & Co.

1905



Nº 7709
LLOYD'S TEST
380 LBS
J. R.
5/5/08.

55400
Newcastle
England
S.S.

RESEARCH

Lloyd's Register
Foundation
W906-0012/2

SOLANITE BRAND, REGD
ALLOTT, JONES & CO., LIVERPOOL. Makers.



© 2021

Lloyd's Register
Foundation

N. E. M. E. CO., LIMITED, WALLSEND.

ENCLOSURE

FOR

Messrs.

W906-0012²/₂