

14. 1.08
26. 11.0
26. 10.07
24. 10.07

MIDSHIP SECTION
S.S. NO 807

SCALE $\frac{1}{2}$ = ONE FOOT

LLOYDS DIMENSIONS 396.88 x 50.8 x 22.56. MAIN 30.5" To UPPER DECK. (11" Below UPPER DECK)

TO CLASS 100.A.1. ³⁰ ~~SPAR~~ SHELTER DECK LLOYDS

EQUIPMENT N^o

EQUIPMENT N° TO SPARD ⁰	42894
<u>ADDITION FOR SALTER D⁰</u>	<u>4744</u>
<u>HOUSES</u>	<u>492</u>
	48130

3 BOWER ANCHORS	STOCKLESS.	60 ^{<u>3</u>} CWT. EACH
1 STREAM ANCHOR	EX STOCK	17 ^{<u>1</u>} "
1 KEOSE	" "	7 ^{<u>1</u>} 2 "
2 TO FATHONS	2 ^{<u>1</u>} / ₂ "	STEEL CHAIN CABLE
90	4 ^{<u>1</u>} / ₂ "	STEEL WIRE STREAM
120	5 ^{<u>1</u>} / ₂ "	TOWLINE
2 OF 90	2 ^{<u>3</u>} / ₄ "	HAWSER
2 OF 90	2 ^{<u>1</u>} / ₂ "	WARP

13: 9: 07
18: 9: 07
NUMERALS 1350000
1840 1200
1/2 GIRTH
1/2 BREADTH
DEPTH
23 44
22 36
42.24 1/2" N° = 10 1/2" N° 3 1/2" N°
396 58.

PROPORTIONS.

BREADTHS	7.8
DEPTHS TO SPARK PL.	12.99

THREE D.K. NUMERALS

1/2 Girth	51.94
1/2 Breadth	25.40
DEPTH	30.52

$$\begin{array}{r} 107.86 \\ 7.00 \\ \hline 100.86 \quad 1^{st} \text{ No} \\ 396.56 \\ \hline 39997 \quad 2^{nd} \end{array}$$

Plating No. 3 dk. Rule
to be under 40,000

Blains about 2 rows
cavities 9. + B.
size

✓
4 DJR increased according
to length
4-0 APART REELED

TANK TOP CENTRE $4\frac{1}{2} \times 20$, 15 $\frac{1}{20}$ IN B. SPACE + 20 IN E. SPACE
" PLATING $4\frac{1}{2} \times 20$, 15 $\frac{1}{20}$ IN E + B. SPACE

CEILING 2 1/2 UNDER HATCHES & OVER BILGES IN DEEP TANK
ALL OVER TANK TOP IN HOLDS ELSEWHERE



40
MARGIN PLATE $\frac{10}{120}$ } DOUBLE RIN OVERLAP BUTT
 $\frac{120}{120}$ IN E & B. SPACE } ALL FORD & RT
PLATE Gussets eddy 4th FRAME
OR ANGLE GUSSETS
FLANGED

16 - $\frac{7}{8}$ rivets in each flange
with handheads & full knobbled points

NO FLANGING EXCEPT
ON TANK KNEES



HUNTER & WIGHAM RICHARDS
SHIPBUILDERS & ENGINEERS
100 SWAN
DATE *Sept. 6th '07*
PLAN NO *15966*
WALLSEND SHIPYARD
WALLSEND-ON-TYNE

 © 2021
Lloyd's Register
Foundation

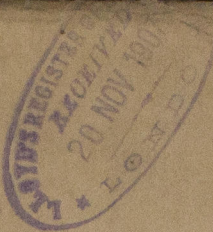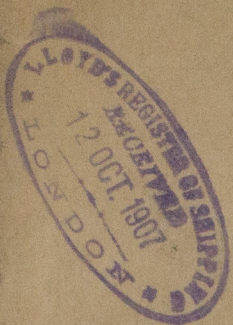

Section

807

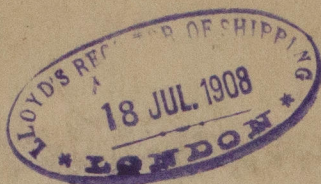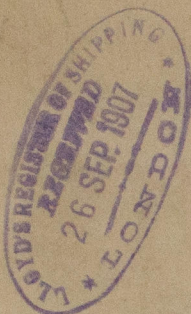

G.I. Engineers

Newcastle Report

No 55700



RETAIN



© 2021

Lloyd's Register
Foundation

W906-0014

807
Section

LLOYD'S REGISTER OF SHIPPING
RECEIVED
26 OCT 1907
LONDON

LLOYD'S REGISTER OF SHIPPING
RECEIVED
21 OCT 1907
LONDON



© 2021

Lloyd's Register
Foundation