


S. S. N^o 438.

NOTE: BRACKETS UNDER WIDE STRINGER WHERE MARKED THUS * TO BE CONNECTED TO BULB ANGLE ON FACE OF STRINGER

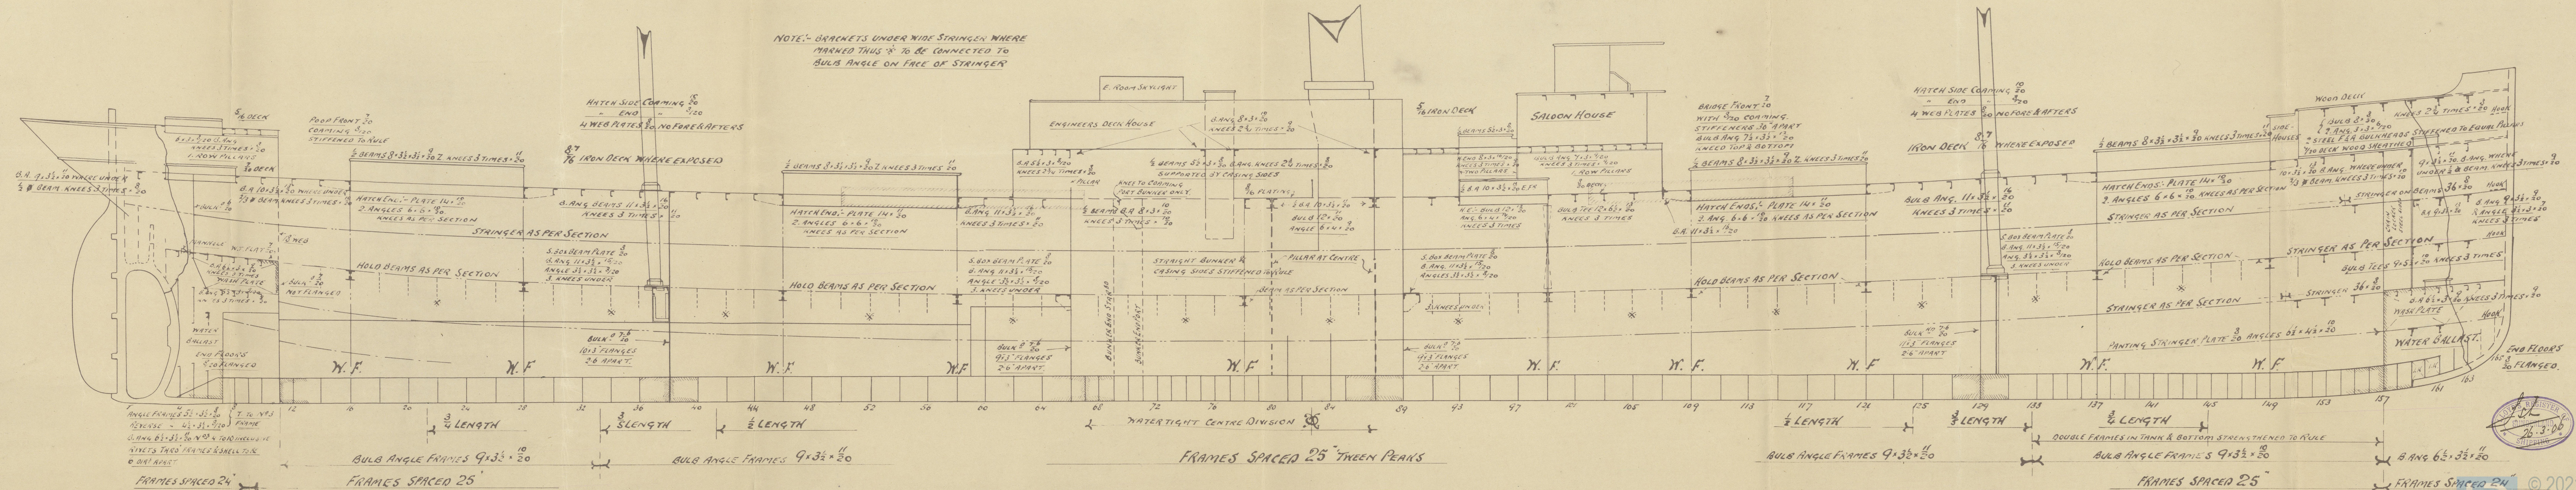

Messrs J.L. THOMPSON & Sons


No. 438

S.S. "FINN"

PROFILE (AS BUILT)

SLA F. E. No 122685

W906-0111

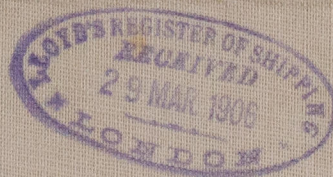

© 2021

Lloyd's Register
Foundation