

THOMAS SUDRON & CO., LIMITED

DRAWING OFFICE

Date *March 11/18*

No. *13*


IMPERIAL BOILER WORKS

STOCKTON-ON-TEES

J. S. S. & Co. f<sup>a</sup>  
1990. v 1991.

For J. J. Thompson & Sons  
9<sup>th</sup> Nov 436 & 438

90 lbs w<sup>r</sup>

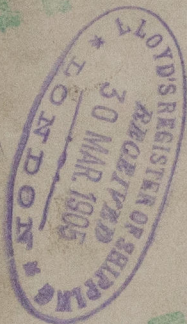

no. 3495  
LLOYD'S TEST.  
180 lbs.  
CXm  
2-8-05


1990

Finis  
led 2/6/83

no. 3604  
LLOYD'S TEST.  
180 lbs.  
CXm  
14-2-06

1991

note report no. 4448

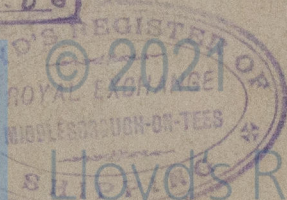

Lloyd's Register  
Foundation



100 x 87 9  
90



© 2021

Lloyd's Register  
Foundation