

Misson Riley Bros Lim^y

Boiler No. ⁴⁹⁶⁴~~4968~~

for


Misson Craig Taylor & Co Lim^y

¹⁸³
~~5-8-184~~

Working Press 120 lbs.

Skull of 4964 amended 8.11.16

(Boiler 4968 amended see
amended plan - WM - 22.12.16)

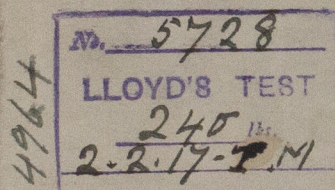

34 plates

Middlesbrough Report

no 9619

S/S. "up"
Fiscus

Grab 9745

Duplicate of Boiler No. 4808

RETAIN

W907-0082



© 2020

Lloyd's Register
Foundation